

1


OVERALL GROUND LEVEL PLAN - ELECTRICAL

1" = 40'-0"

PROJECT TITLE:  
**SONIC IRRIGATION  
REPLACEMENTS**  
FOR THE  
**ARROWHEAD REGIONAL MEDICAL CENTER**  
400 N. PEPPER AVE., COLTON, CA. 92324  
WBSE #: 10.10.1066  
CIP #: 21-065  
CAF# #: COL003



IMEG CORP. RESERVES PROPRIETARY RIGHTS, INCLUDING COPYRIGHTS, TO THIS DRAWING AND THE DATA SHOWN THEREON. NO PART OF THIS DRAWING OR DATA ARE TO BE REPRODUCED OR TRANSMITTED IN ANY FORM OR BY ANY MEANS, ELECTRONIC OR MECHANICAL, INCLUDING PHOTOCOPYING, RECORDING, OR BY ANY INFORMATION STORAGE AND RETRIEVAL SYSTEM, WITHOUT THE EXPRESS WRITTEN APPROVAL AND PARTICIPATION OF IMEG CORP.

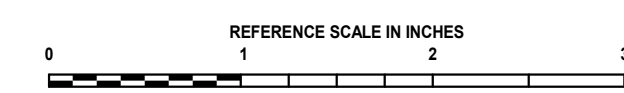

PROFESSIONAL SEAL:



ARCHITECT:




Project No. 3021028.00

DAVID WILLIAM CLARKE C-21219

PROFESSIONAL SEAL:



KEY PLAN:

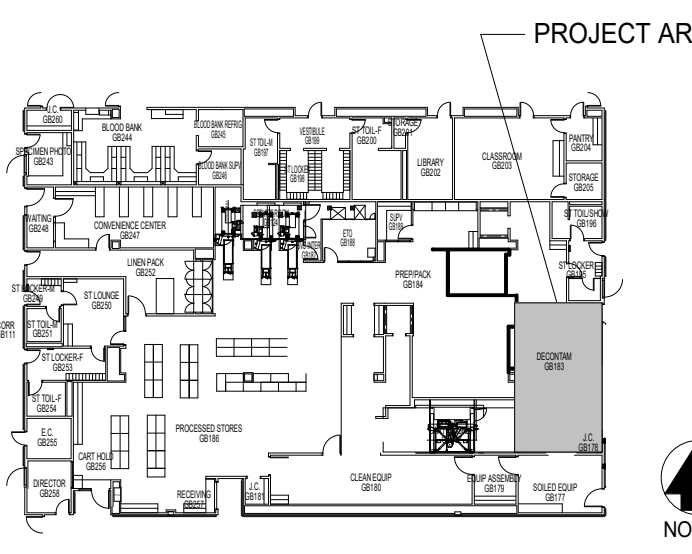

Department of Health Care Access and Information

HCAI # S222316-36-00




No.	Date	Revision / Issue	REVISIONS

SHEET INFORMATION	
Issue	100% CONSTRUCTION DOCUMENTS
Date	12/28/2022
Job Number	21007618.00
Drawn	Author
Checked	Checker
Approved	


SHEET TITLE  
**OVERALL GROUND LEVEL  
PLAN - ELECTRICAL**

SHEET NUMBER  
**E1.0**



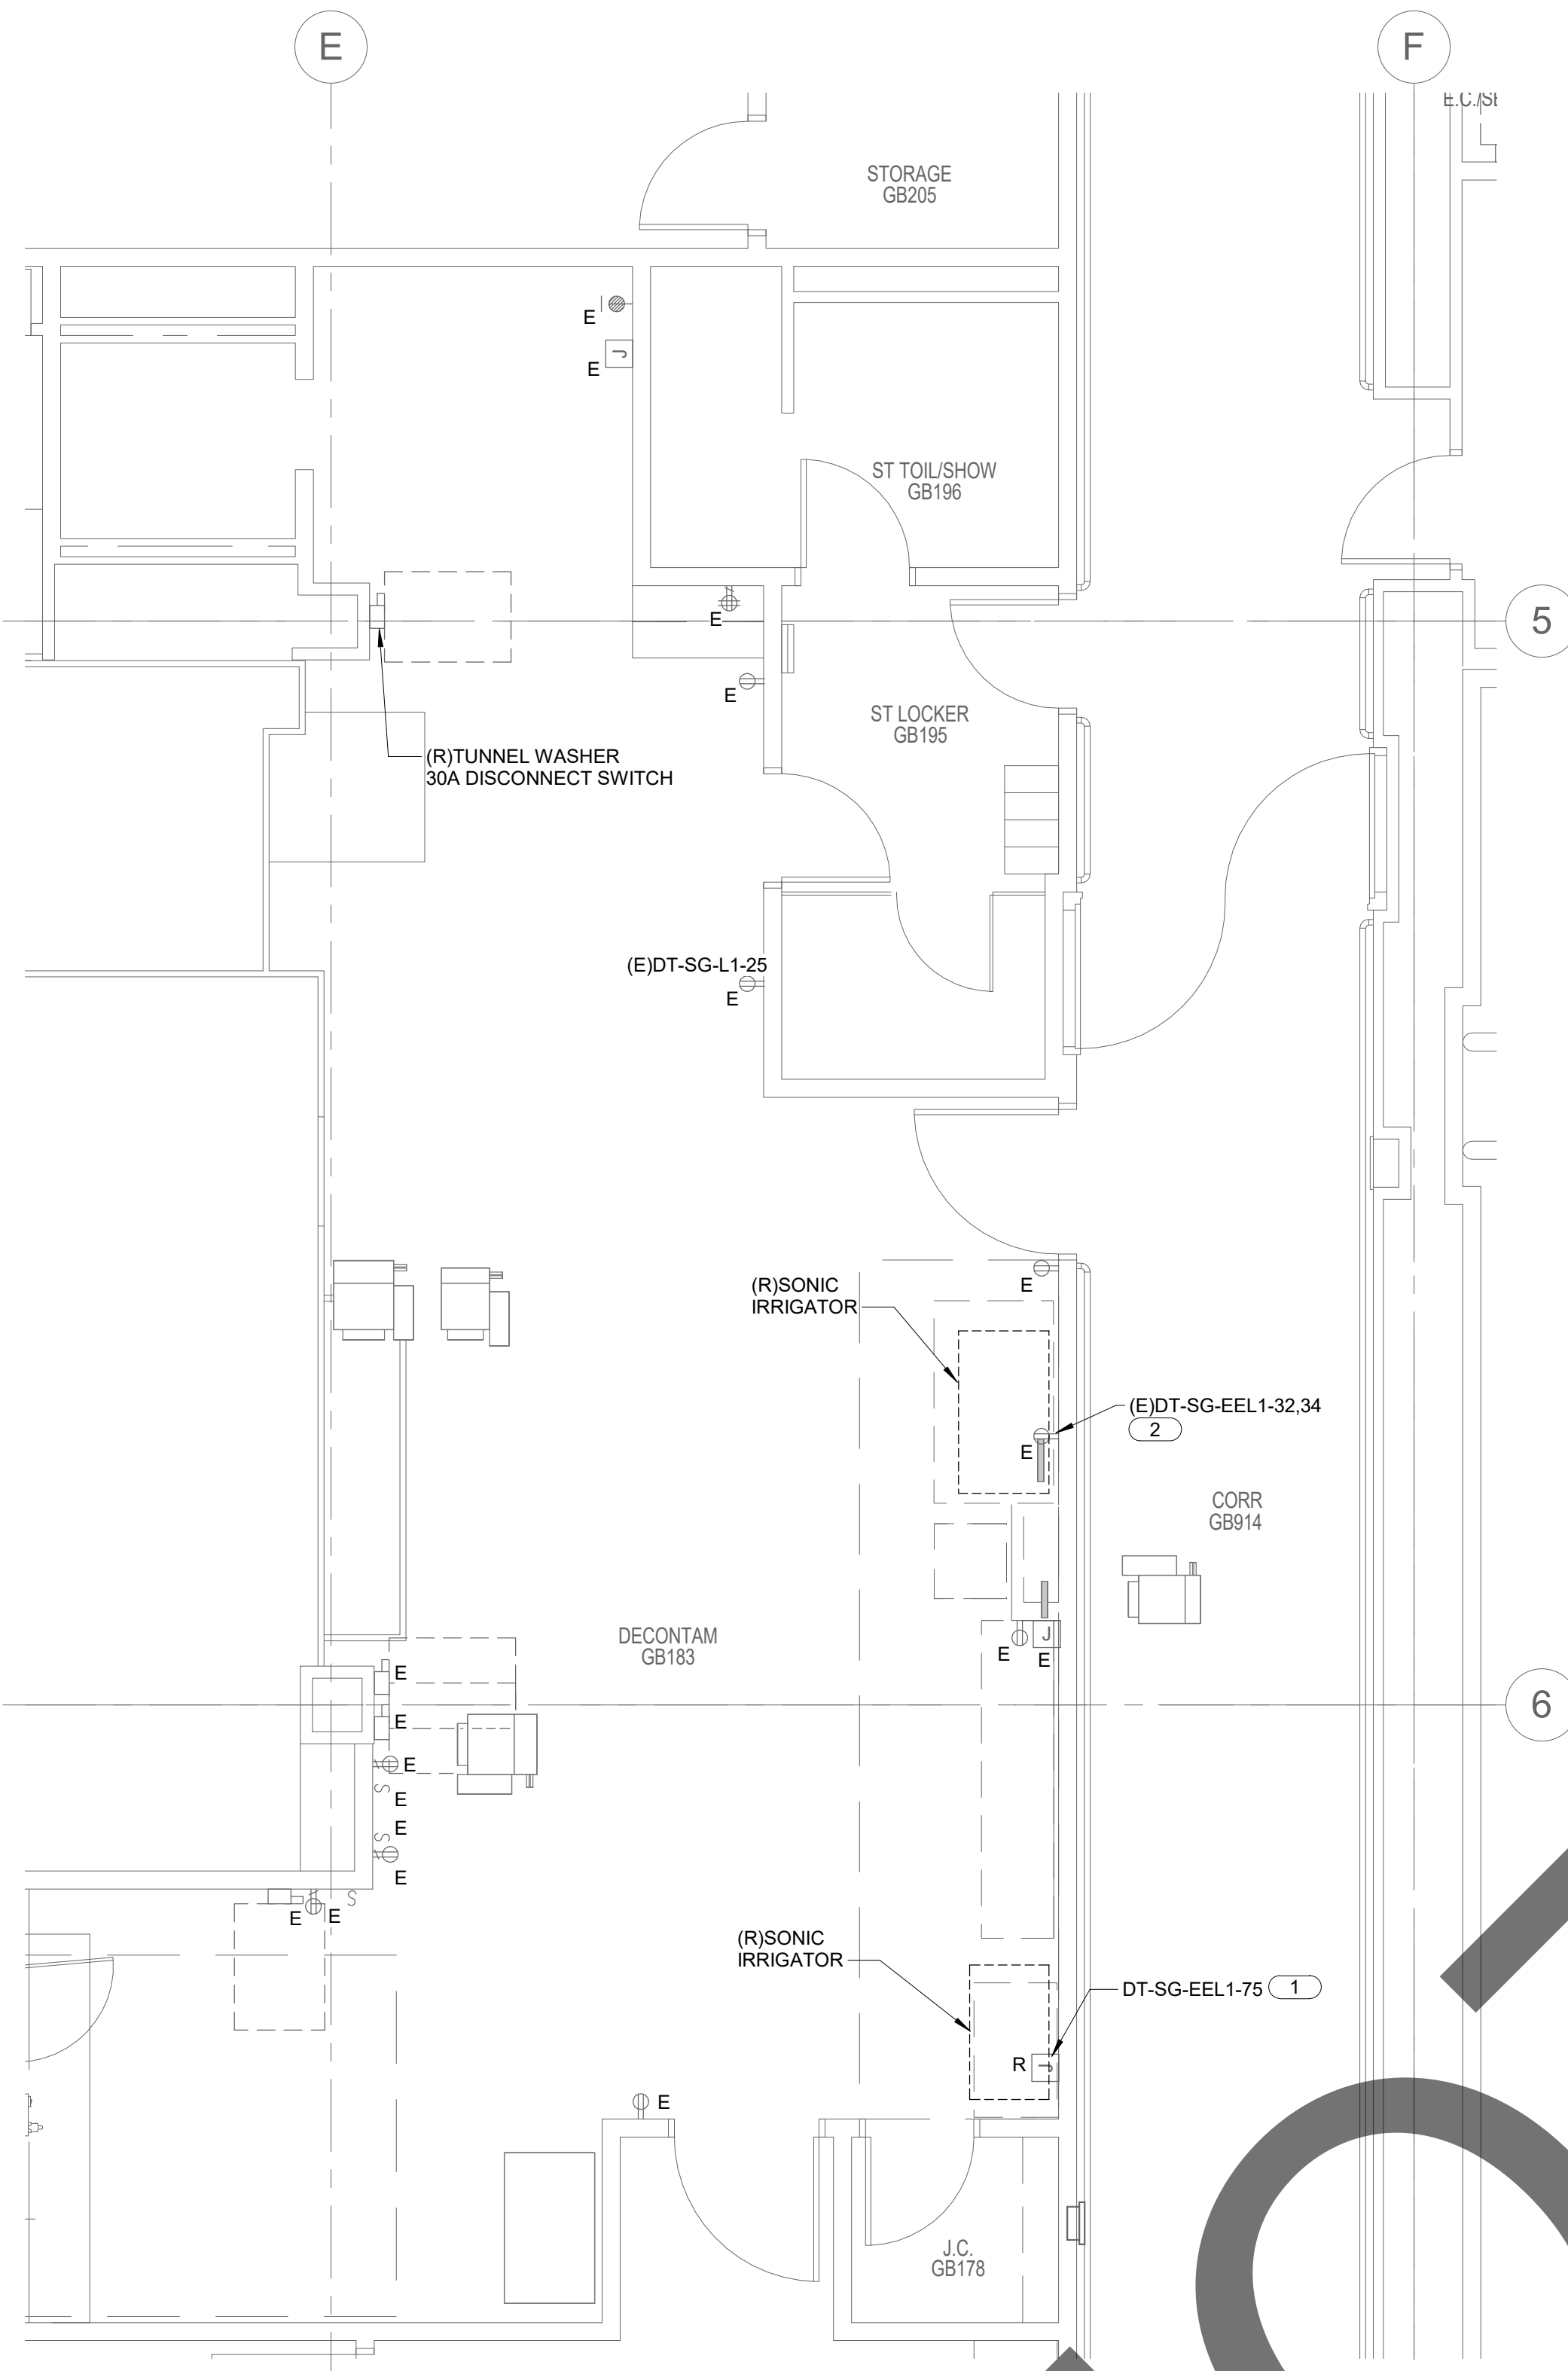

**1 GROUND LEVEL DEMOLITION PLAN - ELECTRICAL**  
1/4" = 1'-0"

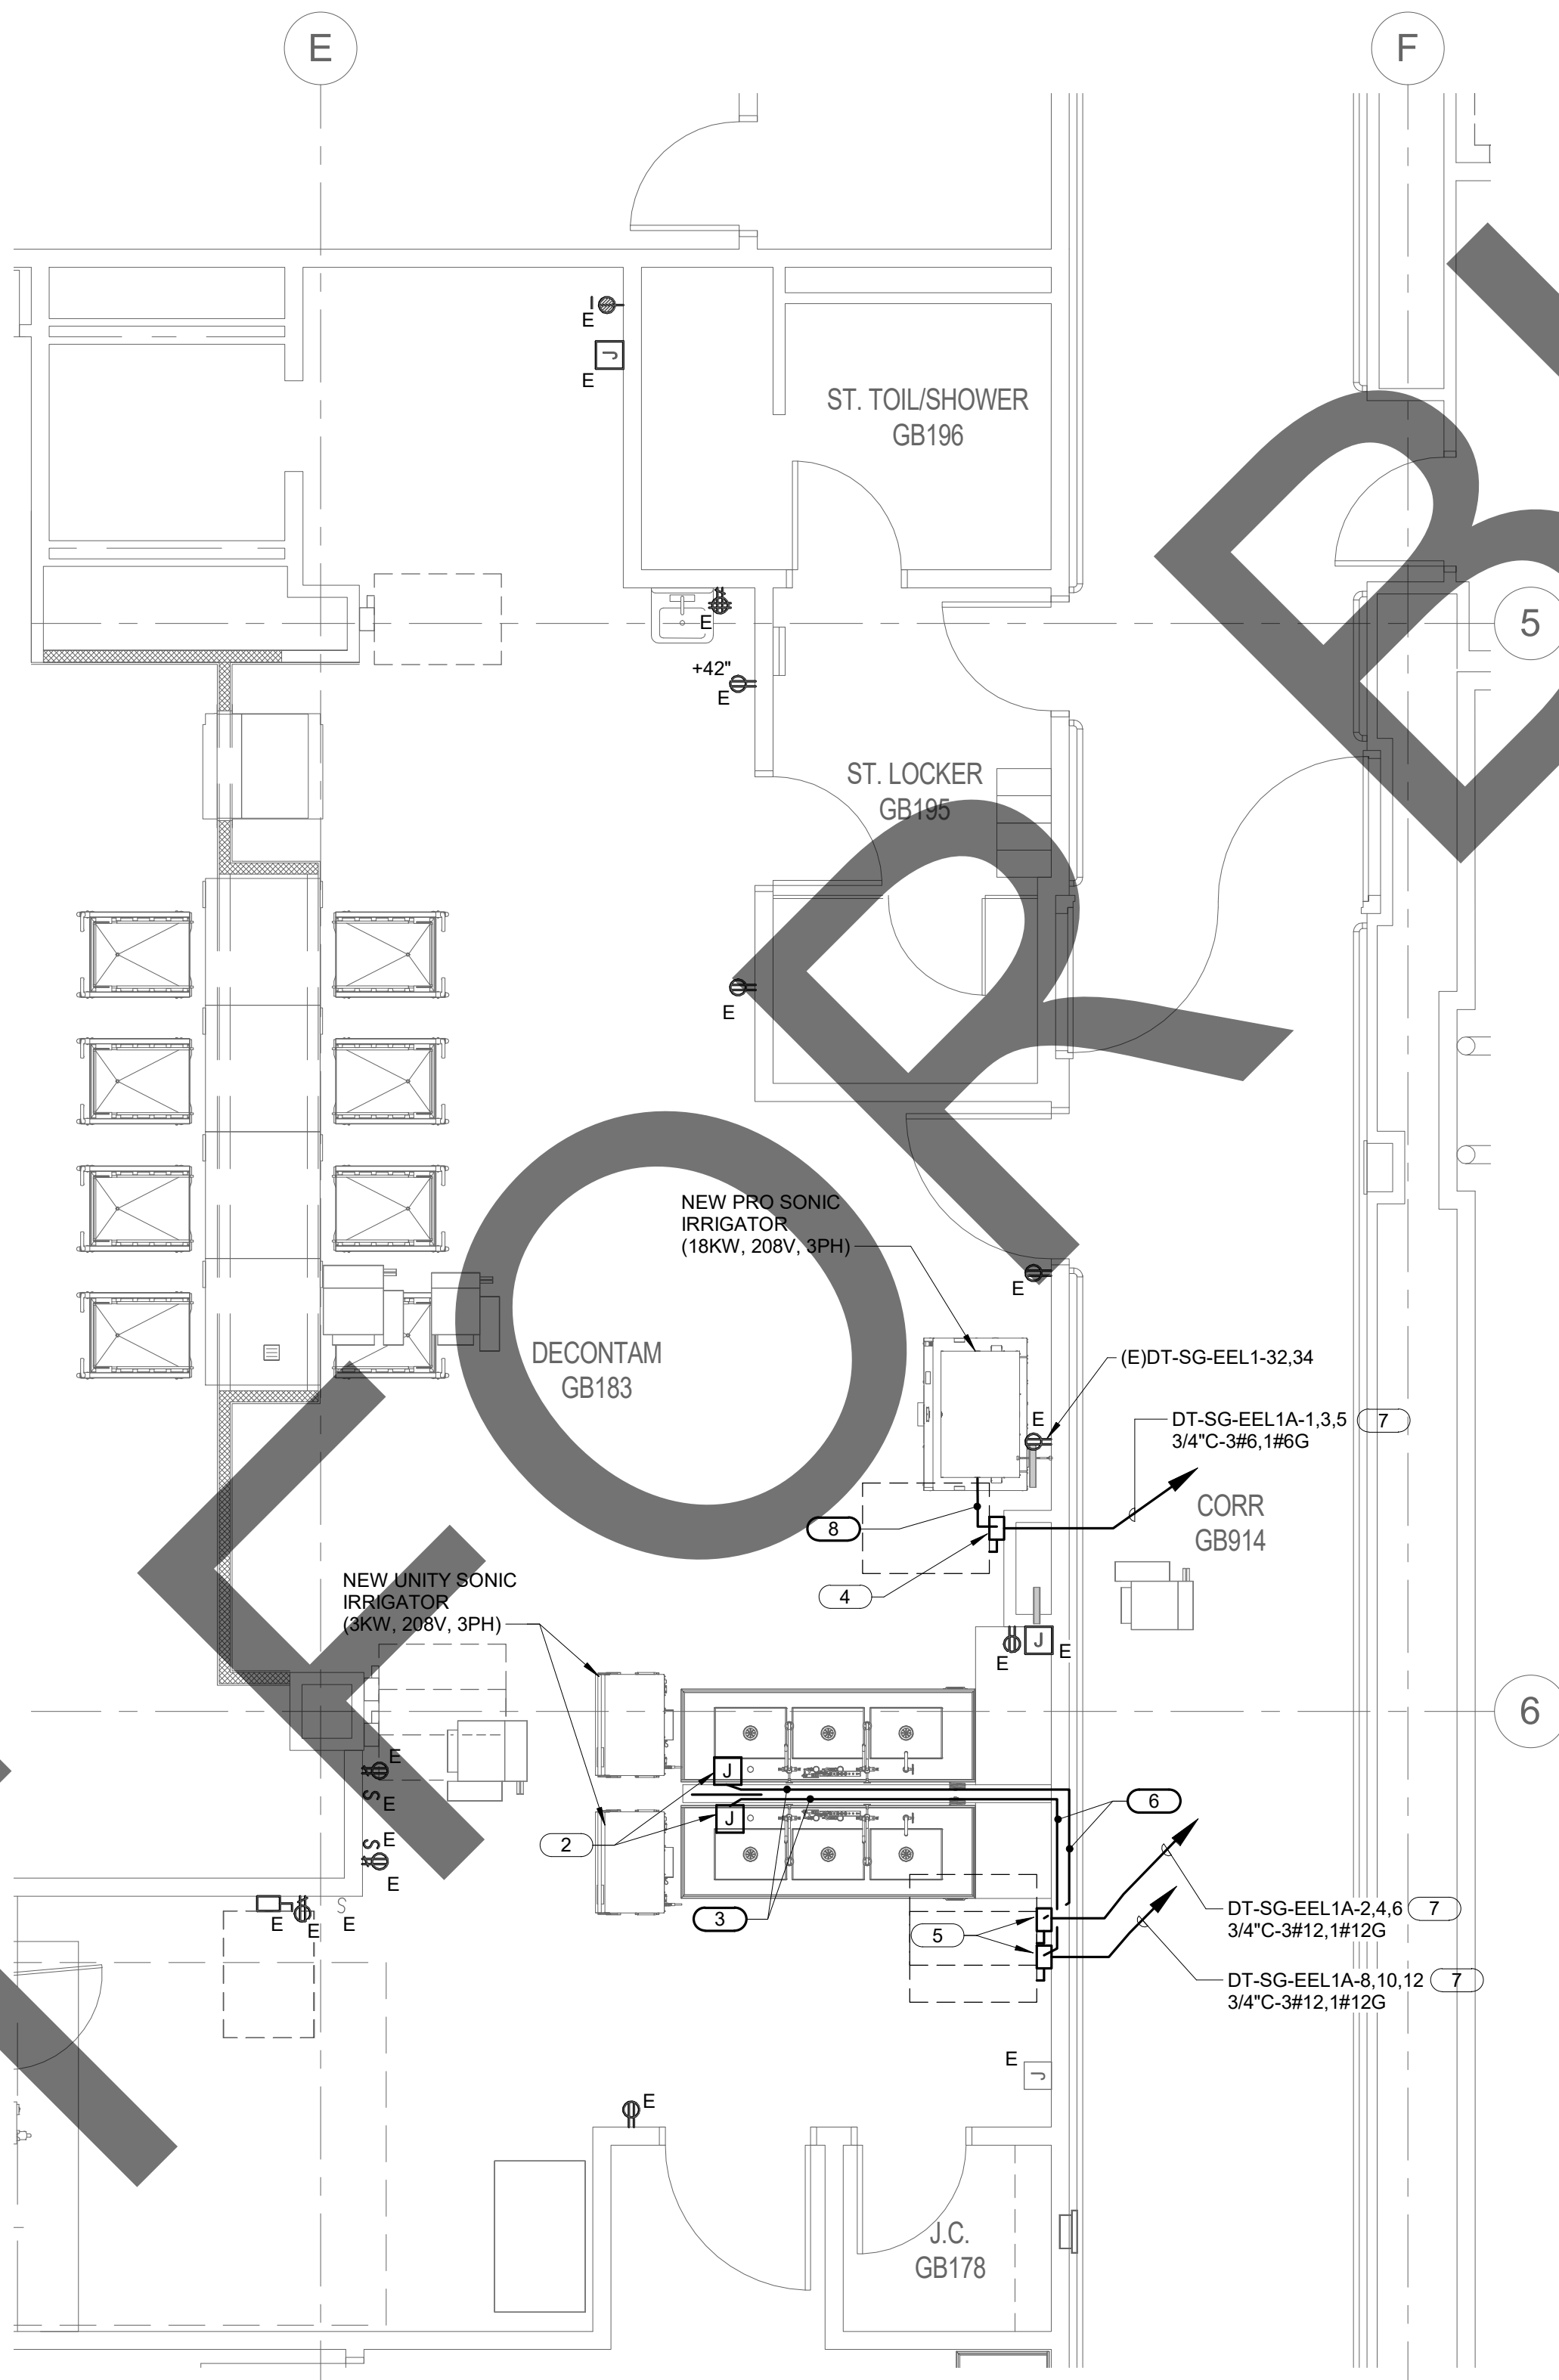

**2 GROUND LEVEL REMODEL PLAN - ELECTRICAL**  
1/4" = 1'-0"





**DEMOLITION KEY NOTES:**

- EXISTING IRRIGATOR CIRCUIT TO BE REMOVED. EXISTING CONDUIT AND WIRES TO BE REMOVED BACK TO SOURCE PANEL. FIELD VERIFY EXISTING CONDITIONS AND EXACT LOCATION.
- EXISTING IRRIGATOR CIRCUIT RECEPTACLE TO REMAIN AND REUSED . FIELD VERIFY EXACT LOCATION.

**REMODEL KEY NOTES:**

- EXISTING CIRCUIT TO REMAIN AND SOURCE CIRCUIT BREAKER LABELED AS SPARE.
- MOUNT JUNCTION BOX NEAR EDGE OF LOW WALL. PROVIDE SEAL TITE FLEX CONDUIT FROM JUNCTION BOX TO SONIC IRRIGATOR CONTROL PANEL POWER CONNECTION POINT. COORDINATE WITH SONIC IRRIGATOR INSTALLER FOR CONNECTION DETAILS. FIELD VERIFY EXACT LOCATION.
- ROUTE CONDUIT RECESSED IN WALL. CLEAR OF SINK APPLIANCES AND PLUMBING PIPES FROM JUNCTION BOX TO DISCONNECT SWITCH ON WALL. FEILD VERIFY EXACT LOCATION.
- 60AS/60AF, 3P WALL MOUNTED.
- 30AS/15AF, 3P WALL MOUNTED.
- ROUTE CONDUIT RECESSED IN WALL. FIELD VERIFY EXACT ROUTING.
- ROUTE FEEDER CONDUITS TO ELECTRICAL ROOM GB 204A. REFER TO SHEET E1.0 FOR PANEL LOCATION. REFER TO 1/E3.1 FOR CONDUIT THRU WALL PENETRATION DETAIL.
- PROVIDE SEAL TITE FLEX CONDUIT FROM DISCONNECT TO EQUIPMENT. COORDINATE WITH EQUIPMENT INSTALLER FOR CONNECTION DETAILS.

PROJECT TITLE: **SONIC IRRIGATION REPLACEMENTS**  
FOR THE  
**ARROWHEAD REGIONAL MEDICAL CENTER**  
400 N. PEPPER AVE., COLTON, CA. 92324  
WBSE #: 10.10.1066  
CIP #: 21-065  
CAFM #: COL003

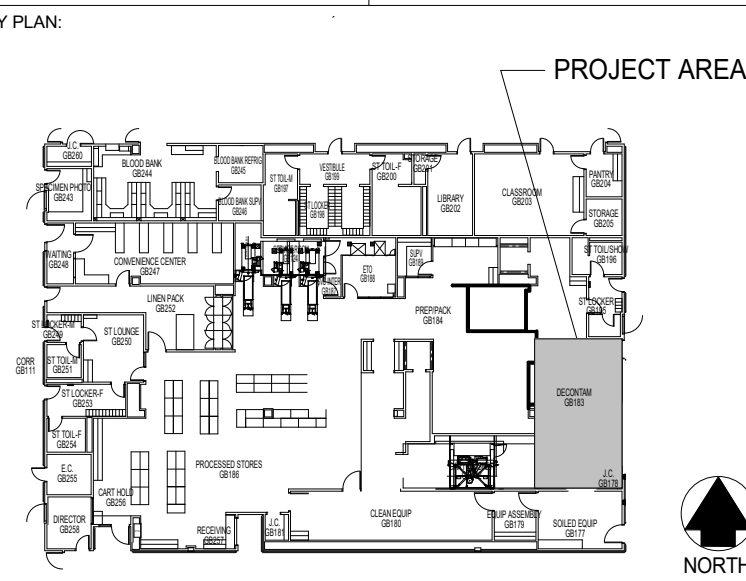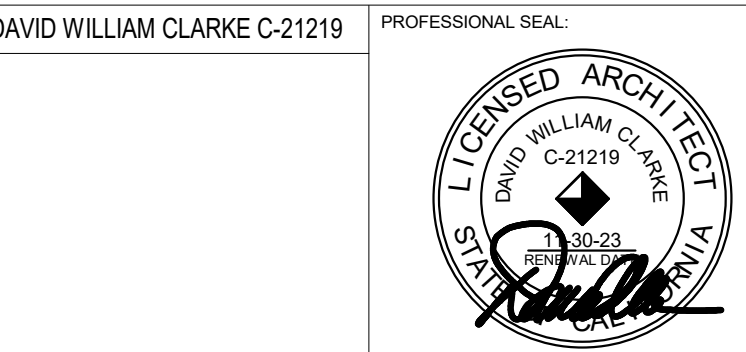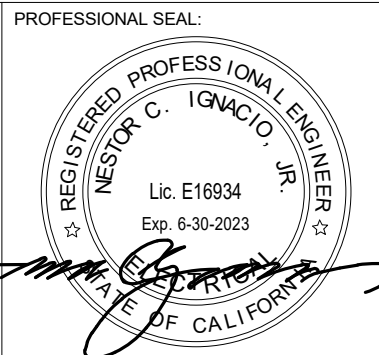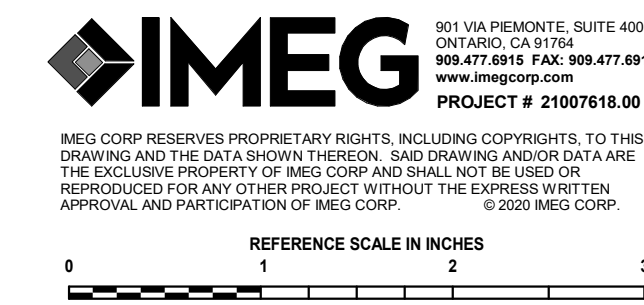

Department of Health Care Access and Information  
**HCAI # S222316-36-00**






No.	Date	Revision / Issue	REVISIONS

SHEET INFORMATION	
Issue	100% CONSTRUCTION DOCUMENTS
Date	12/28/2022
Job Number	21007618.00
Drawn	Author
Checked	Checker
Approved	


**GROUND LEVEL PLAN - ELECTRICAL**

SHEET NUMBER  
**E2.1**

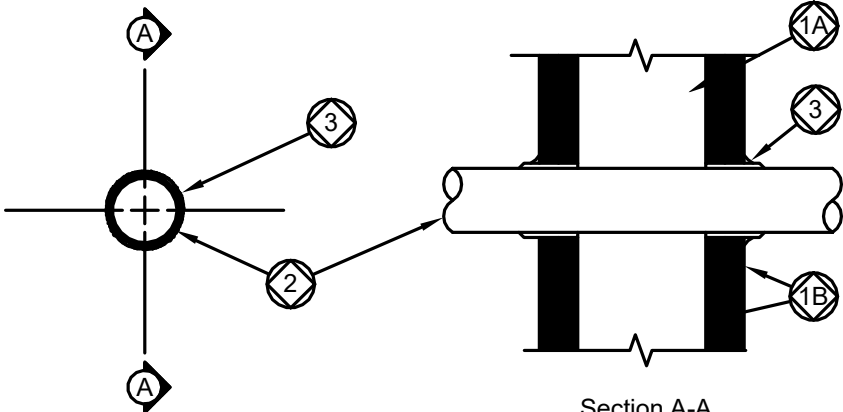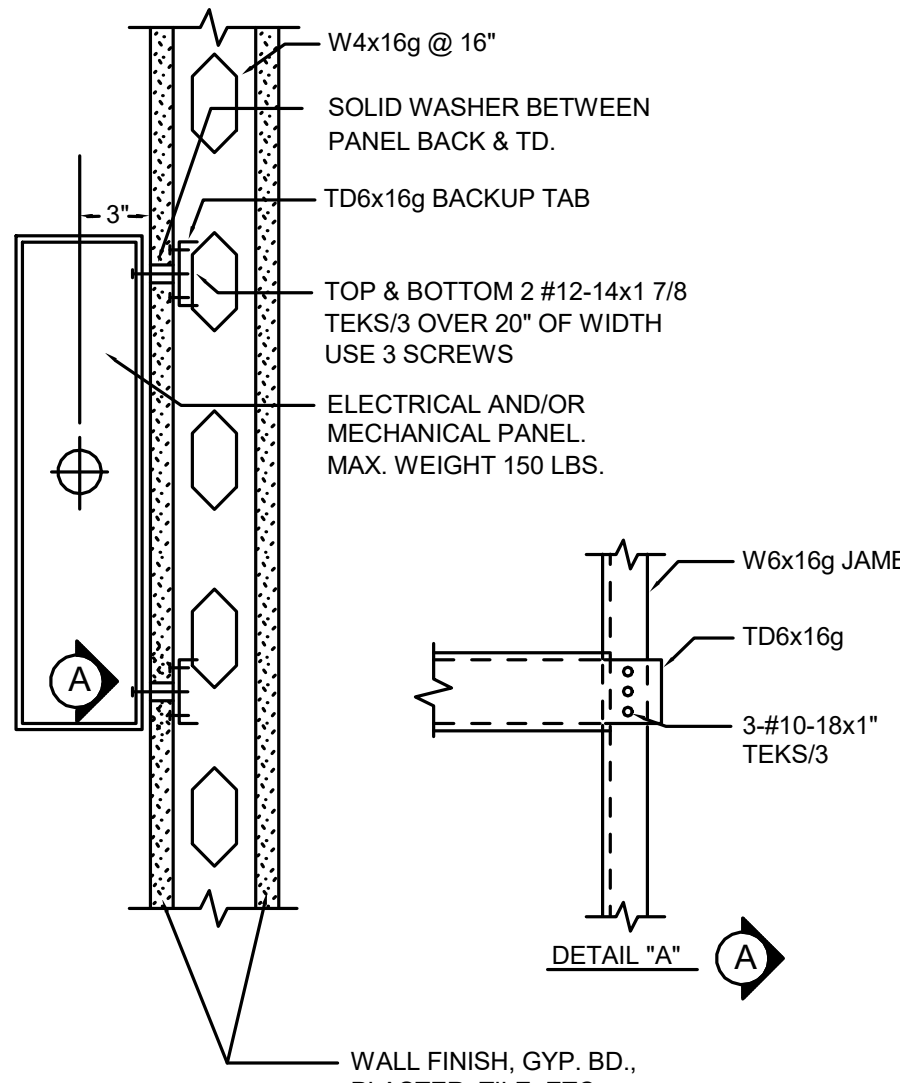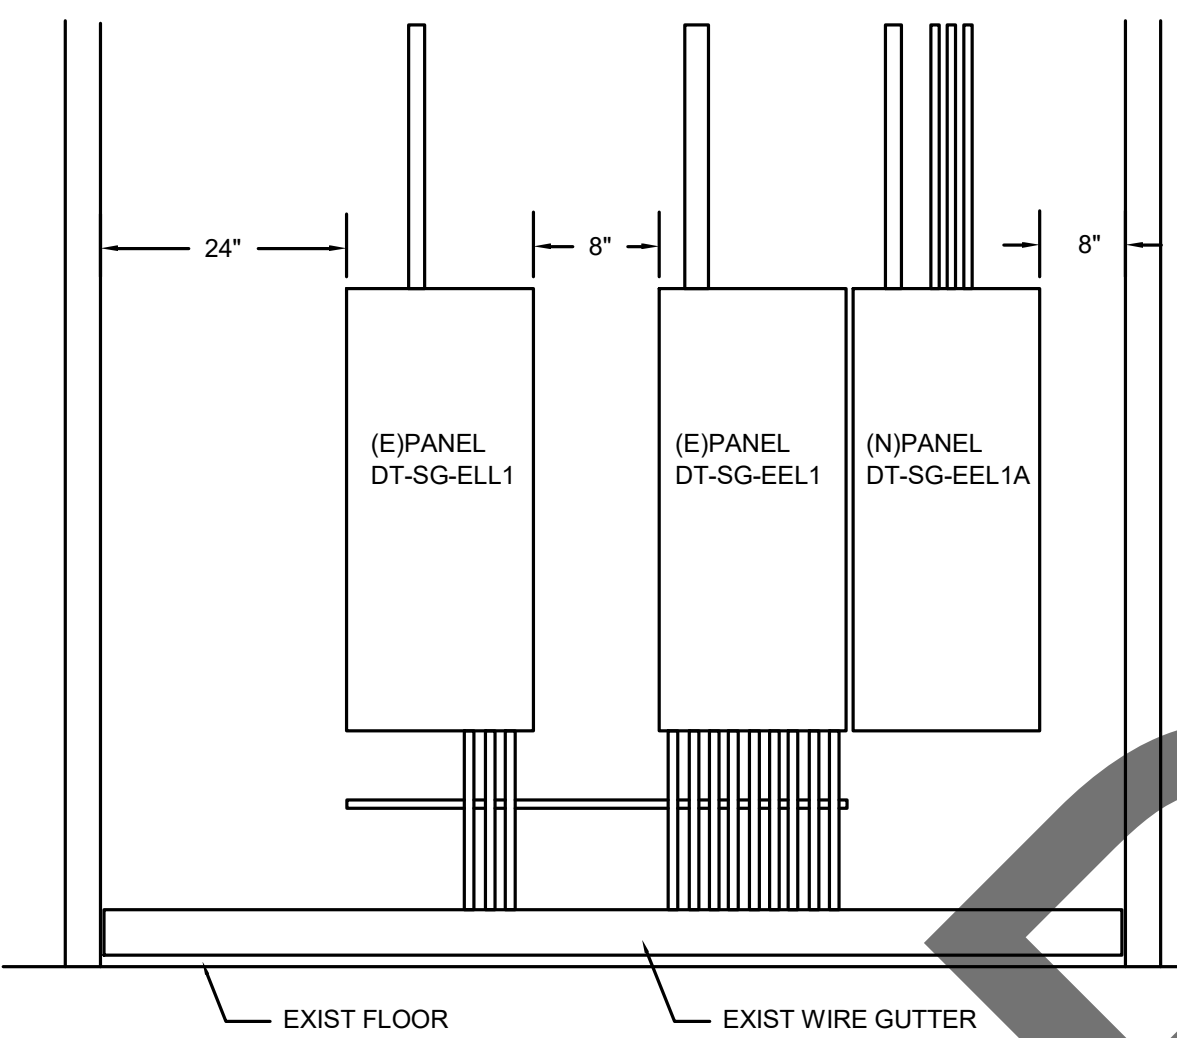

<div>SYSTEM NO. W-L-1001</div> <div>F RATINGS - 1, 2, 3 and 4 HR (SEE ITEMS 2 and 3) T RATINGS - 0, 1, 2, 3 and 4 HR (SEE ITEM 3) L RATING AT AMBIENT - 1 CFM/SQ.FT L RATING AT 400 F - LESS THAN 1 CFM/SQ.FT</div> <div><p>Section A-A</p></div> <div>1. WALL ASSEMBLY - THE 1, 2, 3 OR 4 HR FIRE-RATED GYPSUM WALLBOARD/STUD WALL ASSEMBLY SHALL BE CONSTRUCTED OF THE MATERIALS AND IN THE MANNER DESCRIBED IN THE INDIVIDUAL U300 OR U400 SERIES WALL OR PARTITION DESIGNS IN THE UL FIRE RESISTANCE DIRECTORY DIRECTORY AND SHALL INCLUDE THE FOLLOWING CONSTRUCTION FEATURES:</div> <div>A. STUDS - WALL FRAMING TO CONSIST OF STEEL CHANNEL STUDS, STEEL STUDS TO BE MIN 3-5/8 IN. WIDE BY 1-3/8 IN. DEEP CHANNELS SPACED MAX 24</div> <div>B. GYPSUM BOARD* - NOM 1/2 OR 5/8 IN. THICK, 4 FT. WIDE WITH SQUARE OR TAPERED EDGES. THE GYPSUM WALLBOARD TYPE, THICKNESS, NUMBER OF LAYERS, FASTENER TYPE AND SHEET ORIENTATION SHALL BE AS SPECIFIED IN THE INDIVIDUAL U300 OR U400 SERIES DESIGN IN THE UL FIRE RESISTANCE DIRECTORY. MAX DIAM OF OPENING IS 28 IN.</div> <div>2. THROUGH PENETRANT - ONE METALLIC PIPE, CONDUIT OR TUBING INSTALLED EITHER CONCENTRICALLY OR ECCENTRICALLY WITHIN THE FIRESTOP SYSTEM. THE ANNULAR SPACE BETWEEN PIPE, CONDUIT OR TUBING AND PERIPHERY OF OPENING SHALL BE MIN. OF 0 IN. (POINT CONTACT) TO MAX 2 IN. PIPE, CONDUIT OR TUBING TO BE RIGIDLY SUPPORTED ON BOTH SIDES OF WALL ASSEMBLY. THE FOLLOWING TYPES AND SIZES OF METALLIC PIPES, CONDUIT OR TUBING MAY BE USED:</div> <div>A. NOM 24 IN. DIAM (OR SMALLER) SCHEDULE 10 (OR HEAVIER) STEEL PIPE</div> <div>B. NOM 24 IN. DIAM (OR SMALLER) SERVICE WEIGHT (OR HEAVIER) CAST IRON SOIL PIPE, NOM 12 IN. DIAM (OR SMALLER) CLASS 50 (OR HEAVIER) DUCTILE IRON PRESSURE PIPE</div> <div>C. NOM 6 IN. DIAM (OR SMALLER) STEEL CONDUIT OR NOM 4 IN. DIAM (OR SMALLER) STEEL ELECTRICAL METALLIC TUBING</div> <div>D. NOM 6 IN. DIAM (OR SMALLER) TYPE L OR (OR HEAVIER) COPPER TUBING</div> <div>FILED IN ROOM OR OTHER REAL ROOMS FOR HEAVIER COPPER PIPE-7/8 AND 2-1/2 IN. THICKNESS OF CAULK FOR 1, 2, 3 AND 4 HR RATED ASSEMBLIES, RESPECTIVELY, APPLIED WITHIN ANNULUS, FLUSH WITH BOTH SURFACES OF WALL. MIN 1/4 IN. DIAM. BEAD OF CAULK APPLIED TO GYPSUM BOARD/PENETRANT INTERFACE AT POINT CONTACT LOCATION ON BOTH SIDES OF WALL. THE HOURLY F RATING OF THE FIRESTOP SYSTEM IS DEPENDENT UPON THE HOURLY FIRE RATING OF THE WALL ASSEMBLY IN WHICH IT IS INSTALLED, AS SHOWN IN THE FOLLOWING TABLE. THE HOURLY T RATING OF THE FIRESTOP SYSTEM IS DEPENDENT UPON THE TYPE OR SIZE OF THE PIPE OR CONDUIT AND THE HOURLY FIRE RATING OF THE WALL ASSEMBLY IN WHICH IT IS INSTALLED AS TABULATED BELOW:</div> <div><table><tr><th>MAX PIPE OR CONDUIT DIAM. IN</th><th>F RATING HR</th><th>T RATING, HR</th></tr><tr><td>1</td><td>1 OR 2</td><td>0**, 1 OR 2</td></tr><tr><td>1</td><td>3 OR 4</td><td>3 OR 4</td></tr><tr><td>4</td><td>1 OR 2</td><td>0</td></tr><tr><td>6</td><td>3 OR 4</td><td>0</td></tr><tr><td>12</td><td>1 OR 2</td><td>0</td></tr></table></div> <div>**WHEN COPPER PIPE IS USED, T RATING IS 0 H.</div> <div>3M COMPANY - CP 25WB+ OR FB-3000 WT</div> <div>*BEARING THE UL CLASSIFICATION MARKING</div>			MAX PIPE OR CONDUIT DIAM. IN	F RATING HR	T RATING, HR	1	1 OR 2	0**, 1 OR 2	1	3 OR 4	3 OR 4	4	1 OR 2	0	6	3 OR 4	0	12	1 OR 2	0	<div><p>W4x16g @ 16"</p><p>SOLID WASHER BETWEEN PANEL BACK &amp; TD.</p><p>TD6x16g BACKUP TAB</p><p>TOP &amp; BOTTOM 2 #12-14x1 7/8 TEKS/3 OVER 20" OF WIDTH USE 3 SCREWS</p><p>ELECTRICAL AND/OR MECHANICAL PANEL. MAX. WEIGHT 150 LBS.</p><p>W6x16g JAMB</p><p>TD6x16g</p><p>3-#10-18x1" TEKS/3</p><p>DETAIL "A"</p><p>WALL FINISH, GYP. BD., PLASTER, TILE, ETC.</p></div>			<div><p>(E)PANEL DT-SG-ELL1</p><p>(E)PANEL DT-SG-EEL1</p><p>(N)PANEL DT-SG-EEL1A</p><p>24"</p><p>8"</p><p>8"</p><p>EXIST FLOOR</p><p>EXIST WIRE GUTTER</p></div>					
MAX PIPE OR CONDUIT DIAM. IN	F RATING HR	T RATING, HR																											
1	1 OR 2	0**, 1 OR 2																											
1	3 OR 4	3 OR 4																											
4	1 OR 2	0																											
6	3 OR 4	0																											
12	1 OR 2	0																											
SURFACE MOUNTED PANEL/CABINET STEEL FRAMING			NTS	2	PANELBOARD ELEVATION RM GB206A			NTS	3																				
CONDUIT PENETRATION THRU 2-HOUR CONCRETE FLOOR/WALL DETAIL			NTS	1	NOT USED			NTS	6	NOT USED																			
NOT USED			NTS	9	NOT USED			NTS	11	NOT USED																			
NOT USED			NTS	10	NOT USED			NTS	12	NOT USED																			


PROJECT TITLE:  
**SONIC IRRIGATION REPLACEMENTS**  
FOR THE  
**ARROWHEAD REGIONAL MEDICAL CENTER**  
400 N. PEPPER AVE., COLTON, CA. 92324  
WBSE #: 10.10.1066  
CIP #: 21-065  
CAFM #: COL003




901 VIA PIEDMONT, SUITE 400  
ONTARIO, CA 91764  
909.477.4915 FAX: 909.477.6916  
www.imegcorp.com  
PROJECT # 21007618.00

IMEG CORP. RESERVES PROPRIETARY RIGHTS, INCLUDING COPYRIGHTS, TO THIS DRAWING AND THE DATA SHOWN THEREON. THIS DRAWING AND/OR DATA ARE THE EXCLUSIVE PROPERTY OF IMEG CORP. AND SHALL NOT BE REPRODUCED OR REPRODUCED FOR ANY OTHER PROJECT WITHOUT THE EXPRESS WRITTEN APPROVAL AND PARTICIPATION OF IMEG CORP. © 2005 IMEG CORP.


REFERENCE SCALE IN INCHES  
0 1 2 3

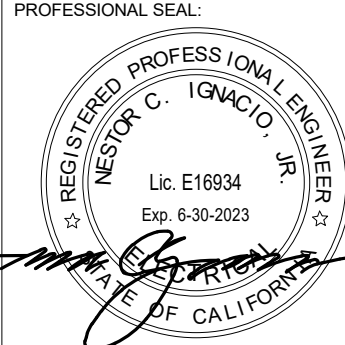
PROFESSIONAL SEAL:  
  
REGISTERED PROFESSIONAL ARCHITECT  
DAVID WILLIAM CLARKE  
Lic. E16934  
Exp. 6-30-2023

ARCHITECT:  



73121 FRED WARING DR. STE. 200  
PALM DESERT, CA 92260  
760-327-6800

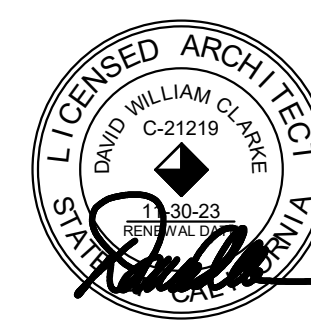Project No. 3021028.00

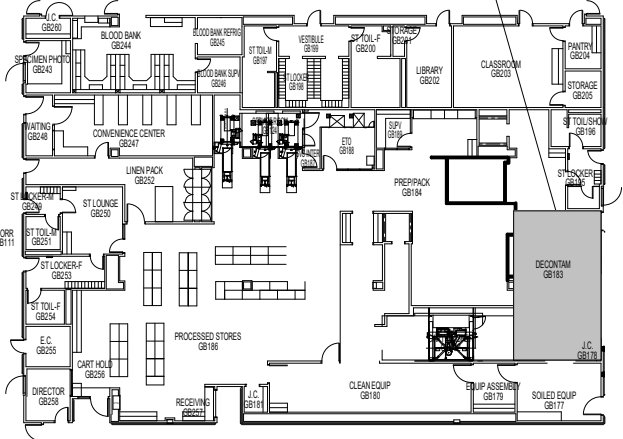DAVID WILLIAM CLARKE C-21219  
PROFESSIONAL SEAL:  
  
REGISTERED PROFESSIONAL ARCHITECT  
DAVID WILLIAM CLARKE  
Lic. C-21219  
Exp. 12-23-2023

KEY PLAN:  
  
PROJECT AREA  
NORTH

Department of Health Care Access and Information  
**HCAI # S222316-36-00**



REVIEWED IN ACCORDANCE WITH THE REQUIREMENTS OF T24, COR  
**APPROVED**  
with comments  
Department of Health Care Access & Information  
Office of Statewide Hospital Planning & Development  
5/16/2023, 2:27:57 PM  
S222316-36-00  
Laura Baldrati

No.	Date	Revision / Issue	REVISIONS

SHEET INFORMATION

Issue  
100% CONSTRUCTION DOCUMENTS

Date  
12/28/2022

Job Number  
21007618.00

Drawn  
Author

Checked  
Checker

Approved


SHEET TITLE

DETAILS

SHEET NUMBER  
**E3.1**



S:\Active Projects\County of San Bernardino\Arrowhead Regional Medical Center\3021028\ ARMC - Sonic Irrigators\3021028\ A2.2.dwg May 04, 2023 - 2:15pm

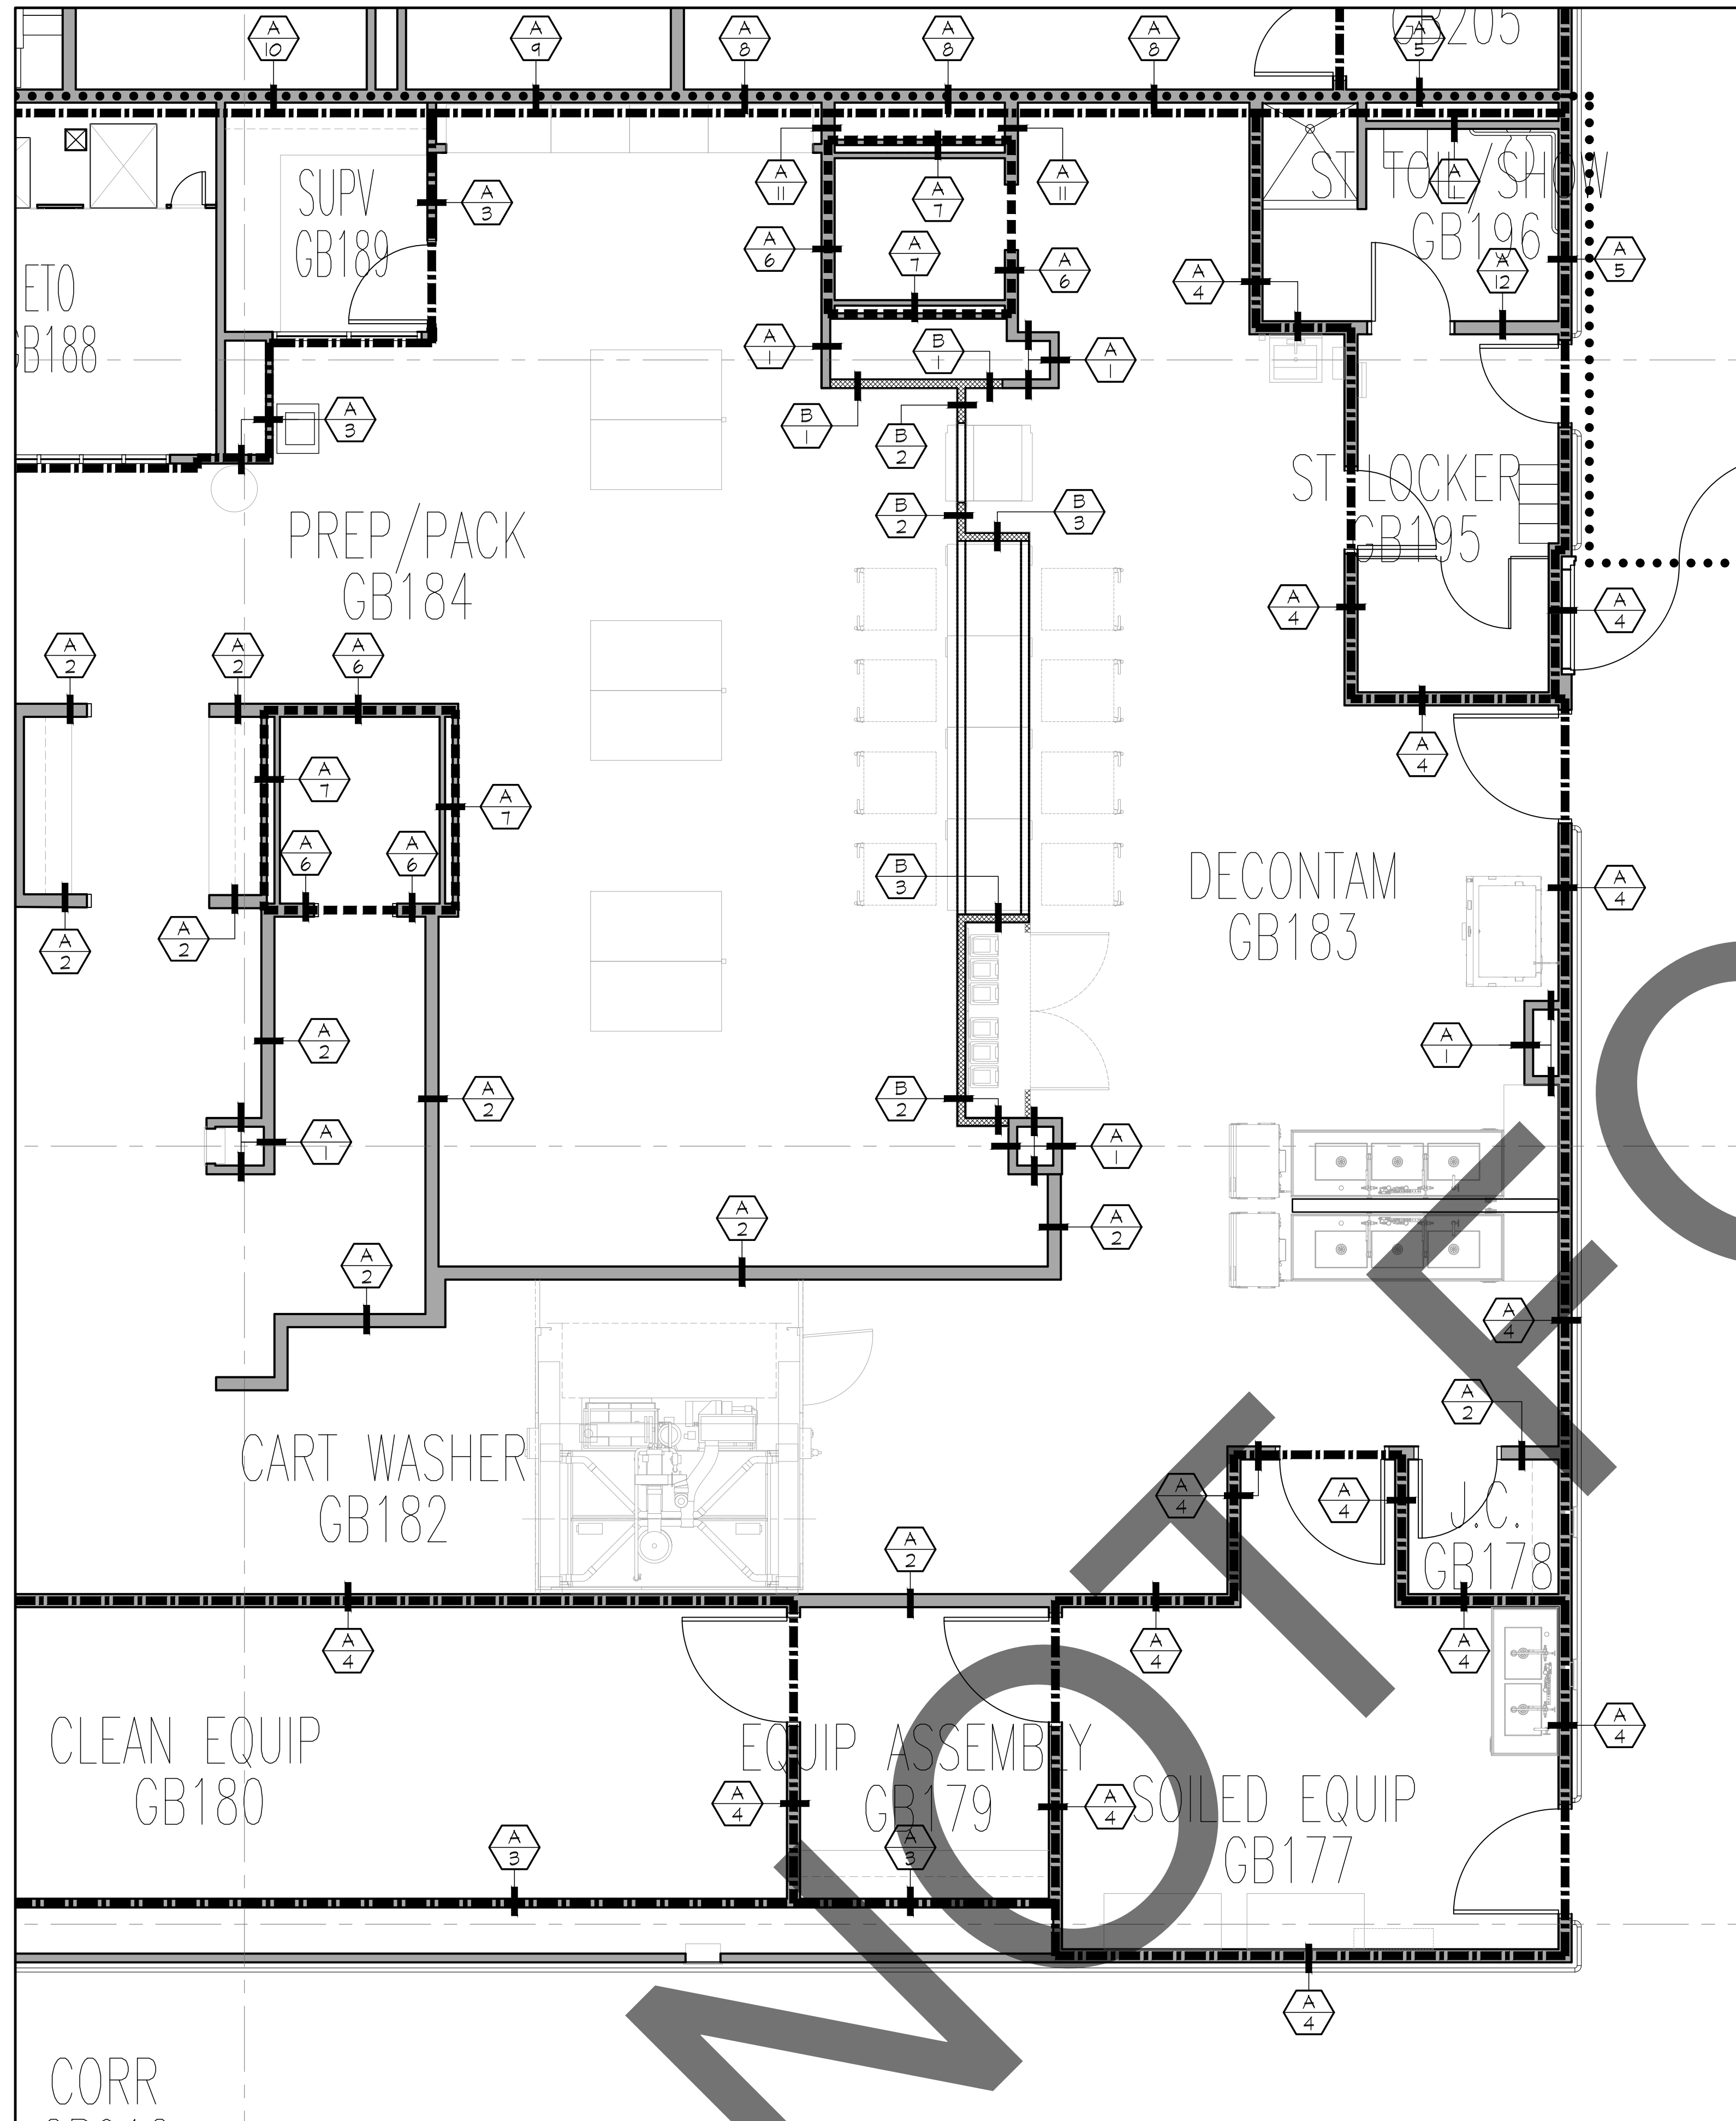


- EXISTING INT. NON-RATED WALL - 4"x16 GA. METAL STUDS AT 16" O.C. W/ (1) LAYER OF 5/8" GYP. BD. ON ONE SIDE OF THE WALL VERT. OR HORIZ. ATTACHED W/ TYPE 'S' DRYWALL SCREWS @ 1" O.C. W/ END JOINTS ON NAILING MEMBERS. STAGGER JOINTS. GYP. BD. HEIGHT IS 6" ABOVE (E) CEILING. WALL FILLED W/ KRAFT FACED INSULATION. CONTINUOUS ACOUSTICAL SEALANT @ TOP & BOTTOM OF WALL.
- EXISTING NON-RATED INT. WALL - 6"x16 GA. METAL STUDS AT 16" O.C. W/ (1) LAYER OF 5/8" GYP. BD. ON EACH SIDE OF THE WALL VERT. OR HORIZ. ATTACHED W/ TYPE 'S' DRYWALL SCREWS @ 1" O.C. W/ END JOINTS ON NAILING MEMBERS. STAGGER JOINTS. GYP. BD. HEIGHT IS 6" ABOVE (E) CEILING. WALL FILLED W/ KRAFT FACED INSULATION. CONTINUOUS ACOUSTICAL SEALANT @ BOTTOM OF WALL.
- EXISTING UL RATED ONE-HOUR FIRE RESISTIVE PARTITION INT. WALL - 4"x16 GA. METAL STUDS AT 16" O.C. W/ (1) LAYER OF 5/8" TYPE 'X' GYP. BD. ON EACH SIDE OF THE WALL VERT. OR HORIZ. ATTACHED W/ TYPE 'S' DRYWALL SCREWS @ 1" O.C. W/ END JOINTS ON NAILING MEMBERS. STAGGER JOINTS. HEIGHT OF GYP. BD TO BOTTOM OF STRUCTURE. WALL FILLED W/ ACOUSTICAL BATT INSULATION. FIRE STOP SEALANT. CONTINUOUS FIRE BARRIER - SEALANT TOP & BOTH SIDES - 3M CP 25 MB, HILT CS240, ALBI CLAD 15IC. CONTINUOUS ACOUSTICAL SEALANT @ BOTTOM OF WALL. FLUTES @ TOP OF WALL FILLED W/ THERMIFIBER OR EQUIVALENT. (U.L. DESIGN: U465).
- EXISTING UL-RATED ONE-HOUR FIRE RESISTIVE PARTITION (ONE HOUR PARTITION OCCUPANCY/SEPARATION) INT. WALL - 6"x16 GA. METAL STUDS AT 16" O.C. W/ (1) LAYER OF 5/8" TYPE 'X' GYP. BD. ON EACH SIDE OF THE WALL VERT. OR HORIZ. ATTACHED W/ TYPE 'S' DRYWALL SCREWS @ 1" O.C. W/ END JOINTS ON NAILING MEMBERS. STAGGER JOINTS. HEIGHT OF GYP. BD TO BOTTOM OF STRUCTURE. WALL FILLED W/ ACOUSTICAL BATT INSULATION. FIRE STOP SEALANT. CONTINUOUS FIRE BARRIER - SEALANT TOP & BOTH SIDES - 3M CP 25 MB, HILT CS240, ALBI CLAD 15IC. CONTINUOUS ACOUSTICAL SEALANT @ BOTTOM OF WALL. FLUTES @ TOP OF WALL FILLED W/ THERMIFIBER OR EQUIVALENT. (U.L. DESIGN: U465).
- EXISTING UL-RATED ONE-HOUR FIRE RESISTIVE PARTITION (ONE HOUR RATED SMOKE BARRIER & ONE HOUR PARTITION OCCUPANCY/SEPARATION) INT. WALL - 6"x16 GA. METAL STUDS AT 16" O.C. W/ (1) LAYER OF 5/8" TYPE 'X' GYP. BD. ON EACH SIDE OF THE WALL VERT. OR HORIZ. ATTACHED W/ TYPE 'S' DRYWALL SCREWS @ 1" O.C. W/ END JOINTS ON NAILING MEMBERS. STAGGER JOINTS. HEIGHT OF GYP. BD TO BOTTOM OF STRUCTURE. WALL FILLED W/ ACOUSTICAL BATT INSULATION. FIRE STOP SEALANT. CONTINUOUS FIRE BARRIER - SEALANT TOP & BOTH SIDES - 3M CP 25 MB, HILT CS240, ALBI CLAD 15IC. CONTINUOUS ACOUSTICAL SEALANT @ BOTTOM OF WALL. FLUTES @ TOP OF WALL FILLED W/ THERMIFIBER OR EQUIVALENT. (U.L. DESIGN: U465).
- EXISTING UL-RATED TWO-HOUR FIRE RESISTIVE PARTITION INT. SHAFT WALL - 6"x16 GA. METAL STUDS AT 16" O.C. W/ 1" THICK CAVITY SHAFT WALL LINER ON ONE SIDE OF THE WALL. AND (2) LAYER OF 5/8" TYPE 'X' GYP. BD. ON THE OPPOSITE SIDE OF THE WALL VERT. OR HORIZ. ATTACHED W/ TYPE 'S' DRYWALL SCREWS @ 1" O.C. W/ END JOINTS ON NAILING MEMBERS. STAGGER JOINTS. HEIGHT OF GYP. BD TO BOTTOM OF STRUCTURE. WALL FILLED W/ ACOUSTICAL BATT INSULATION. FIRE STOP SEALANT. CONTINUOUS FIRE BARRIER SEALANT TOP & BOTH SIDES - 3M CP 25 MB, HILT CS240, ALBI CLAD 15IC. CONTINUOUS ACOUSTICAL SEALANT @ BOTTOM OF WALL. FLUTES @ TOP OF WALL FILLED W/ THERMIFIBER OR EQUIVALENT. (U.L. DESIGN: U430).
- EXISTING UL-RATED TWO-HOUR FIRE RESISTIVE PARTITION INT. SHAFT WALL - 2"x20 GA. MIN. METAL STUDS AT 24" O.C. W/ 1" THICK CAVITY SHAFT WALL LINER ON ONE SIDE OF THE WALL. AND (2) LAYER OF 5/8" TYPE 'X' GYP. BD. ON THE OPPOSITE SIDE OF THE WALL VERT. OR HORIZ. ATTACHED W/ TYPE 'S' DRYWALL SCREWS @ 1" O.C. W/ END JOINTS ON NAILING MEMBERS. STAGGER JOINTS. HEIGHT OF GYP. BD TO BOTTOM OF STRUCTURE. WALL FILLED W/ ACOUSTICAL BATT INSULATION. FIRE STOP SEALANT. CONTINUOUS FIRE BARRIER SEALANT TOP & BOTH SIDES - 3M CP 25 MB, HILT CS240, ALBI CLAD 15IC. CONTINUOUS ACOUSTICAL SEALANT @ BOTTOM OF WALL. FLUTES @ TOP OF WALL FILLED W/ THERMIFIBER OR EQUIVALENT. (U.L. DESIGN: U430).
- EXISTING UL-RATED ONE-HOUR FIRE RESISTIVE PARTITION (ONE HOUR RATED SMOKE BARRIER & ONE HOUR PARTITION OCCUPANCY/SEPARATION) INT. WALL - 6"x16 GA. METAL STUDS AT 16" O.C. W/ (1) LAYER OF 5/8" TYPE 'X' GYP. BD. ON EACH SIDE OF THE WALL VERT. OR HORIZ. ATTACHED W/ TYPE 'S' DRYWALL SCREWS @ 1" O.C. W/ END JOINTS ON NAILING MEMBERS. STAGGER JOINTS. HEIGHT OF GYP. BD TO BOTTOM OF STRUCTURE. WALL FILLED W/ ACOUSTICAL BATT INSULATION. FIRE STOP SEALANT. CONTINUOUS FIRE BARRIER - SEALANT TOP & BOTH SIDES - 3M CP 25 MB, HILT CS240, ALBI CLAD 15IC. CONTINUOUS ACOUSTICAL SEALANT @ BOTTOM OF WALL. FLUTES @ TOP OF WALL FILLED W/ THERMIFIBER OR EQUIVALENT. (U.L. DESIGN: U465).
- EXISTING NON-RATED INT. WALL - 6"x16 GA. METAL STUDS AT 16" O.C. W/ (1) LAYER OF 5/8" GYP. BD. ON EACH SIDE OF THE WALL VERT. OR HORIZ. ATTACHED W/ TYPE 'S' DRYWALL SCREWS @ 1" O.C. W/ END JOINTS ON NAILING MEMBERS. STAGGER JOINTS. HEIGHT OF GYP. BD TO BOTTOM OF STRUCTURE. WALL FILLED W/ KRAFT FACED INSULATION. CONTINUOUS ACOUSTICAL SEALANT @ TOP & BOTTOM OF WALL.
- EXISTING NON-RATED INT. WALL - 6"x16 GA. METAL STUDS AT 16" O.C. W/ (1) LAYER OF 5/8" GYP. BD. ON EACH SIDE OF THE WALL VERT. OR HORIZ. ATTACHED W/ TYPE 'S' DRYWALL SCREWS @ 1" O.C. W/ END JOINTS ON NAILING MEMBERS. STAGGER JOINTS. HEIGHT OF GYP. BD TO BOTTOM OF STRUCTURE. WALL FILLED W/ KRAFT FACED INSULATION. CONTINUOUS ACOUSTICAL SEALANT @ TOP & BOTTOM OF WALL.
- NEW NON-RATED INT. WALL - 3/8" x 10 GA METAL STUDS W/ 3" BATT INSULATION AND 10 GA. S.S. SHEET METAL PANELS ON ONE SIDE OF WALL.
- NEW NON-RATED INT. WALL - 3/8" x 10 GA METAL STUDS W/ 3" BATT INSULATION AND 10 GA. S.S. SHEET METAL PANELS ON EA. SIDE OF WALL.
- NEW NON-RATED INT. WALL - 3/8" x 10 GA METAL STUDS W/ 3" BATT INSULATION AND 10 GA. S.S. SHEET METAL PANELS ON ONE SIDE OF WALL. INSTALL (1) LAYER OF 5/8" GYP. BD. ON THE OPPOSITE SIDE OF THE WALL VERT. OR HORIZ. ATTACHED W/ TYPE 'S' DRYWALL SCREWS @ 1" O.C. W/ END JOINTS ON NAILING MEMBERS. STAGGER JOINTS. GYP. BD. HEIGHT IS 6" ABOVE (E) CEILING.

- EXISTING WALL TO REMAIN. SEE WALL TYPES.
- NEW WALL. SEE WALL TYPES.
- EXISTING ONE-HOUR PARTITION OCCUPANCY SEPARATION TO REMAIN. SEE WALL TYPES.
- EXISTING TWO-HOUR RATED PARTITION AND/OR SHAFTWALLS TO REMAIN. SEE WALL TYPES.
- EXISTING ONE-HOUR RATED SMOKE BARRIER WALL TO REMAIN. SEE WALL TYPES.

## WALL TYPES

## WALL LEGEND

PROJECT TITLE: SONIC IRRIGATION REPLACEMENTS FOR THE ARROWHEAD REGIONAL MEDICAL CENTER 400 N. PEPPER AVE., COLTON, CA. 92324 WBS #: 10.10.1066 CIP #: 21-085 CAFM #: COL003

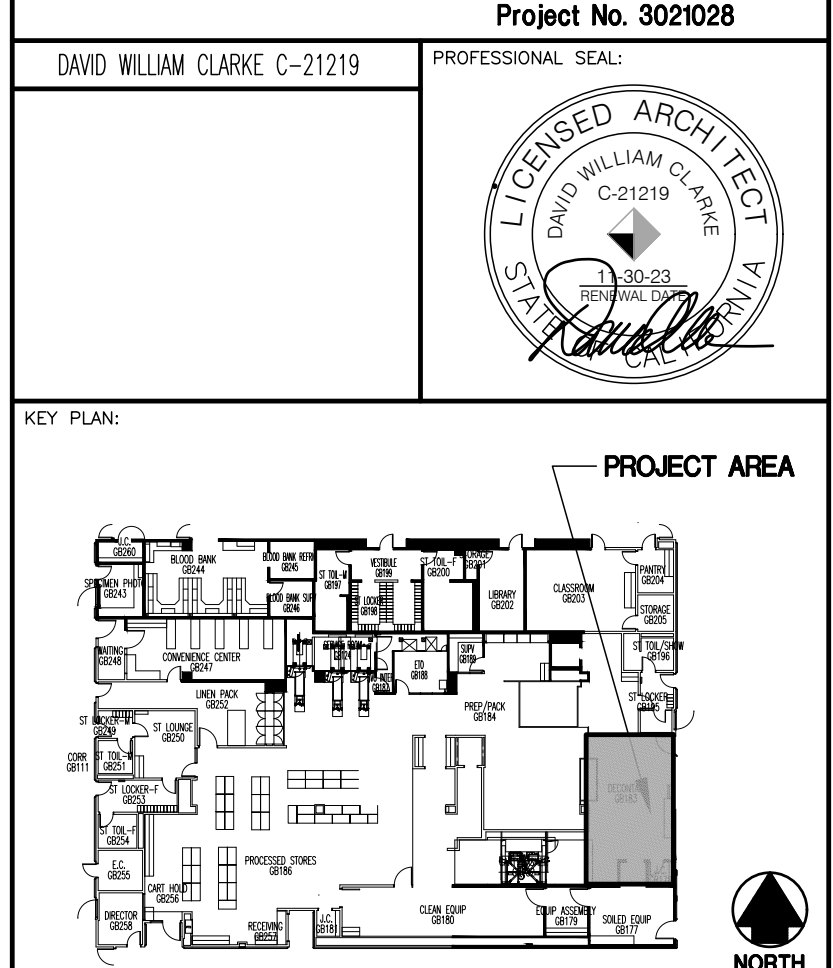

Department of Health Care Access and Information HCAI # S222316-36-00



No.	Date	Revision / Issue	REVISIONS
1	02.08.2023	PLAN CHECK	

Issue	Date	Job Number	Drawn	Checked	Approved
	12.28.2022	21007618.00			

LIFE SAFETY FLOOR PLAN

A2.2 SHEET NUMBER

## LIFE SAFETY FLOOR PLAN

1/4"=1'-0"

1




2019 CMC TABLE 4-A NOTES:

1. AIR QUANTITIES SHOWN IN THE TABLE BELOW IS FOR THE ENTIRE SPD AREA. THIS INCLUDES DECONTAMINATION ROOM GB183, WHICH IS OUR PROJECT AREA.

HVAC AIR BALANCE SUMMARY - PHARMACY STERILE DEPARTMENT																	
BAY/ID	ROOM NAME	SERVICE DESCRIPTION / TEST TABLE #	AREA (SQ FT)	HEIGHT (FT)	VOLUME (CU FT)	REQUIRED OSA				NOTED OSA				EAF ADP (CFM)	FRA RET. ADP (CFM)	FRESH AIR (CFM)	UNIT SERVED
						ACHRR		OSA (CFM)		ACHRR		OSA (CFM)					
						MIN REQD	DESIGN	MIN REQD	DESIGN	MIN REQD	DESIGN	MIN REQD	DESIGN				
GB111	CORRIDOR	PATIENT CORRIDOR	576	9.0	5215	0	4.4	0	380	2	10.4	174	600	0	900	NR	
GB124	SERVICE ROOM	STERILIZER EQUIPMENT ROOM	181	9.0	1627	0	9.2	0	250	10	44.3	271	1200	1320	0	N	
GB177	SOILED EQUIPMENT	SOILED WORK ROOM/UTILITY ROOM	260	9.0	2320	2	6.0	84	250	10	12.4	420	520	570	0	N	
GB178	J.C.	JANITOR CLOSET	25	9.0	225		16.7	0	250	10	15.9	44	78	80	0	N	
GB179	EQUIPMENT ASSEMBLY	SUBSTERILE SERVICE AREA	106	9.0	949	2	0.4	32	6	8	8.9	35	140	0	80	NR	
GB180	CLEAN EQUIPMENT	CLEAN WORK ROOM	507	10.0	5065	2	0.0	169	4	4	7.3	338	600	0	600	P	
GB181	J.C.	JANITOR CLOSET	30	9.0	270		14.9	0	250	10	13.2	46	80	80	0	N	
GB182	CART WASHER	STERILIZER EQUIPMENT ROOM	120	11.0	1320	0	3.2	0	70	10	0.0	220	0	1400	0	N	
GB183	DECONTAM	SOILED OR DECONTAMINATION ROOM	362	10.0	3617	2	4.8	327	800	8	11.5	382	1880	3840	0	N	
GB184	PREP / PACK	PREPARATION ROOM	157	10.0	1569	2	0.8	319	35	6	14.8	957	2385	465	800	P	
GB185	CART HOLD	CLEAN WORKROOM OR CLEAN HOLDING	253	10.0	2530	2	1.3	84	55	4	9.1	168	385	0	0	P	
GB186	PROCESSED STORES	STERILE STORAGE	2884	10.0	28840	2	0.1	985	50	4	10.3	1889	5120	0	3235	P	
GB187	SVC INTER	STERILIZER EQUIPMENT ROOM	86	9.0	864	0	2.8	0	40	10	27.8	144	400	445	0	NR	
GB188	STERRAD	STERILIZER EQUIPMENT ROOM	114	9.0	1026	0	7.8	0	130	10	23.4	171	400	445	0	N	
GB189	SUPV	ADMINISTRATIVE	67	8.0	539	2	14.5	18	130	6	10.0	54	90	0	90	NR	
GB195	ST LOCKER	MEDICAL STAFF SUPPORT	102	9.0	922	2	5.0	31	123	8	13.0	92	200	170	0	NR	
GB196	ST TOIL/SHOWER	TOILET ROOM	85	9.0	768	0	10.2	0	130	10	12.5	128	180	190	0	N	
GB247	CONVENIENCE CENTER	MEDICAL STAFF SUPPORT	498	9.0	4395	2	1.7	147	125	6	7.4	440	540	0	540	NR	
GB248	WAITING	WAITING AREA PRIMARY CARE CLINIC	82	9.0	742	2	15.0	29	186	10	7.3	124	90	0	80	NR	
GB249	ST LOCKER-M	MEDICAL STAFF SUPPORT	49	9.0	438	2	75.4	15	550	6	12.2	44	90	85	0	NR	
GB250	ST LOUNGE	MEDICAL STAFF SUPPORT	207	9.0	1864	2	17.7	62	550	6	12.9	168	400	0	400	NR	
GB251	ST TOIL-M	TOILET ROOM	55	9.0	522	0	5.7	0	50	10	10.8	87	95	120	0	N	
GB252	LINEN PACK	CLEAN LINEN STORAGE	370	9.0	3327	0	5.0	0	280	2	8.3	111	460	0	460	NR	
GB253	ST LOCKER-F	MEDICAL STAFF SUPPORT	128	9.0	1152	2	0.0	39	0	6	13.9	116	270	240	0	NR	
GB254	ST TOIL-F	TOILET ROOM	67	8.0	603	0	0.0	0	0	10	13.9	100	140	170	0	N	
GB255	E.C.	MEDICAL STAFF SUPPORT	91	11.0	1005	2	0.0	33	0	8	6.6	100	110	0	110	NR	
GB914	CORRIDOR	PATIENT CORRIDOR	545	9.0	4903		0.0	0	0	2	10.0	163	820	0	820	NR	
			9560						4693		TOTAL #	17523	9600	8095			

PROJECT TITLE: SONIC IRRIGATION REPLACEMENTS FOR THE ARROWHEAD REGIONAL MEDICAL CENTER 400 N. PEPPER AVE., COLTON, CA. 92324 WBSE #: 10.10.1066 CIP #: 21-065 CAFM #: COL003




501 VIA REMONTE, SUITE 400  
ONTARIO, CA 91764  
909.477.8915 FAX: 909.477.8916  
www.imegcorp.com  
PROJECT # 21007618.00

IMEG CORP. RESERVES PROPRIETARY RIGHTS, INCLUDING COPYRIGHTS, TO THIS DRAWING AND THE DATA SHOWN THEREON. NO PART OF THIS DRAWING OR DATA ARE TO BE REPRODUCED OR TRANSMITTED IN ANY FORM OR BY ANY MEANS, ELECTRONIC OR MECHANICAL, INCLUDING PHOTOCOPYING, RECORDING, OR BY ANY INFORMATION STORAGE AND RETRIEVAL SYSTEM, WITHOUT THE EXPRESS WRITTEN APPROVAL AND PARTICIPATION OF IMEG CORP. © 2005 IMEG CORP.

REFERENCE SCALE IN INCHES

0 1 2 3

PROFESSIONAL SEAL:

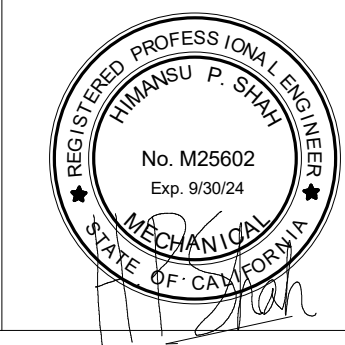

ARCHITECT:




73121 FRED WARING DR. STE. 200  
PALM DESERT, CA 92260  
760-327-6800


Project No. 3021028.00

DAVID WILLIAM CLARKE C-21219

PROFESSIONAL SEAL:

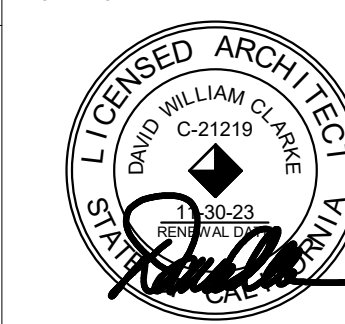

KEY PLAN:

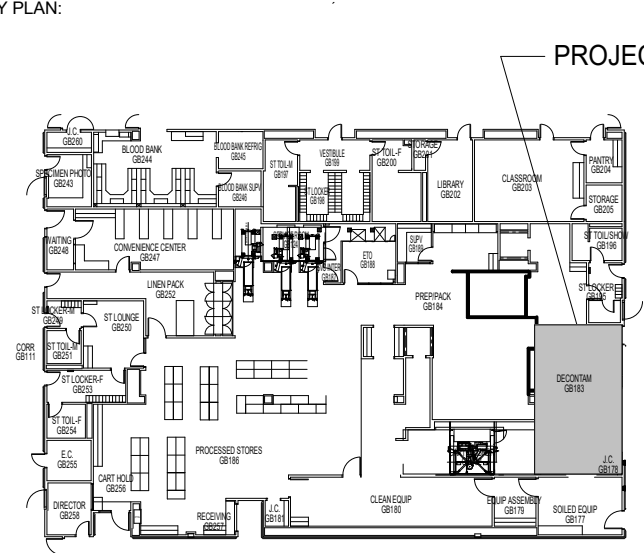

PROJECT AREA

NORTH

Department of Health Care Access and Information

HCAI # S222316-36-00



REVIEWED IN ACCORDANCE WITH THE REQUIREMENTS OF T24, COR

APPROVED with comments

Department of Health Care Access & Information

Office of Statewide Hospital Planning & Development

5/16/2023, 2:27:57 PM

S222316-36-00

Laura Baldrat

No.	Date	Revision / Issue	REVISIONS
1	2/8/23	HCAI COMMENT	

SHEET INFORMATION	
Issue	100% CONSTRUCTION DOCUMENTS
Date	12/28/2022
Job Number	21007618.00
Drawn	Author
Checked	Checker
Approved	



S:\Active Projects\County of San Bernardino\On Call Projects\Arrowhead Regional Medical Center\3021027 T1.dwg Oct. 16, 2023 -- 11:08am


# STERILIZATION SYSTEM INSTALLATION



ARROWHEAD  
REGIONAL MEDICAL CENTER


400 N. PEPPER AVE. COLTON CA. 92324  
WBSE # 10.10.1142

## VICINITY MAP

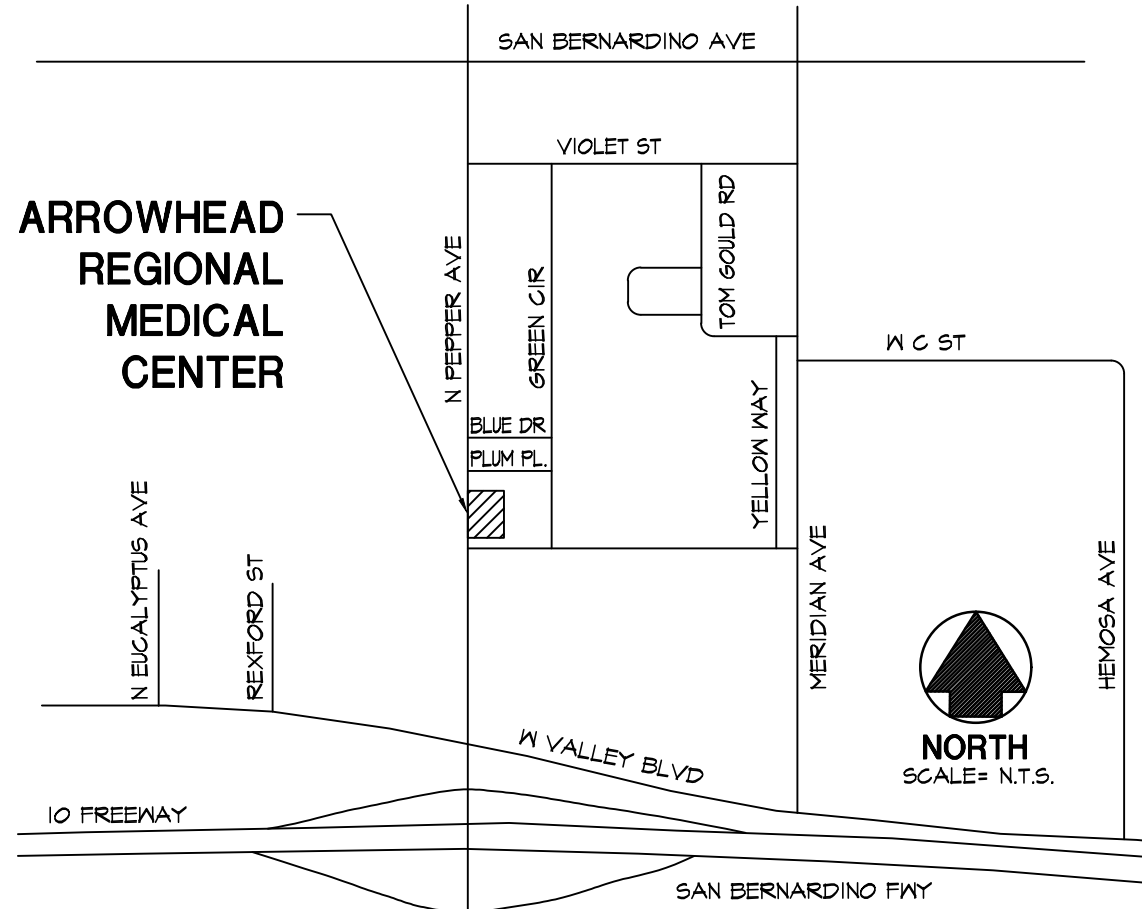

## KEY MAP

ARROWHEAD REGIONAL  
MEDICAL CENTER  
FACILITY #17282

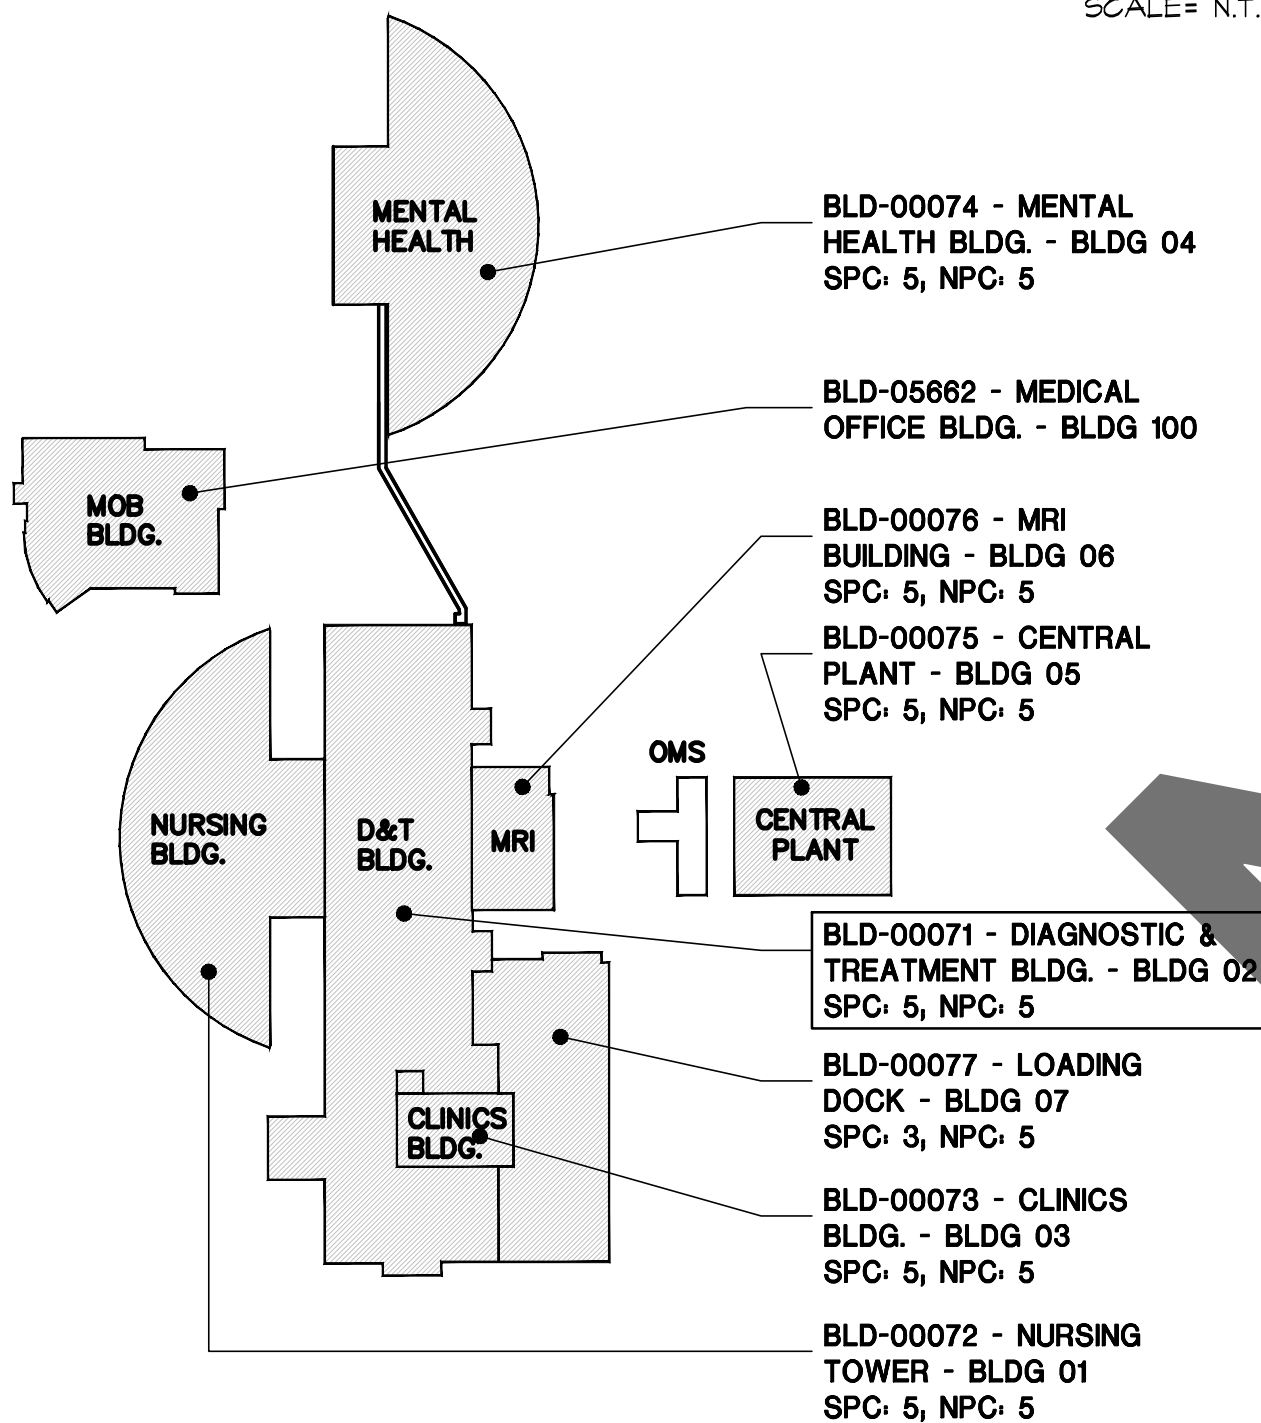

## PROJECT DATA

### APPLICABLE CODES: (PER 2019 CBC CHAPTER 35)

- 2019 CALIFORNIA ADMINISTRATIVE CODE (CAC)
  - 2019 CALIFORNIA CODE OF REGULATIONS (CCR)
  - 2019 CALIFORNIA BUILDING CODE (CBC)
  - 2019 CALIFORNIA ELECTRICAL CODE (CEC)
  - 2019 CALIFORNIA MECHANICAL CODE (CMC)
  - 2019 CALIFORNIA PLUMBING CODE (CPC)
  - 2019 CALIFORNIA FIRE CODE (CFC)
  - 2019 CALIFORNIA HISTORICAL BUILDING CODE (CHBC)
  - 2019 CALIFORNIA INTERNATIONAL BUILDING CODE (IBC)
  - 2019 CALIFORNIA INTERNATIONAL FIRE CODE (IFC)
  - 2019 CALIFORNIA EXISTING BUILDING CODE (CEBC)
  - 2019 CALIFORNIA GREEN BUILDING STANDARDS CODE (CALGREEN)
  - 2019 CALIFORNIA REFERENCED STANDARDS CODE (CRSC)
  - 2019 NFPA 99 HEALTHCARE FACILITIES CODE
  - 2019 NFPA 101 LIFE SAFETY CODE
- THE JOINT COMMISSION REQUIRES REFERENCE TO THE FOLLOWING CODES:
- 2019 NFPA 12
  - 2019 NFPA 99 HEALTHCARE FACILITIES CODE
  - 2019 NFPA 101 LIFE SAFETY CODE

### NEW AND EXISTING CONSTRUCTION:

TYPE I-A, FULLY SPRINKLERED BY AUTOMATIC FIRE SPRINKLER SYSTEM

### BUILDING HEIGHT:

FOUR STORY BUILDING - 77'-4" ROOF HEIGHT

### CONSTRUCTION TYPE:

- EXISTING BUILDING ELEMENTS
- EXTERIOR BEARING WALLS (PREGAST CONC. WALL) 3 HR.
- INTERIOR BEARING WALLS (NONE) 3 HR.
- STRUCTURAL FRAME (CONC. COLUMNS W/ CONC. BEAMS) 3 HR.
- INTERIOR NON-LOAD BEARING PARTITIONS (20 GA STL. STUDS) 0
- SHAFT ENCLOSURES 2 HR.
- FLOORS (CONCRETE SLAB) 2 HR.
- ROOFS (CONCRETE SLAB) 1 1/2 HR.

### OCCUPANCY:

- GROUP I-2 (HOSPITAL)
- GROUP S-2 (CENTRAL PLANT)

### SB-1953 STATUS:

- SPC: 5
- NPC: 5

### DEFERRED APPROVALS: (THE FOLLOWING ARE DEFERRED APPROVALS THAT REQUIRE HCAI REVIEW AND APPROVAL PRIOR TO THEIR FABRICATION AND/OR INSTALLATION.)

- NONE

### CERTIFICATION OF EQUIPMENT AND NONSTRUCTURAL COMPONENTS:

IN ACCORDANCE WITH 2019 CBC, SECTION 1705.10.2, "SEISMIC CERTIFICATION OF NONSTRUCTURAL COMPONENTS".

- THERE ARE NO COMPONENTS OR EQUIPMENT THAT REQUIRE SPECIAL SEISMIC CERTIFICATION.
- NONE REQUIRED

### AREA:

PROJECT AREA = 1,131 S.F.

### DESCRIPTION OF WORK:

REMOVAL OF (3) EXISTING STERILE WASHERS, (3) SINKS, AND THE STAINLESS STEEL BARRIER WALL BETWEEN CLEAN AND DECONTAMINATION SIDES OF THE STERILE PROCESSING UNIT (SPU). AND THE INSTALLATION OF (4) NEW STERILE WASHERS, (3) NEW SINKS, A NEW STAINLESS STEEL BARRIER WALL BETWEEN STERILE AND DECONTAMINATION SIDES OF THE SPU, AND REPLACEMENT OF FLOORING IN THE PROJECT SCOPE AREA.

THE MOBILE SPD TRAILER PROJECT S222348-36-00 SHALL BE COMPLETED AND LICENSED BY CDPH BEFORE THE CURRENT PROJECT S222341-36 CAN START CONSTRUCTION.

## INDEX TO DRAWINGS

### ARCHITECTURAL

- T1.1 TITLE SHEET - INDEX TO DRAWINGS
- T1.2 GENERAL NOTES
- A1.1 GROUND FLOOR OVERALL SITE AND ACCESSIBILITY PLAN
- A1.2 GROUND FLOOR - TEMPORARY SPD OPERATIONS PLAN
- D2.1 DEMOLITION FLOOR PLAN
- D5.1 DEMOLITION REFLECTED CEILING PLAN
- D8.1 DEMOLITION & REMODEL - INTERIOR ELEVATIONS
- A2.1 REMODEL FLOOR PLAN
- A2.2 LIFE SAFETY FLOOR PLAN
- A2.1 REMODEL REFLECTED CEILING PLAN

### STRUCTURAL

- S1.1 GENERAL NOTES & EQUIPMENT PLAN
- S1.2 WALL ELEV., SECTION & DETAILS
- S1.3 EQUIPMENT ANCHORAGE DETAILS
- M1.1 GROUND LEVEL DEMOLITION PLAN - MECHANICAL
- M2.1 GROUND LEVEL PLAN - MECHANICAL
- M2.2 DETAILS
- M2.3 DETAILS

### MECHANICAL

- M0.1 MECHANICAL COVERSHEET
- M0.2 SCHEDULES
- M0.3 SPECIFICATIONS
- M0.4 SPECIFICATIONS
- M0.5 SPECIFICATIONS
- M0.6 SPECIFICATIONS
- P1.1 GROUND LEVEL DEMOLITION PLAN - PLUMBING
- P2.1 GROUND LEVEL PLAN - PLUMBING
- P2.2 DETAILS
- P2.3 DETAILS

### PLUMBING

- P0.1 PLUMBING COVERSHEET
- P0.2 SCHEDULES
- P0.3 SPECIFICATIONS
- P0.4 SPECIFICATIONS
- P1.1 GROUND LEVEL DEMOLITION PLAN - PLUMBING
- P2.1 GROUND LEVEL PLAN - PLUMBING
- P2.2 DETAILS
- P2.3 DETAILS

### ELECTRICAL

- E0.1 ELECTRICAL COVERSHEET
- E0.2 SINGLE LINE DIAGRAM
- E1.0 OVERALL GROUND LEVEL PLAN - ELECTRICAL
- E1.1 GROUND LEVEL DEMOLITION PLAN - ELECTRICAL
- E2.1 GROUND LEVEL PLAN - ELECTRICAL
- E3.1 DETAILS

## SYMBOL LEGEND

- 1. COLUMN LINES, GRID LINES LETTERS IN ONE DIRECTION NUMBERS IN OTHER DIRECTION
- 2. MATCH LINE SHOWN PORTION IS THE SIDE SHOWN SHEET WHERE UNKNOWN PORTION IS DRAWN
- 3. SECTION ELEVATION SECTION ELEVATION IDENTIFICATION SHEET WHERE SECTION ELEVATION IS DRAWN
- 4. DETAIL DETAIL IDENTIFICATION SHEET WHERE DETAIL IS DRAWN
- 5. DOOR SYMBOL
- 6. GLAZING SYMBOL
- 7. REVISION CLOUD AROUND REVISED AREA REVISION NUMBER
- 8. ROOM IDENTIFICATION INTERIOR ELEVATION
- 9. ROOM NAME ELEVATION IDENTIFICATION ROOM NUMBER
- 10. WORK POINT, CONTROL POINT OR DATUM POINT

## GENERAL NOTES

### A. EQUIPMENT ANCHORAGE :

ANCHORAGE AND SUPPORTS OF ALL EQUIPMENT TO BE INSTALLED, AS A PART OF THIS PROJECT SHALL BE DETAILED ON CONSTRUCTION DOCUMENTS EXCEPT THOSE EXEMPT BY 2019 CBC SECTION 1610.1.8 ASCE 1, SECTION 13.1.4.

- 1. FURNITURE (EXCEPT STORAGE CABINETS AS NOTED IN TABLE 13.5.1 OF ASCE 7).
- 2. TEMPORARY OR MOVABLE EQUIPMENT.

#### EXCEPTIONS:

- a) EQUIPMENT SHALL BE ANCHORED IF IT IS PERMANENTLY ATTACHED TO THE BUILDING UTILITY SERVICES SUCH AS ELECTRICITY, GAS OR WATER FOR THE PURPOSES OF THIS REQUIREMENT, "PERMANENTLY ATTACHED" SHALL INCLUDE ALL ELECTRICAL CONNECTIONS EXCEPT PLUGS FOR 110/220 VOLT RECEPTACLES HAVING A FLEXIBLE CABLE.
- b) MOVABLE OR MOBILE EQUIPMENT WHICH IS HEAVIER THAN 400 POUNDS OR HAS A CENTER OF MASS LOCATED 4 FEET (1.22 M) OR MORE ABOVE THE ADJACENT FLOOR OR ROOF LEVEL THAT DIRECTLY SUPPORTS THE COMPONENT, SHALL BE RESTRAINED IN A MANNER APPROVED BY THE ENFORCEMENT AGENCY. MOBILE EQUIPMENT SHALL BE RESTRAINED WHEN NOT IN USE AND IS STORED, UNLESS THE EQUIPMENT IS STORED IN A STORAGE ROOM THAT DOES NOT HOLD HAZARDOUS MATERIALS OR ANY FACILITY SYSTEMS OR FIXED EQUIPMENT THAT CAN BE AFFECTED BY MOBILE EQUIPMENT LACKING RESTRAINT.
- c) HCAI 1 & 4) MOVABLE EQUIPMENT SHALL BE ANCHORED BY DETACHABLE ANCHORS OR RESTRAINTS IN A MANNER APPROVED BY THE ENFORCEMENT AGENCY, WHEN UTILITIES AND SERVICES AT THE EQUIPMENT HAVE FLEXIBLE CONNECTIONS TO ALLOW FOR NECESSARY MOVEMENT.
- d) HCAI 1 & 4) MOBILE EQUIPMENT HEAVIER THAN 400 POUNDS THAT HAS A CENTER OF MASS LOCATED 4 FEET (1.22 M) OR MORE ABOVE THE ADJACENT FLOOR OR ROOF LEVEL THAT DIRECTLY SUPPORTS THE EQUIPMENT SHALL BE RESTRAINED IN A MANNER APPROVED BY THE ENFORCEMENT AGENCY WHEN NOT IN USE AND IS STORED, UNLESS THE EQUIPMENT IS STORED IN AN EQUIPMENT STORAGE ROOM.

- 3. DISCRETE ARCHITECTURAL, MECHANICAL AND ELECTRICAL COMPONENTS AND FIXED EQUIPMENT IN SEISMIC DESIGN CATEGORY D, E OR F THAT ARE POSITIVELY ATTACHED TO THE STRUCTURE AND ANCHORAGE IS DETAILED ON THE PLANS, PROVIDED THAT EITHER:

- a) THE COMPONENT WEIGHS 400 POUNDS (180 N) OR LESS, THE CENTER OF MASS IS LOCATED 4 FEET (1.22 M) OR LESS ABOVE THE ADJACENT FLOOR OR ROOF LEVEL THAT DIRECTLY SUPPORTS THE COMPONENT, AND FLEXIBLE CONNECTIONS ARE PROVIDED BETWEEN THE COMPONENT AND ASSOCIATED DUCTWORK, PIPING AND CONDUIT.
- EXCEPTION : SPECIAL SEISMIC CERTIFICATION REQUIREMENTS OF THIS CODE IN ACCORDANCE WITH SECTION 1705.10.3 SHALL BE APPLICABLE.
- OR
- b) THE COMPONENT WEIGHS 20 POUNDS (91 N) OR LESS OR, IN THE CASE OF A DISTRIBUTED SYSTEM 5 LB/FT (73 N/M) OR LESS.
- EXCEPTION : THE ENFORCEMENT AGENCY SHALL BE PERMITTED TO REQUIRE ATTACHMENTS FOR EQUIPMENT WITH HAZARDOUS CONTENTS TO BE SHOWN ON CONSTRUCTION DOCUMENTS IRRESPECTIVE OF WEIGHT.

### B. INSTALLATION OF POST INSTALLED ANCHORS :

- 1. WHEN INSTALLING DRILLED-IN ANCHORS AND/OR POWDER DRIVEN PINS IN EXISTING NON-PRESTRESSED REINFORCED CONCRETE, USE CARE AND CAUTION TO AVOID CUTTING OR DAMAGING THE EXISTING REINFORCING BARS. WHEN INSTALLING THEM INTO EXISTING PRE-STRESSED CONCRETE (PRE- OR POST-TENSIONED) LOCATE THE PRESTRESSED TENDONS BY USING A NON-DESTRUCTIVE METHOD PRIOR TO INSTALLATION. EXERCISE EXTREME CARE AND CAUTION TO AVOID CUTTING OR DAMAGING THE TENDONS DURING INSTALLATION. MAINTAIN A MINIMUM CLEARANCE OF ONE INCH BETWEEN THE REINFORCEMENT AND THE DRILLED-IN ANCHOR AND/OR PIN.

### C. FIRE SPRINKLERS :

- 1. SPACING AND DETAILS OF THE SUPPORT AND BRACING OF FIRE SPRINKLER PIPING SHALL COMPLY WITH THE 2016 EDITION OF NFPA 13 AND CHAPTER 13 OF ASCE 7 AS MODIFIED BY THE CBC 2019, SECTION 1610.1A AND STATE FIRE MARSHAL AMENDMENTS.

### D. LATERAL FORCE DESIGN CRITERIA :

- PER 2019 CBC SECTION 1603.1.5, THE FOLLOWING INFORMATION RELATED TO SEISMIC IMPORTANCE FACTOR, ANCHORAGE DESIGN SHALL BE AS NOTED BELOW:
- 1. SEISMIC IMPORTANCE FACTOR:..... I<sub>p</sub> = 1.5
- 2. RISK CATEGORY:..... IV
- 3. MAPPED SPECTRAL RESPONSE ACCELERATIONS:..... S<sub>s</sub> = 2.061  
S<sub>1</sub> = 0.818
- 4. SITE CLASS:..... D
- 5. SPECTRAL RESPONSE COEFFICIENTS:..... S<sub>DS</sub> = 1.649  
S<sub>1</sub> = NULL
- 6. SEISMIC DESIGN CATEGORY:..... F

## POLICY INTENT NOTICE

THE INTENT OF THE CONSTRUCTION DRAWINGS IS TO RECONSTRUCT THE HOSPITAL BUILDING IN ACCORDANCE WITH THE 2019 CALIFORNIA BUILDING STANDARDS CODE (CBC). SHOULD ANY CONDITION DEVELOP NOT COVERED BY THE APPROVED CONSTRUCTION DOCUMENTS, WHEN THE FINISHED WORK WILL NOT COMPLY WITH THE 2019 CBC, AMENDED CONSTRUCTION DOCUMENTS DETAILING AND SPECIFYING THE REQUIRED WORK SHALL BE SUBMITTED TO AND APPROVED BY HCAI BEFORE PROCEEDING WITH THE WORK.

### E. INFECTION CONTROL :

- 1. PROVIDE AND INSTALL TEMPORARY BARRICADES MEETING ICRA LEVEL 4 CONTAINMENT STANDARDS. A PRE-MANUFACTURED MODULAR WALL SYSTEM (SUCH AS BY STARC SYSTEMS "REALWALL") IS ACCEPTABLE, WHERE NO FIRE RATING IS REQUIRED. FIRE RESISTANT PLASTIC SHEETS (SOFT BARRICADE) IS NOT ACCEPTABLE.
- 2. BARRICADES ARE TO PREVENT UNAUTHORIZED ENTRY INTO THE CONSTRUCTION AREA AND TO PERMIT THE OWNER THE CONTINUED USE OF THE ADJACENT AREAS. BARRICADES SHALL BE AIR TIGHT SO AS NO DUST, CONTAMINATED AIR, FUMES, GASES, AND ODORS WILL BE ALLOWED IN CORRIDORS OR ANY OTHER OCCUPIED AREAS.
- 3. PROVIDE CONTAMINATION CONTROL FLOOR MATS (STICKY MATS) AT THE ACCESS TO THE CONSTRUCTION AREA TO PREVENT THE TRACKING OF CONSTRUCTION DUST.
- 4. MAINTAIN NEGATIVE AIR PRESSURE (A MAGNETIC GAUGE READING OF -10) CONTINUOUSLY AND UNINTERRUPTED FOR THE DURATION OF THE CONSTRUCTION. THE NEGATIVE AIR PRESSURE MAY BE ACHIEVED BY PORTABLE FANS AND AIR SCRIBBERS WITH HEPA FILTERS AND FAN UNITS TO FACILITATE THE VENTILATION OF THE ENCLOSED CONSTRUCTION AREA. UNITS SHALL BE SET UP TO EXHAUST DIRECTLY TO THE OUTSIDE. WHERE IT IS NOT POSSIBLE TO EXHAUST TO THE OUTSIDE, FILTERED AIR MAY BE RE-CIRCULATED WITHIN THE CONSTRUCTION AREA.
- 5. PROVIDE VISQUEEN BARRICADES PRIOR TO THE ERECTION OF HARD BARRICADES AND PRIOR TO REMOVING THEM. VACUUM AREA WITH HEPA VACUUM AFTER REMOVING THE HARD BARRICADE AND PRIOR TO REMOVING THE SOFT BARRICADE. CARE SHOULD BE TAKEN NOT TO TRANSMIT DUST ON THE VISQUEEN INTO ADJACENT AREAS.

## DESIGN PROFESSIONALS OF RECORD

### ARCHITECT OF RECORD

DAVID W. CLARKE, LIC. NO. C21219  
MARKS ARCHITECTS, INC.  
73121 FRED WARING DR., SUITE 200  
PALM DESERT, CA 92260  
(760) 327-6800 (575) 640-5673  
DAVID@MARKSARCHITECTS.COM

### MECHANICAL ENGINEER OF RECORD

HIMANSU P. SHAH, LIC. NO. M25602  
IMEG CORP.  
901 VIA PIEMONTE, SUITE 400  
ONTARIO, CA 91764  
(714) 767-5446 (626) 463-2865  
HIMANSU.P.SHAH@IMEGCORP.COM

### ELECTRICAL ENGINEER OF RECORD

NESTOR C. IGNACIO, LIC. NO. E16934  
IMEG CORP.  
901 VIA PIEMONTE, SUITE 400  
ONTARIO, CA 91764  
(909) 442-5548 (909) 374-0412  
NESTOR.C.IGNACIO@IMEGCORP.COM

### STRUCTURAL ENGINEER OF RECORD

CHE TANG, LIC. NO. S4433  
TANG STRUCTURAL ENGINEERS, INC.  
7950 CHERRY AVE., SUITE 114  
FONTANA, CA 92336  
(909) 429-0450 (909) 856-9967  
CHE@TANG-SE.COM

## OWNERSHIP OF INSTRUMENTS OF SERVICE

ALL REPORTS, PLANS, SPECIFICATIONS, COMPUTER FILES, FIELD DATA, NOTES AND OTHER DOCUMENTS AND INSTRUMENTS INCLUDING ANY DOCUMENTS ON ELECTRONIC MEDIA PREPARED BY MARKS ARCHITECTS, INC. (MAI) AS INSTRUMENTS OF SERVICE SHALL REMAIN THE PROPERTY OF MAI. MAI SHALL RETAIN ALL COMMON LAW, STATUTORY AND OTHER RESERVED RIGHTS, INCLUDING THE COPYRIGHT THERE TO.


STERILIZATION SYSTEM  
INSTALLATION  
FOR THE  
ARROWHEAD REGIONAL  
MEDICAL CENTER  
400 N. PEPPER AVE.  
COLTON, CA. 92324  
WBSE #10.10.1142 - CIP #21-154 - CAFM #COL003

Department of Health Care Access and Information

HCAI # S222347-36-00



## REFERENCE PLAN

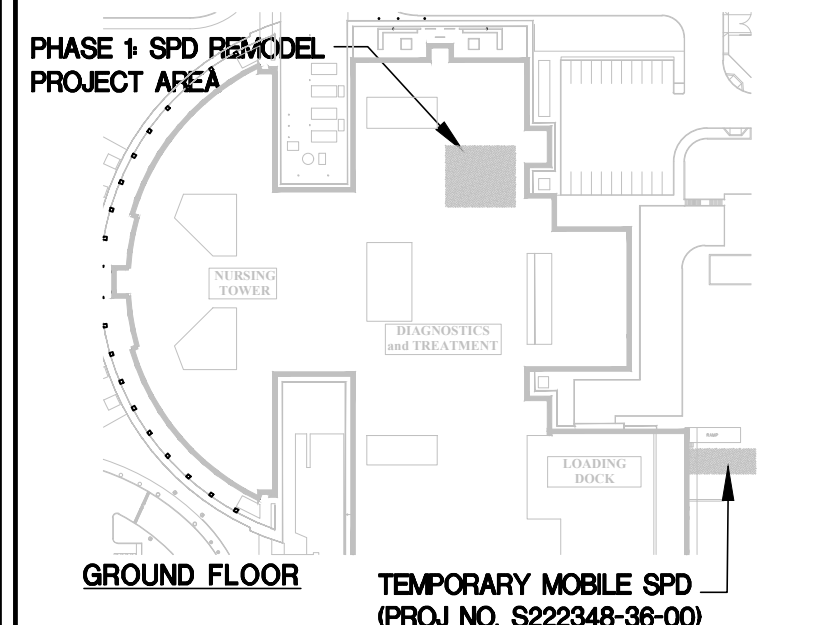


©marks architects, inc. 2022  
ALL REPORTS, PLANS AND DOCUMENTS PREPARED BY MARKS ARCHITECTS, INC. SHALL REMAIN THE PROPERTY OF MARKS ARCHITECTS, INC. AND ARE INTENDED FOR THIS SPECIFIC PROJECT ONLY. OTHER USES ARE PROHIBITED UNLESS OTHERWISE CONTRACTED.

TITLE SHEET -  
INDEX TO DRAWINGS

DATE  
DECEMBER 28, 2022

### REVISIONS

- 1. PLAN CHECK COMMENTS - 02.13.2023
- 2. AMCO0001 - 06.13.2023
- 3. PLAN CHECK COMMENTS - 06.27.2023
- 4. PLAN CHECK COMMENTS - 08.15.2023

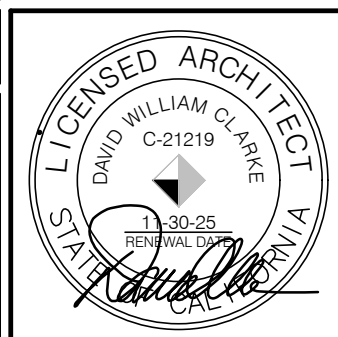

PROJECT NUMBER  
3021027

DRAWING NUMBER

T1.1



S:\Active Projects\County of San Bernardino\On Call Projects\Arrowhead Regional Medical Center\3021027 T1.2.dwg Oct 16, 2023 -- 11:09am

## GENERAL NOTES

### GENERAL REQUIREMENTS


- ALL DISTANCES, DATA AND EXISTING STRUCTURES AND UTILITIES ABOVE OR BELOW THE GROUND, WITHIN THE LIMITS OF THIS PROJECT SHALL BE CHECKED BY THE CONTRACTOR. IN CASE OF CONFLICT, THE ARCHITECT SHALL BE NOTIFIED IMMEDIATELY IN ORDER THAT CLARIFICATION MAY BE MADE.
- PRIOR TO START OF WORK, THE CONTRACTOR SHALL CAREFULLY INSPECT AND VERIFY ALL CONDITIONS SHOWN ON THE CONTRACT DRAWINGS. IF WORK CAN NOT BE PERFORMED AS SHOWN, THE CONTRACTOR SHALL NOTIFY THE ARCHITECT IMMEDIATELY. WORK PERFORMED AFTER SUCH DISCOVERY UNLESS AUTHORIZED BY THE ARCHITECT SHALL BE DONE AT THE CONTRACTOR'S RISK.
- DETAILS ARE INTENDED TO SHOW METHOD AND MANNER OF ACCOMPLISHING THE WORK. MINOR MODIFICATIONS MAY BE REQUIRED TO SUIT THE OVERALL DIMENSIONS OR CONDITIONS AND SHALL BE INCLUDED AS PART OF THE WORK.
- DETAILS ON DRAWINGS SHALL TAKE PRECEDENCE OVER GENERAL NOTES AND TYPICAL DETAILS. SPECIFIC NOTES ON DETAILS APPLY TO SIMILAR CONDITIONS UNLESS SPECIFICALLY NOTED OTHERWISE.
- THE CONTRACTOR SHALL PROVIDE AND COORDINATE THE EXACT DIMENSIONS, SIZES AND POSITIONS OF ALL EQUIPMENT, MOUNTINGS, ATTACHMENTS AND CONDUIT RELATING TO THE WORK.
- THE CONTRACTOR SHALL PROVIDE AND COORDINATE THE EXACT DIMENSIONS, SIZES AND POSITIONS OF OPENINGS IN SLABS AND WALLS NECESSARY TO THE INSTALLATION OF THE WORK.
- THE CONTRACTOR SHALL CONNECT ALL SERVICES TO EXISTING UTILITIES. ALL UTILITIES SHALL BE CONNECTED TO PROVIDE ELECTRICITY, WATER, GAS, ETC. TO ALL EQUIPMENT SHOWN AS PART OF THIS CONTRACT. ALL EQUIPMENT SHALL FUNCTION CORRECTLY UPON COMPLETION OF THE CONTRACT.
- THE CONTRACTOR SHALL PROVIDE TEMPORARY SERVICE CONNECTIONS.
- THE CONTRACTOR SHALL PROVIDE MOUNTING PLATES BEHIND ALL WALL MOUNTED ITEMS SUCH AS HANDRAILS, TOILET PARTITIONS, LIGHT FIXTURES, MEP EQUIPMENT, ETC.
- ALL DISSIMILAR METALS SHALL BE EFFECTIVELY ISOLATED FROM EACH OTHER TO PREVENT DIELECTRIC ACTION.
- LEGAL EXITS SHALL BE ACCESSIBLE AT ALL TIMES. WHERE AISLES MAY OCCUR LEADING TO EXITS, THEY SHALL HAVE A CLEAR WIDTH AS SHOWN ON THE DRAWINGS BUT IN NO CASE LESS THAN 3'-8" MINIMUM CLEARANCE.
- DISCREPANCIES BETWEEN PLANS AND SPECIFICATIONS, LARGE AND SMALL DETAILS OR VARIOUS SECTIONS OF THE DRAWINGS, SHALL BE IMMEDIATELY BROUGHT TO THE ATTENTION OF THE ARCHITECT FOR RESOLUTION.
- ITEMS OF EXISTING WORK, INDICATED TO REMAIN UPON COMPLETION OF THE CONTRACT, BUT WHICH REQUIRE REMOVAL TO COMPLETE THE WORK, SHALL BE CAREFULLY REMOVED AND REPLACED UPON COMPLETION. THE REPLACED WORK SHALL MATCH ITS CONDITION AT THE START OF THE WORK UNLESS OTHERWISE REQUIRED BY THE DRAWINGS.
- CHANGES IN PLANS AND SPECIFICATIONS, OTHER THAN THOSE NECESSARY FOR CORRECTIONS MADE AFTER SUBMISSION FOR AGENCY APPROVAL SHALL BE BROUGHT TO THE ATTENTION OF THE ARCHITECT IN WRITING.
- CHANGES TO THE APPROVED DRAWINGS AND SPECIFICATIONS SHALL BE MADE BY AN ADDENDA OR CHANGE ORDER APPROVED BY HCAI, AS REQUIRED BY TITLE 24, CCR.
- A PROJECT INSPECTOR EMPLOYED BY THE OWNER SHALL PROVIDE CONTINUOUS INSPECTION OF THIS WORK. THE DUTIES OF THE INSPECTOR ARE DEFINED IN PART I, TITLE 24, CCR.
- THE INTENT OF THE DRAWINGS AND SPECIFICATIONS IS TO RECONSTRUCT THE HOSPITAL BUILDING IN ACCORDANCE WITH CALIFORNIA CODE OF REGULATIONS TITLE 24. SHOULD ANY CONDITION DEVELOP NOT COVERED BY THE CONTRACT DOCUMENTS WHEREIN THE FINISHED WORK WILL NOT COMPLY WITH SAID CALIFORNIA CODE OF REGULATIONS TITLE 24, A CHANGE ORDER DETAILING AND SPECIFYING THE REQUIRED WORK SHALL BE SUBMITTED TO AND APPROVED BY HCAI BEFORE PROCEEDING WITH THE WORK. CCR TITLE 24, PART I, SECTION 1125(b)(2).
- NOTIFY THE HCAI DISTRICT STRUCTURAL ENGINEER PRIOR TO THE START OF CONSTRUCTION WORK. THE DUTIES OF THE INSPECTOR ARE DEFINED IN PART I, TITLE 24, CCR.
- THE SIZES, LOCATION FOR MOUNTINGS AND ATTACHMENTS AND LOCATIONS OF UTILITY CONNECTIONS FOR EACH ITEM OF EQUIPMENT SHOWN ON THE DRAWINGS ARE FOR ILLUSTRATION ONLY. ALL CAN VARY FROM MANUFACTURER TO MANUFACTURER AND ARE DEPENDENT ON THE EXACT MANUFACTURERS MODEL FURNISHED. THE CONTRACTOR SHALL PROVIDE AND COORDINATE EXACT DIMENSIONS RELATING TO THE SIZE OF EACH ITEM OF EQUIPMENT, THE LOCATIONS OF ALL MOUNTINGS AND ATTACHMENTS FOR EACH ITEM OF EQUIPMENT AND FOR ALL UTILITY CONNECTIONS TO EACH ITEM OF EQUIPMENT.
- THE CONTRACTOR SHALL PROVIDE AND COORDINATE THE EXACT DIMENSIONS, SIZES AND POSITIONS OF ALL OPENINGS IN FLOOR AND WALL CONSTRUCTION NECESSARY FOR THE INSTALLATION OF THE WORK.

### FIRE PROTECTION - LIFE SAFETY

- ALL FIRE RESISTIVE ASSEMBLIES FOR PROTECTION OF OPENINGS SHALL BE PROVIDED AND INSTALLED IN ACCORDANCE WITH THE CALIFORNIA BUILDING CODE.
- ALL VOIDS AND PENETRATIONS IN CEILINGS OR WALLS, INCLUDING RECESSED LIGHTS, MECHANICAL DUCTS, ACCESS OPENINGS, ETC., SHALL BE RATED AS REQUIRED BY CODE.
- PROVIDE FIRE EXTINGUISHERS AND CABINETS AND PORTABLE FIRE EXTINGUISHERS WITHIN 75 FEET TRAVEL DISTANCE TO ALL PORTIONS OF THE BUILDING ON EACH FLOOR AND AT ALL MECHANICAL AND ELECTRICAL ROOMS AND AS DIRECTED BY THE FIRE MARSHALL. [SEE 906.3 SIZE & DISTRIBUTION]. TYPE OF FIRE EXTINGUISHER SHALL BE [2-A; 10-B; C], TABLE 906.3(1).
- THE FACILITY MUST MAINTAIN ITS REGULAR SERVICES, INCLUDING EXITS, DURING THE PERIOD THIS WORK IS IN PROGRESS.
- FIRE RATED SEPARATIONS SHALL BE MAINTAINED DURING CONSTRUCTION AND DEMOLITION, PER CFC SECTION 9301 (MEET REQUIREMENTS OF HCAI CAN 9-3301).

THE USE OF VISQUEEN OR SIMILAR TYPE OF MATERIAL AS A TEMPORARY CONSTRUCTION BARRIER WHERE A FIRE SEPARATION IS REQUIRED SHALL NOT BE PERMITTED. A TEMPORARY BARRIER SHALL MEET THE SAME FIRE RATINGS AS WOULD THE PERMANENT PARTITION.

WHERE A TEMPORARY PARTITION IS PLACED ACROSS A CORRIDOR OR IN ANY WAY BLOCKS AN EXIT OR CREATES A DEAD END, APPROVED PLANS SHOWING THESE CONDITIONS SHALL BE APPROVED BY HCAI FIRE MARSHAL AND A REPRESENTATIVE OF THE LOCAL FIRE DEPARTMENT.

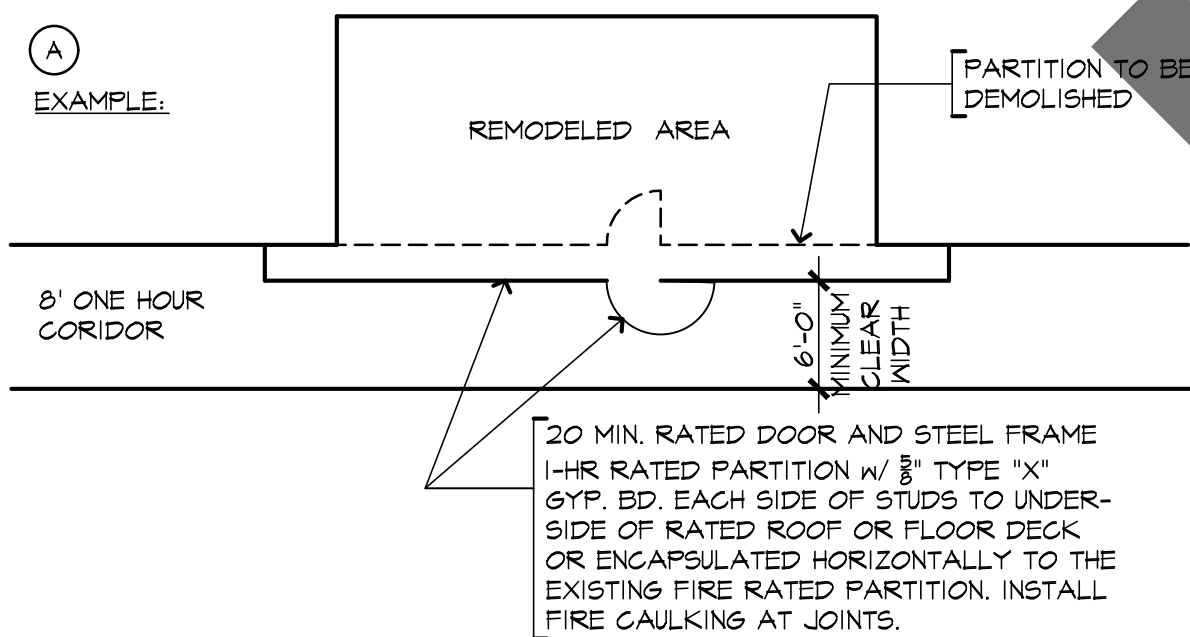

- DURING CONSTRUCTION, A FIRE MATCH WILL BE REQUIRED IF ANY REQUIRED FIRE RATED SEPARATOR IS NOT IN FULL COMPLIANCE WITH THE GOVERNING LOCAL AND STATE REGULATIONS.
28. INTERIOR WALL AND CEILING FINISH MATERIALS SHALL BE CLASSIFIED IN ACCORDANCE WITH ASTM E 84 OR UL T29. SUCH INTERIOR FINISH MATERIALS SHALL BE GROUPED IN THE FOLLOWING CLASSES IN ACCORDANCE WITH THEIR FLAME SPREAD AND SMOKE-DEVELOPED INDEXES. PER CFC SECTION 809.1.2.
- |          |                            |                             |
|----------|----------------------------|-----------------------------|
| CLASS A: | FLAME SPREAD INDEX: 0-25   | SMOKE DEVELOPED INDEX 0-450 |
| CLASS B: | FLAME SPREAD INDEX: 26-75  | SMOKE DEVELOPED INDEX 0-450 |
| CLASS C: | FLAME SPREAD INDEX: 76-200 | SMOKE DEVELOPED INDEX 0-450 |

### FIRE SAFETY DURING CONSTRUCTION, ALTERATION AND DEMOLITION FOR NEW CONSTRUCTION AND ADDITIONS

- FIRE DEPARTMENT ACCESS ROADS SHALL BE ESTABLISHED AND MAINTAINED.
- FIRE EXTINGUISHERS SHALL BE PROVIDED FOR BUILDINGS UNDER CONSTRUCTION AS REQUIRED BY THE HCAI FIRE MARSHAL AND THE LOCAL FIRE AUTHORITY.
- COMBUSTIBLE DEBRIS SHALL NOT BE ALLOWED TO ACCUMULATE WITHIN THE BUILDING.
- ACCESS TO BUILDINGS FOR THE PURPOSE OF FIRE FIGHTING SHALL BE PROVIDED. CONSTRUCTION MATERIAL WILL NOT BLOCK ACCESS TO BUILDINGS, HYDRANTS OR FIRE APPLIANCES.
- CUTTING AND WELDING OPERATIONS SHALL BE IN ACCORDANCE WITH THE GENERAL SAFETY RULES OF CFC SECTION 1056.11, 33.4.6, 350.11 OF THE FIRE CODE.
- EXISTING FIRE PROTECTION SYSTEMS SHALL BE MAINTAINED OPERATIONAL AT ALL TIMES DURING ALTERATIONS AND CONSTRUCTION.
- WHEN TEMPORARY CONSTRUCTION BARRIERS ARE NECESSARY, TEMPORARY EXITS SHALL BE APPROVED BY THE HCAI FIRE MARSHAL AND THE LOCAL FIRE AUTHORITY. SEE DIAGRAM (A) NOTE 27.
- EXISTING FIRE-RESISTIVE ASSEMBLIES AND CONSTRUCTION SHALL BE MAINTAINED.
- PLASTIC FILM WHEN USED FOR DUST PROTECTION SHALL BE FLAME RESISTANT.
- SAFETY PRECAUTIONS INCLUDING FIRE DEPARTMENT ACCESS, WATER SUPPLY, NUMBER AND LOCATIONS OF HYDRANTS AND FIRE EXTINGUISHERS SHALL BE APPROVED BY THE HCAI FIRE MARSHAL AND THE LOCAL FIRE AUTHORITY.
- FIRE PROTECTION OF STRUCTURAL MEMBERS SHALL BE REPAIRED/REPLACED IN ACCORDANCE WITH CALIFORNIA BUILDING CODE.
- FIRE SAFETY DURING WELDING SHALL BE IN ACCORDANCE WITH THE REQUIREMENTS OF THE CALIFORNIA FIRE CODE.

REPAIR AND WELDING PROCEDURES SHALL BE REVIEWED AND APPROVED BY THE HCAI FIRE MARSHAL AND LOCAL FIRE AUTHORITY HAVING JURISDICTION IN ACCORDANCE WITH CALIFORNIA FIRE CODE. SUCH REVIEW SHALL INCLUDE BUT NOT NECESSARILY BE LIMITED TO:

- METHOD AND LOCATION OF CYLINDER STORAGE
- USE AND LOCATION OF ELECTRICAL GENERATORS AND ASSOCIATED FUEL SUPPLY
- PROVISION OF FRESH AIR SUPPLY AND EXHAUST SYSTEMS
- PROVISION OF NONCOMBUSTIBLE SHIELDS
- FIRE WATCH PROCEDURES
- SCHEDULING OF WORK PROCEDURES FOR NOTIFYING FIRE DEPARTMENT OF WHERE AND WHEN WELDING IS SCHEDULED.

- FIRE SPRINKLER, STANDPIPE AND FIRE ALARM SYSTEMS SHALL BE MAINTAINED OPERATIONAL AT ALL TIMES. WHEN IT IS NECESSARY TO SHUT DOWN A SYSTEM OR A PORTION OF A SYSTEM, A FIRE MATCH SHALL BE PROVIDED PER THE CALIFORNIA FIRE CODE.
- "THROUGH PENETRATION FIRE STOP SYSTEM": PENETRATION THROUGH FIRE-RATED FLOORS AND WALLS SHALL BE PROVIDED IN ACCORDANCE WITH CFC SECTIONS 714.4 SYSTEMS SHALL BE INSTALLED IN ACCORDANCE WITH MANUFACTURER'S INSTALLATION INSTRUCTIONS. MANUFACTURER'S INSTALLATION INSTRUCTIONS SHALL BE PROVIDED FOR REVIEW BY INSPECTION AUTHORITIES. SUBSTITUTIONS OF OR REVISIONS OR ADDITIONS TO APPROVED SYSTEMS SHALL BE SUBMITTED TO THE INSPECTOR OF RECORD AND THE HCAI FIRE MARSHAL FOR FIELD REVIEW AND APPROVAL.
- ALL WOOD USED FOR BLOCKING, NAILERS AND/OR FRAMING USED FOR PERMANENT CONSTRUCTION SHALL BE FIRE RETARDANT PRESURE TREATED AND SHALL BEAR AN APPROVED INSPECTION AGENCY LABEL.
- THROUGH-PENETRATIONS AND MEMBRANE PENETRATIONS SHALL BE PROTECTED BY AN APPROVED PENETRATION FIRESTOP SYSTEM OR MEMBRANE PENETRATION FIRESTOP SYSTEM INSTALLED AS TESTED IN ACCORDANCE WITH ASTM E 84 OR UL 1419, WITH A MINIMUM POSITIVE PRESSURE DIFFERENTIAL OF 0.01 INCH (2.48 PA) OF WATER OR AS OTHERWISE PERMITTED BY 2019 CFC, SECTION 714. LISTED THROUGH-PENETRATION FIRESTOP SYSTEM AND MEMBRANE PENETRATIONS SHALL BE INSTALLED IN ACCORDANCE WITH THE INSTALLATION DETAILS FOR LISTED SYSTEMS. LISTED THROUGH-PENETRATION FIRESTOP SYSTEMS, MEMBRANE PENETRATION PROTECTION AND OTHER PERMITTED MEANS AND METHODS OF PENETRATION PROTECTION SHALL BE SUBMITTED TO OMB/HCAI FIELD FIRE MARSHAL FOR REVIEW AND APPROVAL PRIOR TO INSTALLATION PER 2019 CFC, SECTIONS 107.21 AND 714.

### NOISE AND DUST CONTROL

- THE HOSPITAL IS OPEN 24 HOURS A DAY AND SHALL BE KEPT IN OPERATION THROUGHOUT THE CONSTRUCTION PERIOD. ANY WORK THAT WILL DISRUPT THE MEDICAL OPERATIONS SHALL BE COORDINATED WITH OWNER THROUGH THE OWNER REPRESENTATIVE. NOISY WORK ACTIVITIES CAUSING VIBRATION AND/OR SIMILAR DISRUPTED ACTIONS SHALL BE SCHEDULED AT TIMES ACCEPTABLE TO THE OWNER.
- EXERCISE CAUTION TO PREVENT GENERATION OF UNNECESSARY NOISE LEVELS TO MINIMUM POSSIBLE. DO NOT EXCEED CALIFORNIA STANDARDS AT ANY TIME. DISCONTINUE NOISE PRODUCING OPERATIONS, WHEN REQUESTED BY THE OWNER AND RESCHEDULE AT A MUTUALLY ACCEPTABLE TIME.
- DO NOT USE IMPACT TOOLS, SUCH AS JACK HAMMERS, INSIDE THE BUILDING WHEN IT IS OPENED TO THE PUBLIC.
- MOUNT ROLLING EQUIPMENT ON PNEUMATIC TIRES.
- EQUIP INTERNAL COMBUSTION ENGINES WITH SUITABLE MUFFLERS. DO NOT USE INTERNAL COMBUSTION ENGINES IN ENCLOSED SPACES, INCLUDING THE BUILDING, WITHOUT THE OWNER'S WRITTEN APPROVAL.
- ALL DUST, NOISE AND ODORS SHALL BE CONTROLLED PER OWNER'S REQUIREMENTS. ANY WORK THAT WILL DISRUPT THE MEDICAL OPERATIONS SHALL BE COORDINATED WITH OWNER THROUGH THE OWNER REPRESENTATIVE.
- THE PROJECT AREA SHALL BE ISOLATED FROM ADJACENT OCCUPIED SPACES DURING CONSTRUCTION USING BARRIERS, AIR DISTRIBUTION AND MATERIAL HANDLING.
- BARRIERS SHALL BE TIGHTLY SEALED WITH TAPE FROM WALL, FLOOR TO STRUCTURE ABOVE OR ACUSTICAL CEILING WHERE SUSPENDED CEILING WILL NOT BE DISTURBED.
- THE ARCHITECT ASSUMES NO RESPONSIBILITY RELATING TO ANY HAZARDOUS OR TOXIC MATERIALS, INCLUDING ASBESTOS, AND ASSUMES NO RESPONSIBILITY FOR ITS EXISTENCE OR REMOVAL. THE OWNER SHALL TAKE ACTION FOR DIRECTLY CONTACTING WITH A CONSULTANT OR SPECIALIST FOR SUCH LICENSED BY THE STATE OF CALIFORNIA. SHOULD THOSE SERVICES BE REQUIRED ON THE PROJECT.
- NO PRODUCTS CONTAINING ASBESTOS IN ANY FORM SHALL BE USED ON ANY PART OF THE WORK.

### INFECTION CONTROL REQUIREMENTS

- INFECTION CONTROL IS CRITICAL IN ALL AREAS OF ALL FACILITIES. CONSTRUCTION ACTIVITIES CAUSING DISTURBANCE OF EXISTING DUST, OR CREATING NEW DUST, MUST BE CONDUCTED IN TIGHT ENCLOSURES CUTTING OFF ANY FLOW OF PARTICLES INTO PATIENT AREAS.
- THE HOSPITAL REQUIRES THAT ANY SUBCONTRACTOR, MATERIAL SUPPLIER, VENDOR, EMPLOYEE, OR AGENT BE BOUND BY THESE SAME REQUIREMENTS. BEFORE ANY CONSTRUCTION ON SITE BEGINS, THE CONTRACTOR'S ON-SITE MANAGEMENT TEAM SHALL ATTEND A MANDATORY MEETING HELD BY THE HOSPITAL'S REPRESENTATIVES FOR INSTRUCTION ON PRECAUTIONS TO BE TAKEN.
- THE CONSTRUCTION SITE SHALL BE MAINTAINED UNDER NEGATIVE PRESSURE AT ALL TIMES AND A GAUGE SCALE AT THE BARRICADE ENTRANCE SHALL READ 0.01 INCH W.G. HEPA EQUIPPED AIR FILTRATION MACHINES SHALL BE CONNECTED TO EMERGENCY POWER IF AVAILABLE, AND SHALL RUN CONTINUOUSLY FOR THE DURATION OF THE PROJECT. THE AIR FILTRATION (NEGATIVE PRESSURE) EQUIPMENT SHALL BE EXHAUSTED TO THE EXTERIOR OF THE BUILDING WHENEVER POSSIBLE AND ONLY AFTER ALL OPTIONS HAVE BEEN CONSIDERED OF EXHAUSTING TO THE OUTSIDE SHALL THERE BE THE RECIRCULATION OF THE HEPA FILTRATED AIR WITHIN THE INTERIOR OF THE SPACE.
- THE HOSPITAL'S PLANT MANAGER, SAFETY OFFICER, INFECTION CONTROL NURSE, FACILITIES DEPARTMENT, OR PLANT MANAGER'S DESIGNEE MAY MODIFY PERFORMANCE REQUIREMENTS FOR CERTAIN ACTIVITIES. FACILITIES, ENGINEERING AND INFECTION CONTROL MUST REVIEW ANY MODIFICATIONS MADE BY THE CONTRACTOR. ANY MODIFICATIONS MADE BY THE CONTRACTOR DOES NOT RELIEVE THE CONTRACTOR OF COMPLIANCE WITH PROPER INFECTION CONTROL PROCEDURES.
- THE CONTRACTOR WILL SUBMIT A WRITTEN REPORT OF INFECTION CONTROL PROCEDURES PRIOR TO STARTING ANY WORK. THIS REPORT WILL INCLUDE THE LOCATION AND DETAILS OF BARRIERS, AND THE MEANS IN WHICH THEY PLAN TO OBTAIN THE NEGATIVE PRESSURIZATION.
- THE CONTRACTOR WILL SUBMIT PRODUCT DATA FOR PRODUCTS USED IN INFECTION CONTROL PROGRAM ONLY PRODUCTS APPROVED BY THE HOSPITAL'S INFECTION CONTROL COMMITTEE SHALL BE USED. IT IS THE CONTRACTOR'S RESPONSIBILITY TO HAVE MSDS SHEETS ON ALL PRODUCTS USED. COPIES OF MSDS MUST BE PROVIDED TO THE SAFETY OFFICER.
- THE HOSPITAL'S INFECTION CONTROL DEPARTMENT IN COLLABORATION WITH ENGINEERING DEPARTMENT AND SAFETY OFFICER WILL MONITOR INDOOR AIR QUALITY (PARTICULATE AND BIOLOGICALS) IN THE VICINITY OF CONSTRUCTION WORK AT THE BEGINNING, END, AND/OR AS NEEDED. PROJECTS WILL BE EVALUATED TO DETERMINE THE NEED TO CONDUCT INDOOR AIR SAMPLING. WHENEVER SAFE LEVELS ARE EXCEEDED, THE CONTRACTOR WILL BE NOTIFIED IMMEDIATELY FOR CORRECTIVE ACTIONS.
- AN INFECTION CONTROL PERMIT IS REQUIRED FOR THIS PROJECT. THE INFECTION CONTROL CONSTRUCTION PERMIT FORM WILL BE OBTAINED FROM THE HOSPITAL'S INFECTION CONTROL DEPARTMENT AND/OR ENGINEERING DEPARTMENT AND COMPLETED BY THE CONSTRUCTION COMPANY. RCH INFECTION CONTROL AND/OR DESIGNED MUST SIGN THE COMPLETED PERMIT PRIOR TO BEGINNING ANY DEMOLITION, RENOVATION OR CONSTRUCTION WORK. THE PERMIT SHALL BE DISPLAYED AT ENTRANCE TO WORK AREA DURING ENTIRE CONSTRUCTION PERIOD.
- COMPLETE ALL CRITICAL BARRIERS OR IMPLEMENT CONTROL CUBE METHOD BEFORE CONSTRUCTION BEGINS.
- SEAL HOLES, FIRES, CONDUITS, AND FRACTURES APPROPRIATELY.
- VACUUM WORK AREA WITH HEPA FILTERED VACUUMS.
- WET MOP AREA WITH DISINFECTANT (QUATERNARY AMMONIUM).
- REMOVE BARRIER MATERIAL CAREFULLY TO MINIMIZE SPREADING OF DIRT AND DEBRIS ASSOCIATED WITH CONSTRUCTION.
- CONTAIN CONSTRUCTION WASTE BEFORE TRANSPORT IN TIGHTLY COVERED CONTAINERS.
- COVER TRANSPORT RECEPTACLE OR CARTS W/PE DOWN CART PRIOR TO LEAVING THE CONSTRUCTION AREA.

### GENERAL CONSTRUCTION NOTES

- PRIOR TO CONSTRUCTION STARTING HCAI FIELD FIRE MARSHAL AND LOCAL FIRE AUTHORITY SHALL REVIEW AND APPROVE THE MEANS OF EGRESS AND HOW IT WILL BE MAINTAINED DURING CONSTRUCTION IN THE EXIT ACCESS CORRIDOR. PER 2019 C.F.C. SECTION 931.2 AND CAN 9-3301.
- DEMOLITION AND RECONSTRUCTION WILL OCCUR WITHIN ONE SINGLE 8-HOUR SHIFT, SUBJECT TO THE PRIOR REVIEW AND APPROVAL OF THIS APPROACH BY THE HCAI FIELD FIRE MARSHAL. WORK MAY NOT PROCEED UNTIL THAT APPROVAL HAS BEEN OBTAINED. IN THE EVENT THE WORK CANNOT BE COMPLETED IN THAT SINGLE SHIFT, A RATED TEMPORARY BARRIER OF THE SAME FIRE-RESISTANCE RATING OF THE WALL SHALL BE PROVIDED. PER 2019 C.F.C. SECTION 709.1 AND CAN 9-3301.
- WHERE A REQUIRED FIRE PROTECTION SYSTEM IS OUT OF SERVICE THE LOCAL FIRE JURISDICTION AND HCAI SHALL BE NOTIFIED. A FIRE MATCH SHALL BE PROVIDED UNTIL THE SYSTEM IS OPERABLE. WHEN A FIRE MATCH IS REQUIRED PERSONNEL SHALL BE PROVIDED WITH AN APPROVED MEANS FOR NOTIFYING THE FIRE DEPARTMENT AND THE ONLY DUTY OF THE FIRE WATCH PERSONNEL IS TO WATCH FOR THE OCCURRENCE OF FIRE. PER 2019 C.F.C. SECTIONS 901.7 & 9304.5 AND CAN 9-1404.5.

**1910A.5 TESTS FOR POST-INSTALLED ANCHORS IN CONCRETE.** WHEN POST-INSTALLED ANCHORS ARE USED IN LIEU OF CAST-IN PLACE BOLTS, THE INSTALLATION VERIFICATION TEST LOADS, FREQUENCY, AND ACCEPTANCE CRITERIA SHALL BE IN ACCORDANCE WITH THIS SECTION.

**1910A.5.1 GENERAL.** TEST LOADS OR TORQUES AND ACCEPTANCE CRITERIA SHALL BE SHOWN ON THE CONSTRUCTION DOCUMENTS.

IF ANY ANCHOR FAILS TESTING, ALL ANCHORS OF THE SAME TYPE SHALL BE TESTED, WHICH ARE INSTALLED BY THE SAME TRADE, NOT PREVIOUSLY TESTED UNTIL TWENTY (20) CONSECUTIVE ANCHORS PASS, THEN RESUME THE INITIAL TEST FREQUENCY.

**1910A.5.2 TESTING PROCEDURE.** TEST PROCEDURE SHALL BE AS PERMITTED BY AN APPROVED TEST REPORT USING CRITERIA ADOPTED IN THIS CODE. ALL POST-INSTALLED ANCHORS SHALL BE TENSIONED TESTED.

EXCEPTION:  
TORQUE CONTROLLED POST-INSTALLED ANCHORS SHALL BE PERMITTED TO BE TESTED USING TORQUE BASED ON APPROVED TEST REPORT USING CRITERIA ADOPTED IN THIS CODE.

ALTERNATIVELY, MANUFACTURER'S RECOMMENDATION FOR TESTING MAY BE APPROVED BY THE ENFORCEMENT AGENCY, BASED ON AN APPROVED TEST REPORT USING CRITERIA ADOPTED IN THIS CODE.

**1910A.5.3 TEST FREQUENCY.** WHEN POST-INSTALLED ANCHORS ARE USED FOR SILL PLATE BOLTING APPLICATIONS, 10 PERCENT OF THE ANCHORS SHALL BE TESTED.

WHEN POST-INSTALLED ANCHORS ARE USED FOR OTHER STRUCTURAL APPLICATIONS, ALL SUCH ANCHORS SHALL BE TESTED.

WHEN POST-INSTALLED ANCHORS ARE USED FOR NONSTRUCTURAL APPLICATIONS SUCH AS EQUIPMENT ANCHORAGE, 50 PERCENT OR ALTERNATE BOLTS IN A GROUP, INCLUDING AT LEAST ONE-HALF THE ANCHORS IN EACH GROUP, SHALL BE TESTED.

THE TESTING OF THE POST-INSTALLED ANCHORS SHALL BE DONE IN THE PRESENCE OF THE SPECIAL INSPECTOR AND A REPORT OF THE TEST RESULTS SHALL BE SUBMITTED TO THE ENFORCEMENT AGENCY.

#### EXCEPTIONS:

- UNDERCUT ANCHORS THAT ALLOW VISUAL CONFIRMATION OF FULL SET SHALL NOT REQUIRE TESTING.
- WHERE THE FACTORED DESIGN TENSION ON ANCHORS IS LESS THAN 100 LBS AND THOSE ANCHORS ARE CLEARLY NOTED ON THE APPROVED CONSTRUCTION DOCUMENTS, ONLY 10 PERCENT OF THOSE ANCHORS SHALL BE TESTED.
- WHERE ADHESIVE ANCHOR SYSTEMS ARE USED TO INSTALL REINFORCING DOVEL BARS IN HARDENED CONCRETE, ONLY 25 PERCENT OF THE DOVELS SHALL BE TESTED IF ALL OF THE FOLLOWING CONDITIONS ARE MET:
  - THE DOVELS ARE USED EXCLUSIVELY TO TRANSMIT SHEAR FORCES ACROSS JOINTS BETWEEN EXISTING AND NEW CONCRETE.
  - THE NUMBER OF DOVELS IN ANY ONE MEMBER EQUALS OR EXCEEDS 12.
  - THE DOVELS ARE UNIFORMLY DISTRIBUTED ACROSS SEISMIC FORCE RESISTING MEMBERS (SUCH AS SHEAR WALLS, COLLECTORS AND DIAPHRAGMS). ANCHORS TO BE TESTED SHALL BE SELECTED AT RANDOM BY THE SPECIAL INSPECTOR/INSPECTOR OF RECORD (IOR).
- TESTING OF SHEAR DOVELS ACROSS COLD JOINTS IN SLABS ON GRADE, WHERE THE SLAB IS NOT PART OF THE LATERAL FORCE-RESISTING SYSTEM SHALL NOT BE REQUIRED.
- TESTING IS NOT REQUIRED FOR POWER ACTUATED FASTENERS USED TO ATTACH TRACKS OF INTERIOR NON-SHEAR WALL PARTITIONS FOR SHEAR ONLY, WHERE THERE ARE AT LEAST THREE FASTENERS PER SEGMENT OF TRACK.

**1910A.5.4 TEST LOADS.** REQUIRED TEST LOADS SHALL BE DETERMINED BY ONE OF THE FOLLOWING METHODS:

- TWICE THE MAXIMUM ALLOWABLE TENSION LOAD OR ONE AND A QUARTER (1¼) TIMES THE MAXIMUM DESIGN STRENGTH OF ANCHORS AS PROVIDED IN AN APPROVED EVALUATION REPORT USING CRITERIA ADOPTED IN THIS CODE OR DETERMINED IN ACCORDANCE WITH CHAPTER 17 OF ACI 318.

- TENSION TEST LOAD NEED NOT EXCEED 80 PERCENT OF THE NOMINAL YIELD STRENGTH OF THE ANCHOR ELEMENT (±0.8A so f<sub>y</sub>o).
- THE MANUFACTURER'S RECOMMENDED INSTALLATION TORQUE BASED ON APPROVED TEST REPORT USING CRITERIA ADOPTED IN THIS CODE.

**1910A.5.5 TEST ACCEPTANCE CRITERIA.** ACCEPTANCE CRITERIA FOR POST-INSTALLED ANCHORS SHALL BE BASED ON APPROVED TEST REPORT USING CRITERIA ADOPTED IN THIS CODE. FIELD TEST SHALL SATISFY FOLLOWING MINIMUM REQUIREMENTS.

- HYDRAULIC RAM METHOD:  
ANCHORS TESTED WITH A HYDRAULIC JACK OR SPRING LOADED DEVICES SHALL MAINTAIN THE TEST LOAD FOR A MINIMUM OF 15 SECONDS AND SHALL EXHIBIT NO DISCERNIBLE MOVEMENT DURING THE TENSION TEST, E.G., AS EVIDENCED BY LOOSENING OF THE WASHER UNDER THE NUT.

FOR ADHESIVE ANCHORS, WHERE OTHER THAN BOND IS BEING TESTED, THE TESTING APPARATUS SUPPORT SHALL NOT BE LOCATED WITHIN 1.5 TIMES THE ANCHOR'S EMBEDMENT DEPTH TO AVOID RESTRICTING THE CONCRETE SHEAR CONE TYPE FAILURE MECHANISM FROM OCCURRING.

- TORQUE WRENCH METHOD:  
TORQUE-CONTROLLED POST-INSTALLED ANCHORS TESTED WITH A CALIBRATED TORQUE WRENCH MUST ATTAIN THE SPECIFIED TORQUE WITHIN 1/2 TURN OF THE NUT OR ONE QUARTER (1/4) TURN OF THE NUT FOR A 3/8 INCH SLEEVE ANCHOR ONLY.

PROJECT TITLE  
**STERILIZATION SYSTEM  
INSTALLATION  
FOR THE  
ARROWHEAD REGIONAL  
MEDICAL CENTER**  
400 N. PEPPER AVE.  
COLTON, CA. 92324


WBSE #10.10.1142 - CIP #21-154 - CAFM #COL003

Department of Health Care Access and Information

**HCAI # S222347-36-00**



### REFERENCE PLAN

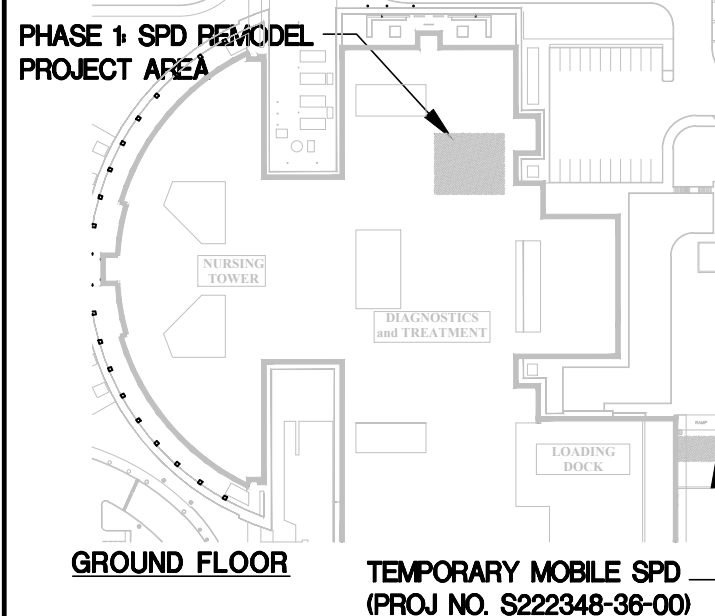


©marks architects, inc. 2022  
ALL REPORTS, PLANS AND DOCUMENTS PREPARED BY MARKS ARCHITECTS, INC. SHALL REMAIN THE PROPERTY OF MARKS ARCHITECTS, INC. AND ARE INTENDED FOR THIS SPECIFIC PROJECT ONLY. OTHER USES ARE PROHIBITED UNLESS OTHERWISE CONTRACTED.

### GENERAL NOTES

DATE  
**DECEMBER 28, 2022**

#### REVISIONS

- |   |                                  |
|---|----------------------------------|
| △ | PLAN CHECK COMMENTS - 02.13.2023 |
| △ | AMC0001 - 06.13.2023             |
| △ | PLAN CHECK COMMENTS - 06.27.2023 |
| △ | PLAN CHECK COMMENTS - 08.15.2023 |
| △ |                                  |
| △ |                                  |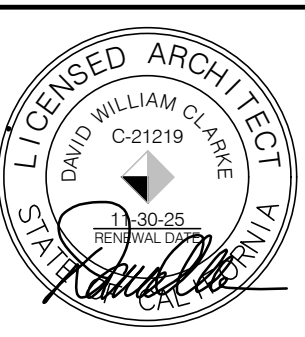
PROJECT NUMBER

**3021027**

DRAWING NUMBER


**T1.2**



S:\Active Projects\County of San Bernardino\On Call Projects\Arrowhead Regional Medical Center\3021027 ARMC - Sterilizer Installation\3021027 A1.1.dwg Oct 16, 2023 - 11:10am

- 1 EXISTING ACCESSIBLE PARKING SPACES.
- 2 EXISTING ACCESSIBLE PATH OF TRAVEL TO ACCESSIBLE BUILDING ENTRANCE.
- 3 EXISTING ACCESSIBLE PRIMARY PATH OF TRAVEL.
- 4 EXISTING ACCESSIBLE ELEVATOR.
- 5 EXISTING ACCESSIBLE PUBLIC TOILET ROOM.
- 6 EXISTING ACCESSIBLE DRINKING FOUNTAIN
- 7 EXISTING ACCESSIBLE PUBLIC TELEPHONES
- 8 EXISTING ACCESSIBLE STAFF TOILET.

KEYNOTES

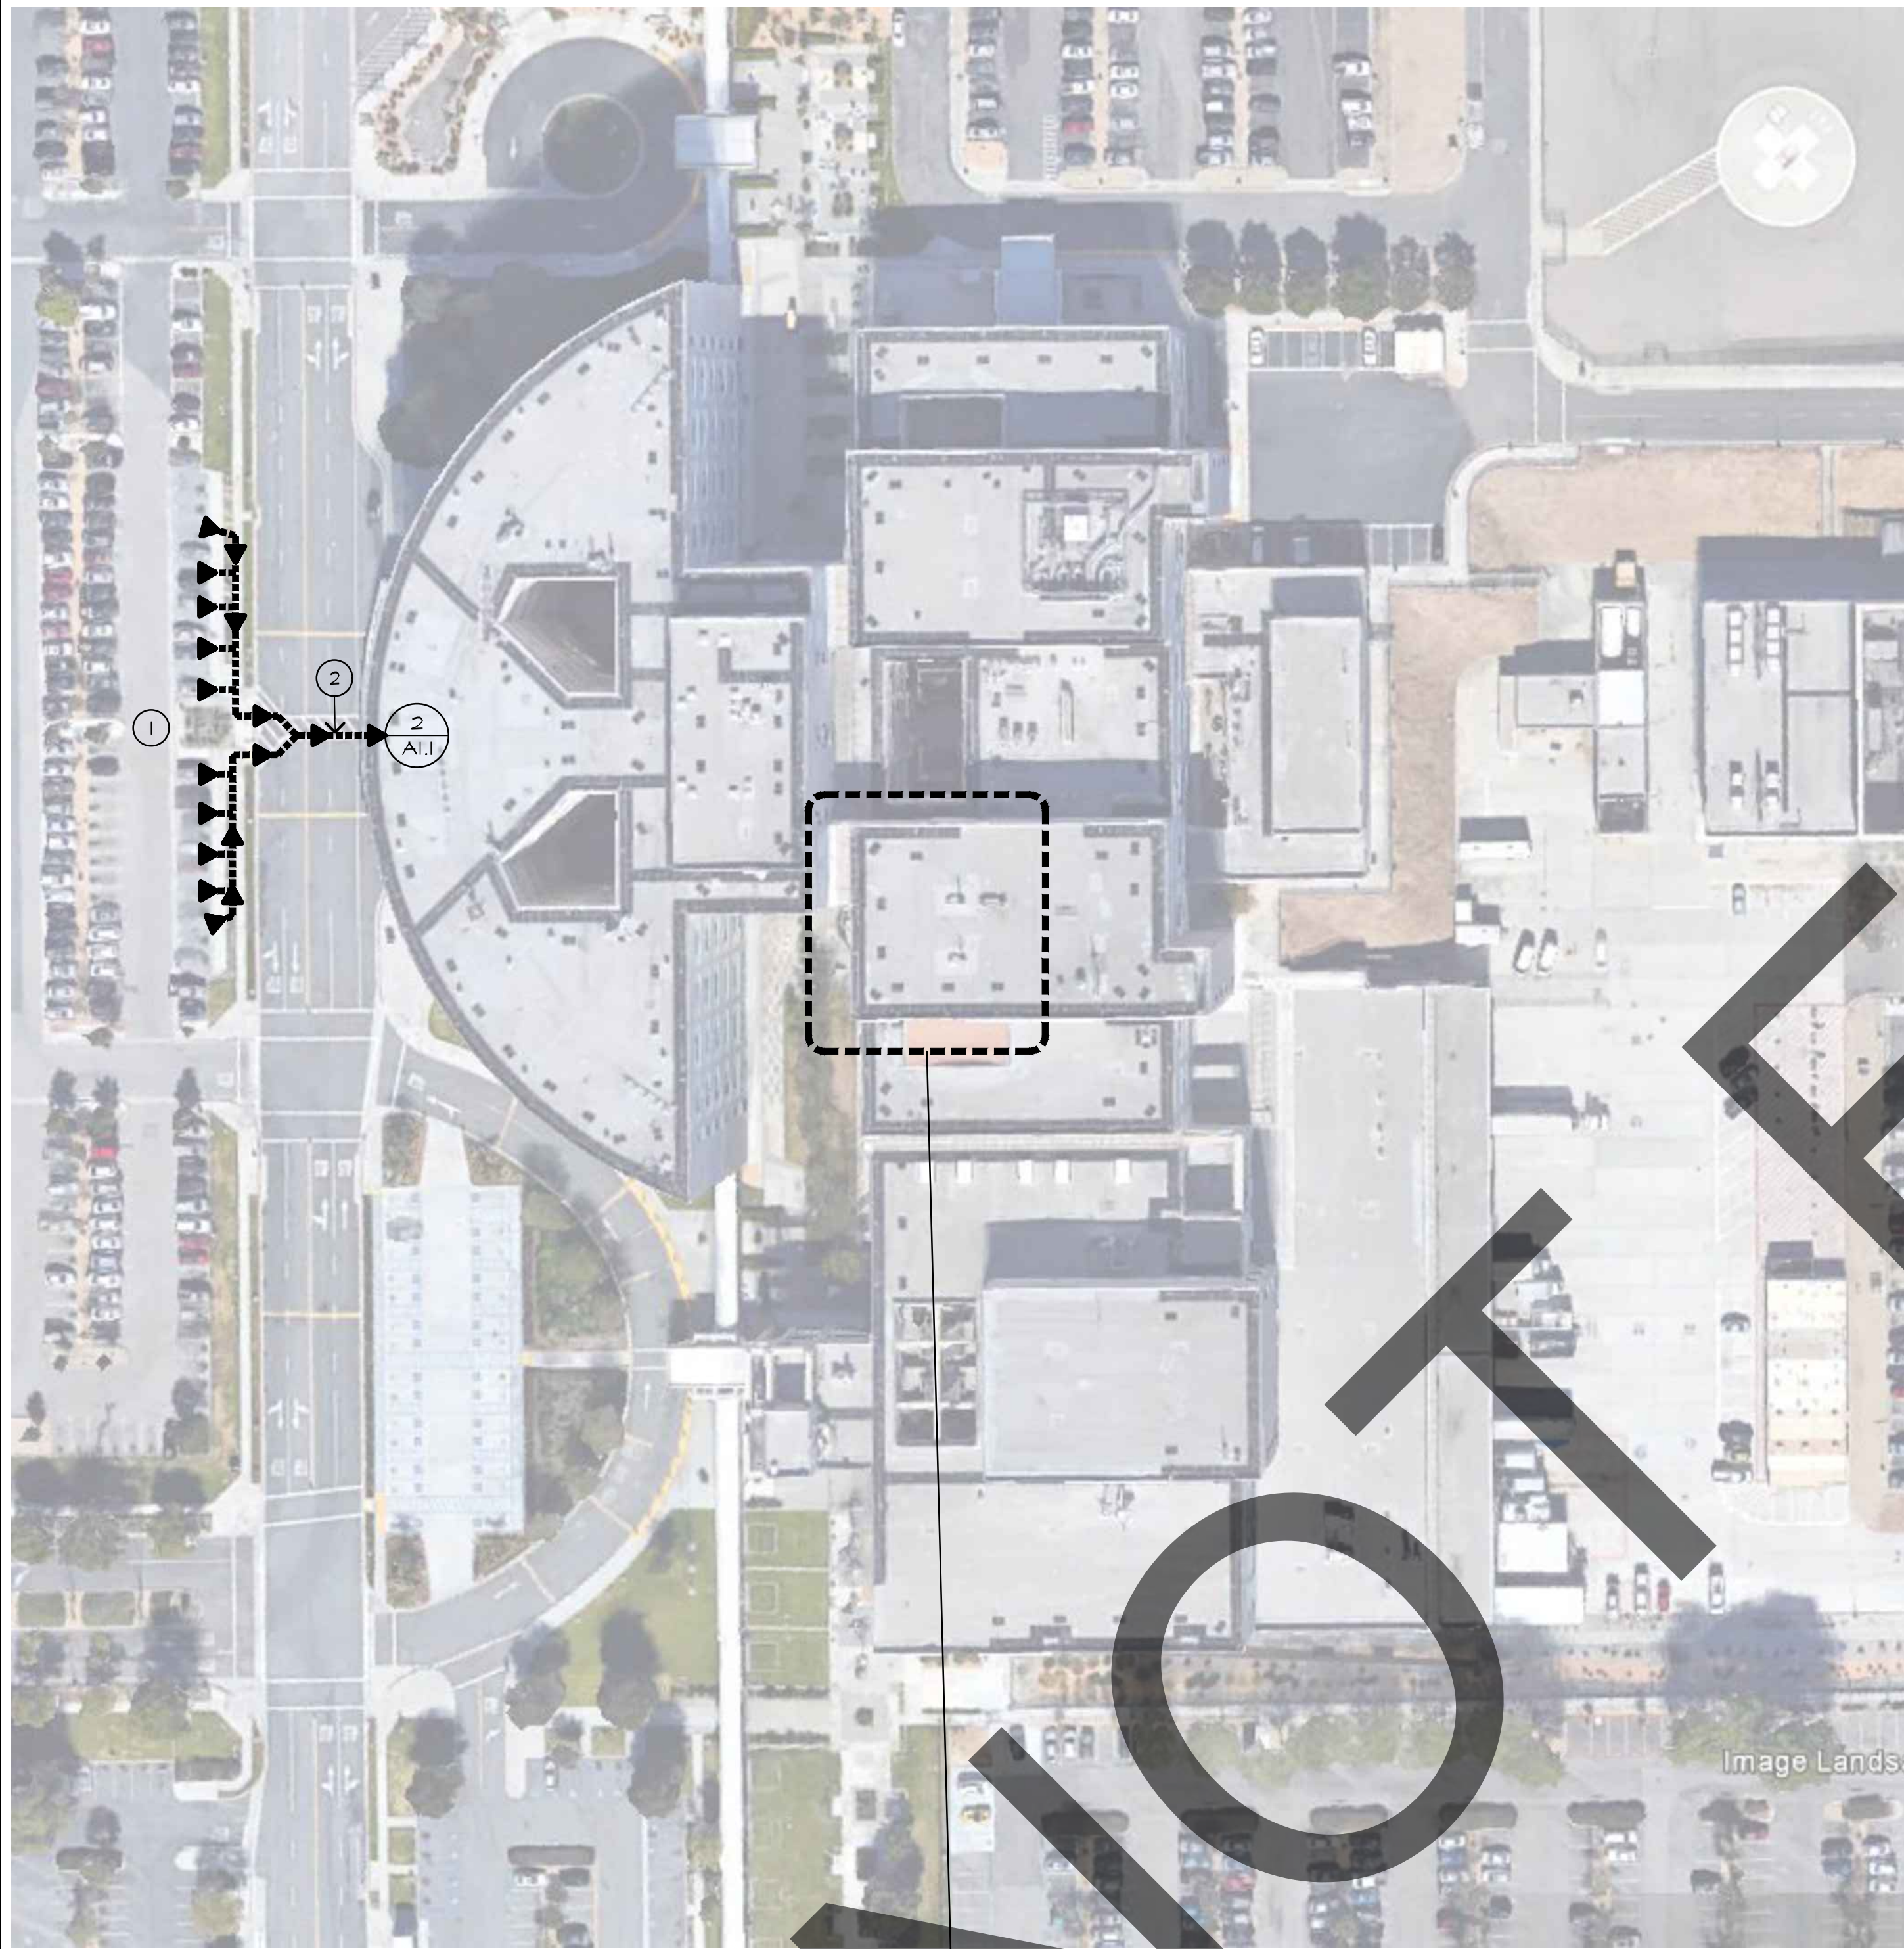


PROJECT LOCATION AT  
GROUND LEVEL 3/A1.1

SITE PLAN - PATH OF TRAVEL

1/8"=80'-0"


1

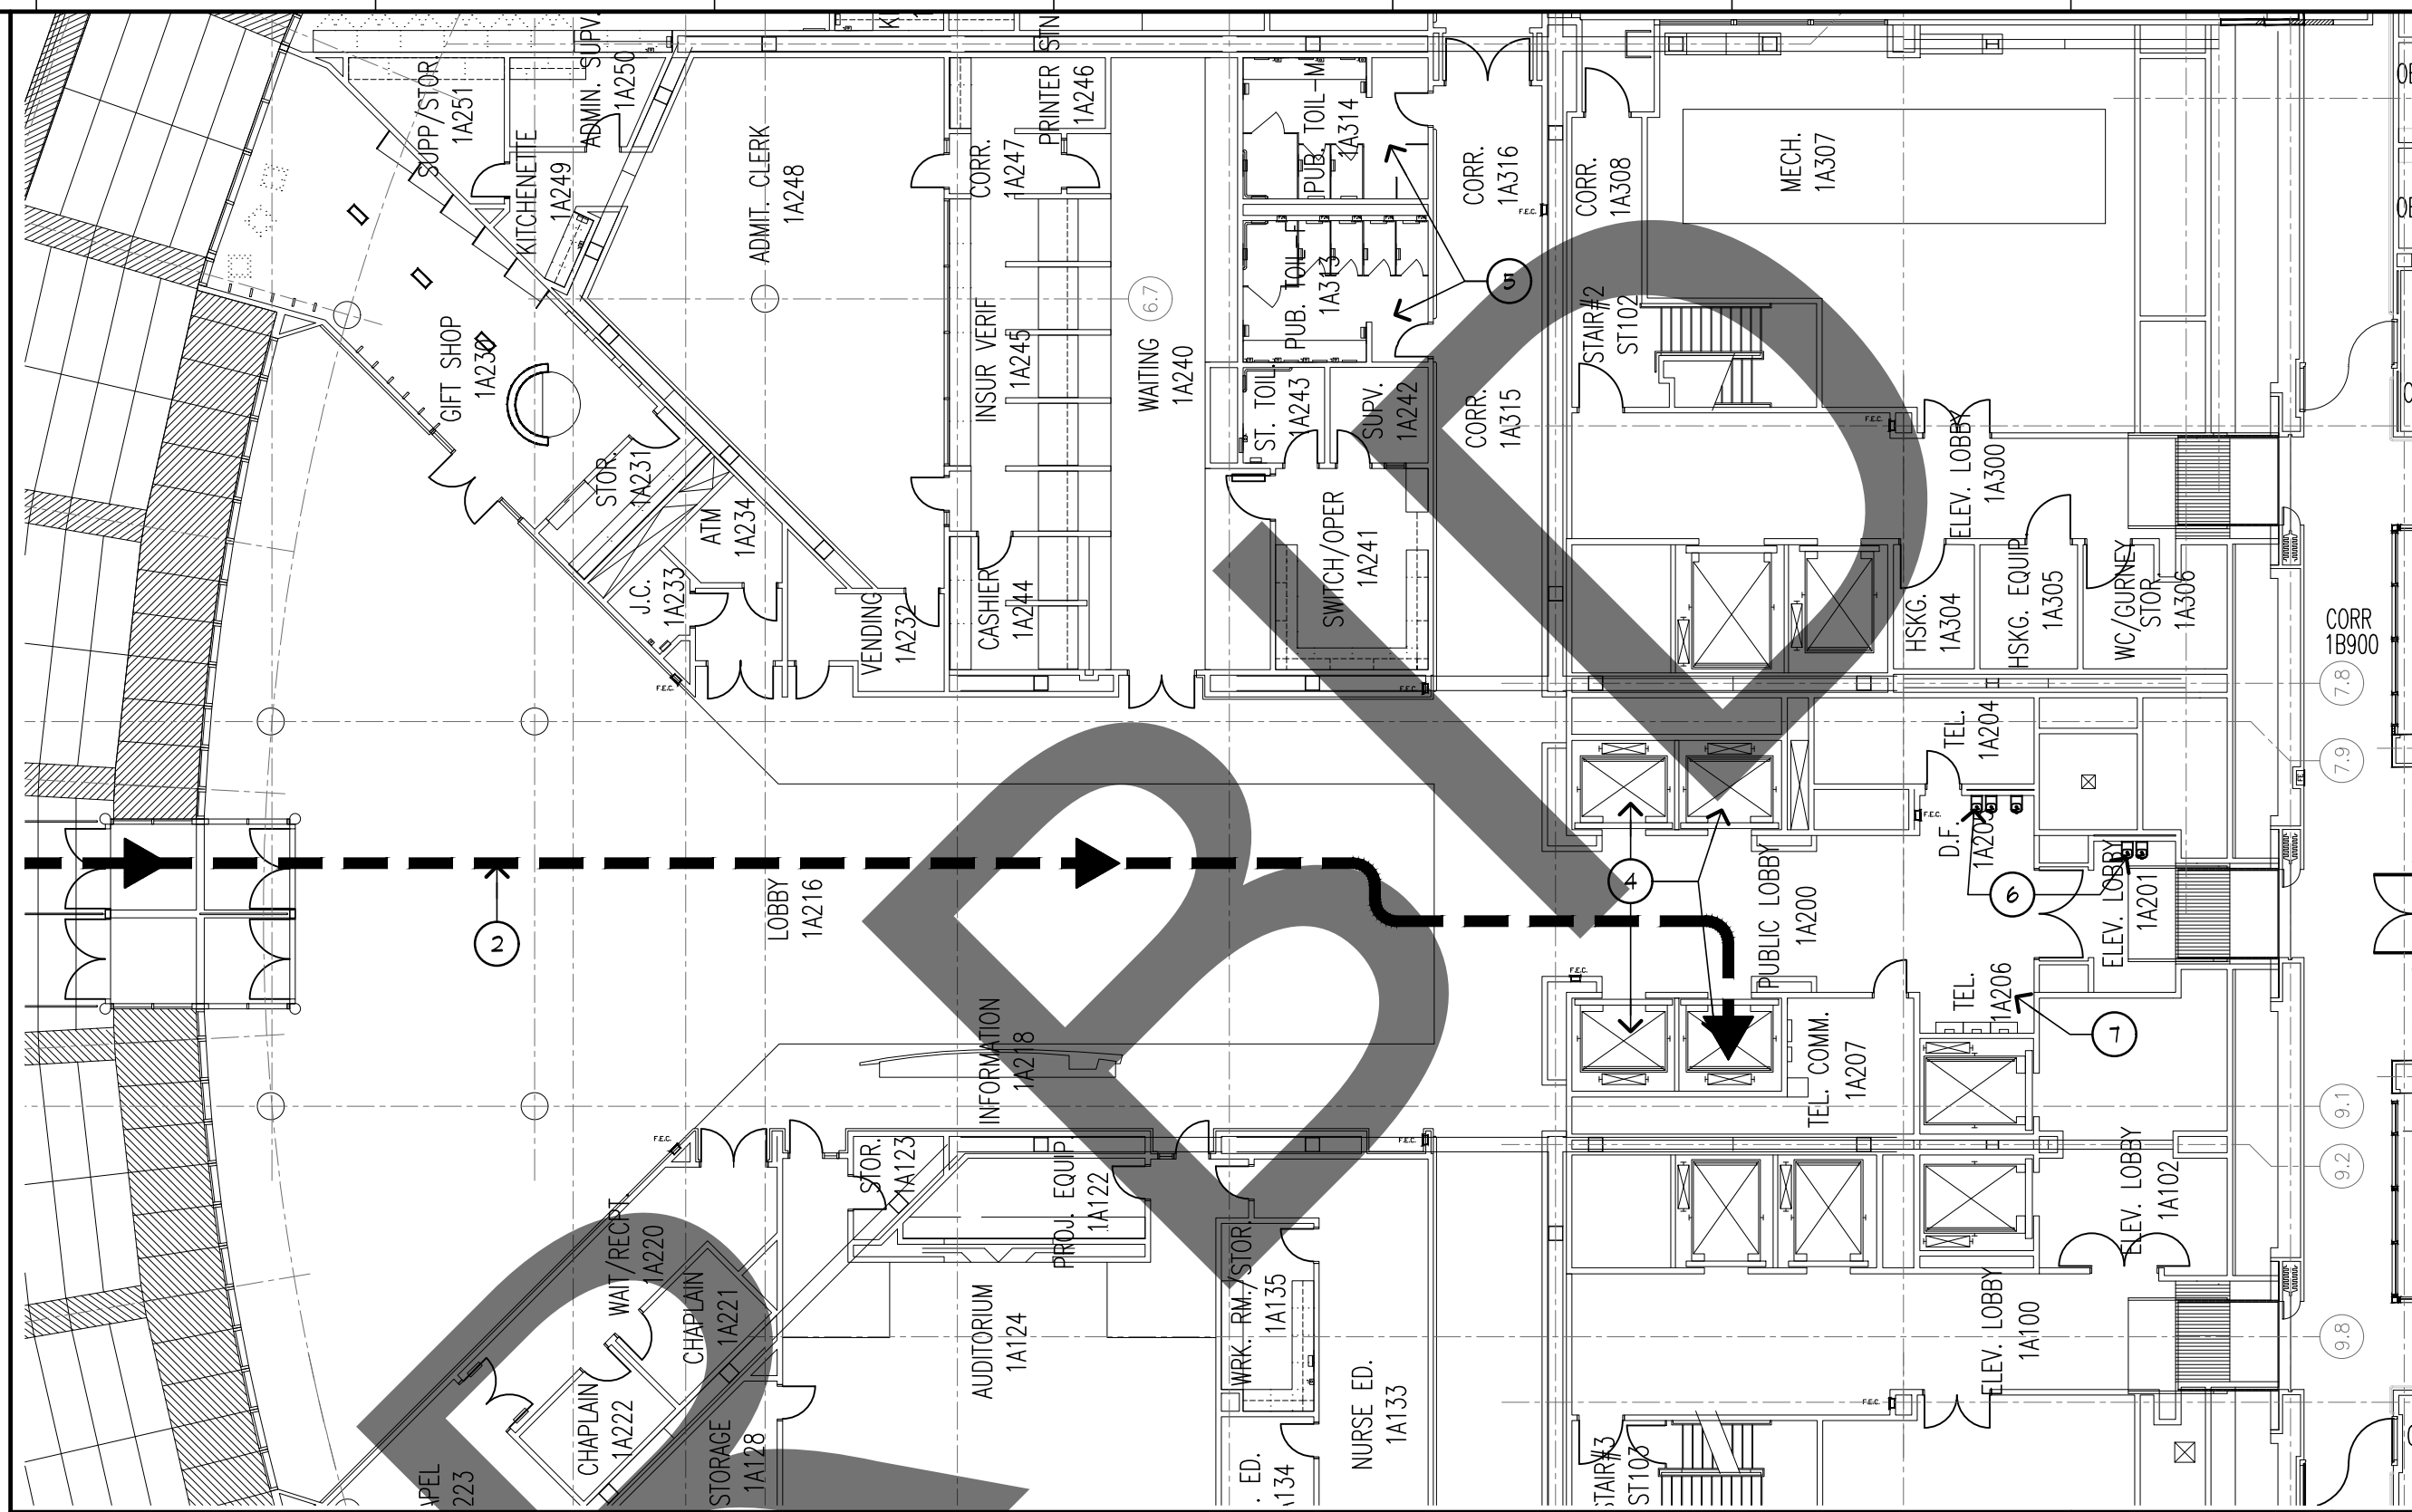

PARTIAL FIRST LEVEL FLOOR PLAN - PATH OF TRAVEL

1/16"=1'-0"

2

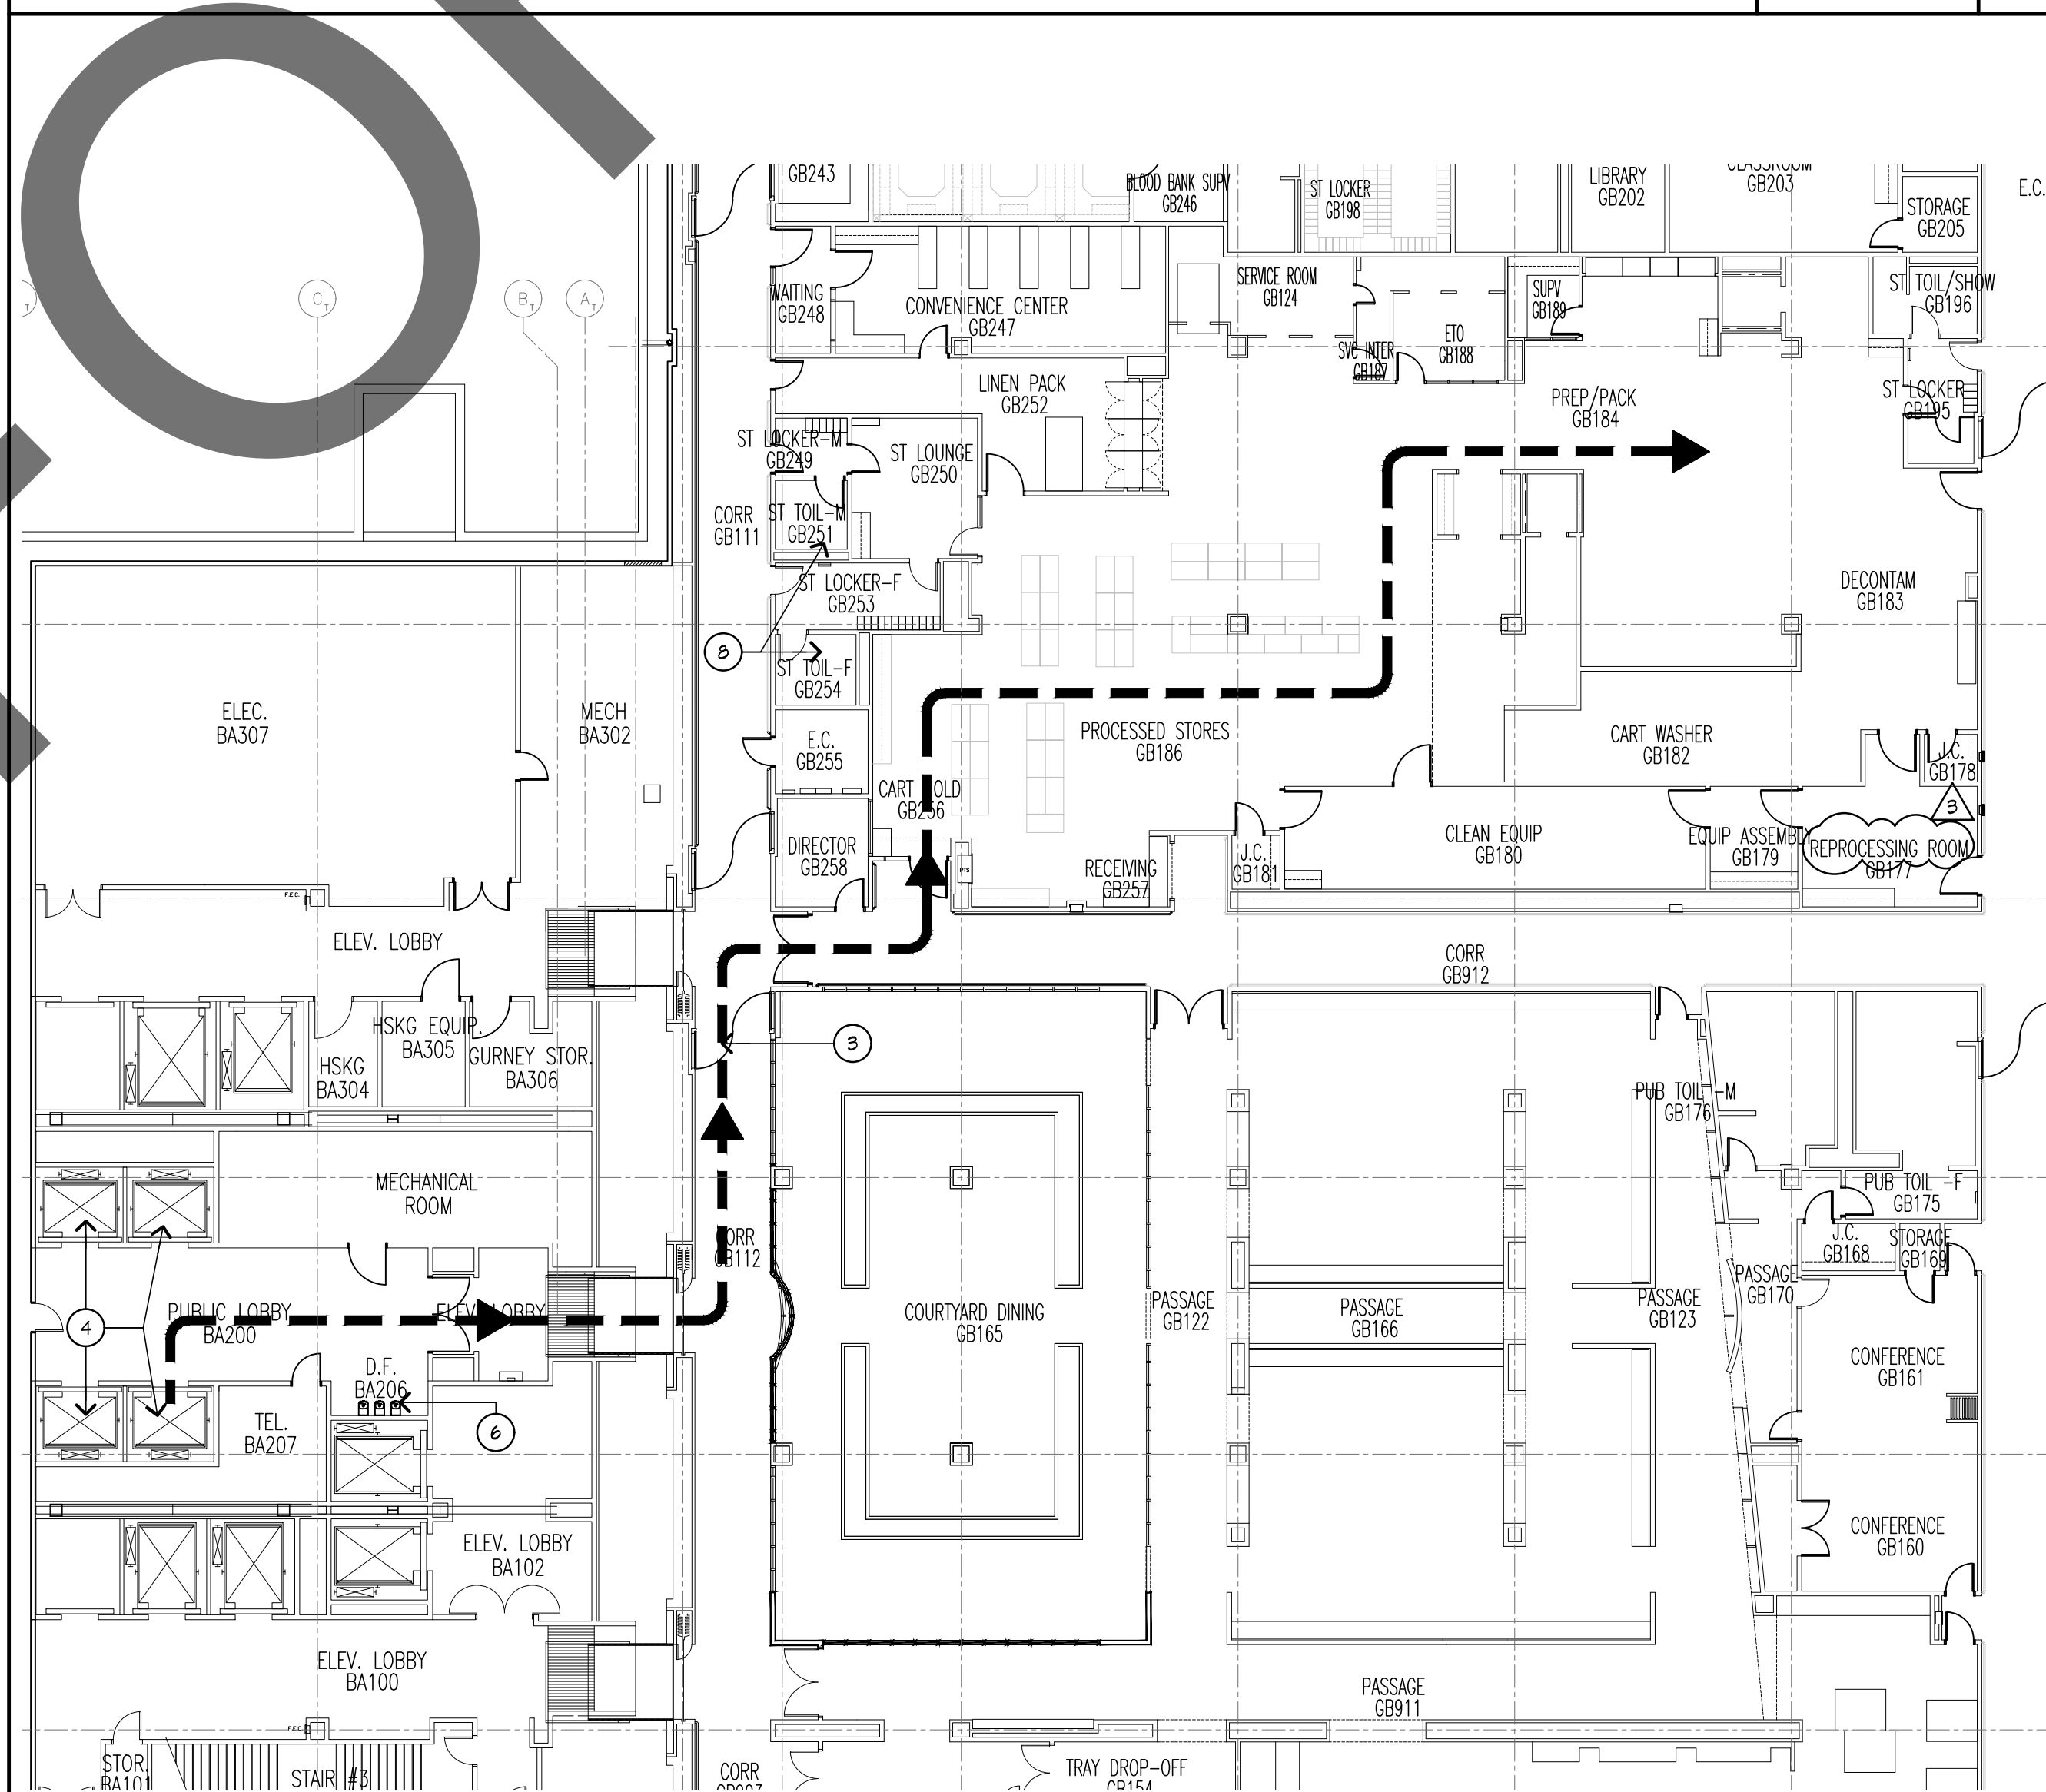

PARTIAL GROUND LEVEL FLOOR PLAN - PATH OF TRAVEL

1/16"=1'-0"

3


PROJECT TITLE  
**STERILIZATION SYSTEM  
INSTALLATION  
FOR THE  
ARROWHEAD REGIONAL  
MEDICAL CENTER**  
400 N. PEPPER AVE.  
COLTON, CA. 92324  
WBSE #10.10.1142 - CIP #21-154 - CAFM #COL003

Department of Health Care Access and Information

HCAI # S222347-36-00



REFERENCE PLAN

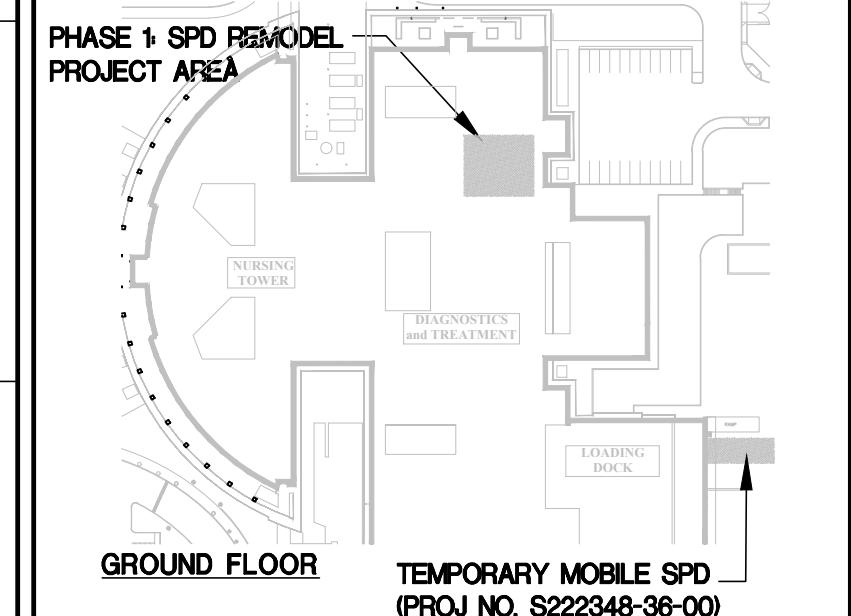


© marks architects, inc. 2022  
ALL REPORTS, PLANS AND DOCUMENTS PREPARED BY MARKS ARCHITECTS, INC. SHALL REMAIN THE PROPERTY OF MARKS ARCHITECTS, INC. AND ARE INTENDED FOR THIS SPECIFIC PROJECT ONLY. OTHER USES ARE PROHIBITED UNLESS OTHERWISE CONTRACTED.

SITE PLAN -  
PATH OF TRAVEL

DATE  
DECEMBER 28, 2022

REVISIONS

- △ PLAN CHECK COMMENTS - 02.13.2023
- △ AMCO001 - 06.13.2023
- △ PLAN CHECK COMMENTS - 06.27.2023
- △ PLAN CHECK COMMENTS - 08.15.2023

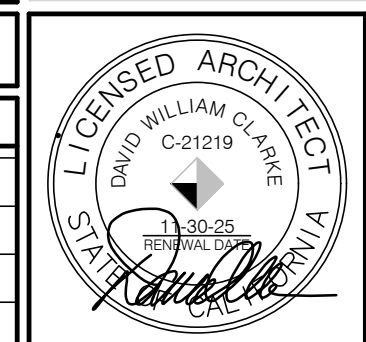

PROJECT NUMBER  
3021027


DRAWING NUMBER

A1.1





S:\Active Projects\County of San Bernardino\On Call Projects\Arrowhead Regional Medical Center\3021027 ARMC - Sterilizer Installation\3021027 A1.2.dwg Oct 16, 2023 11:11am

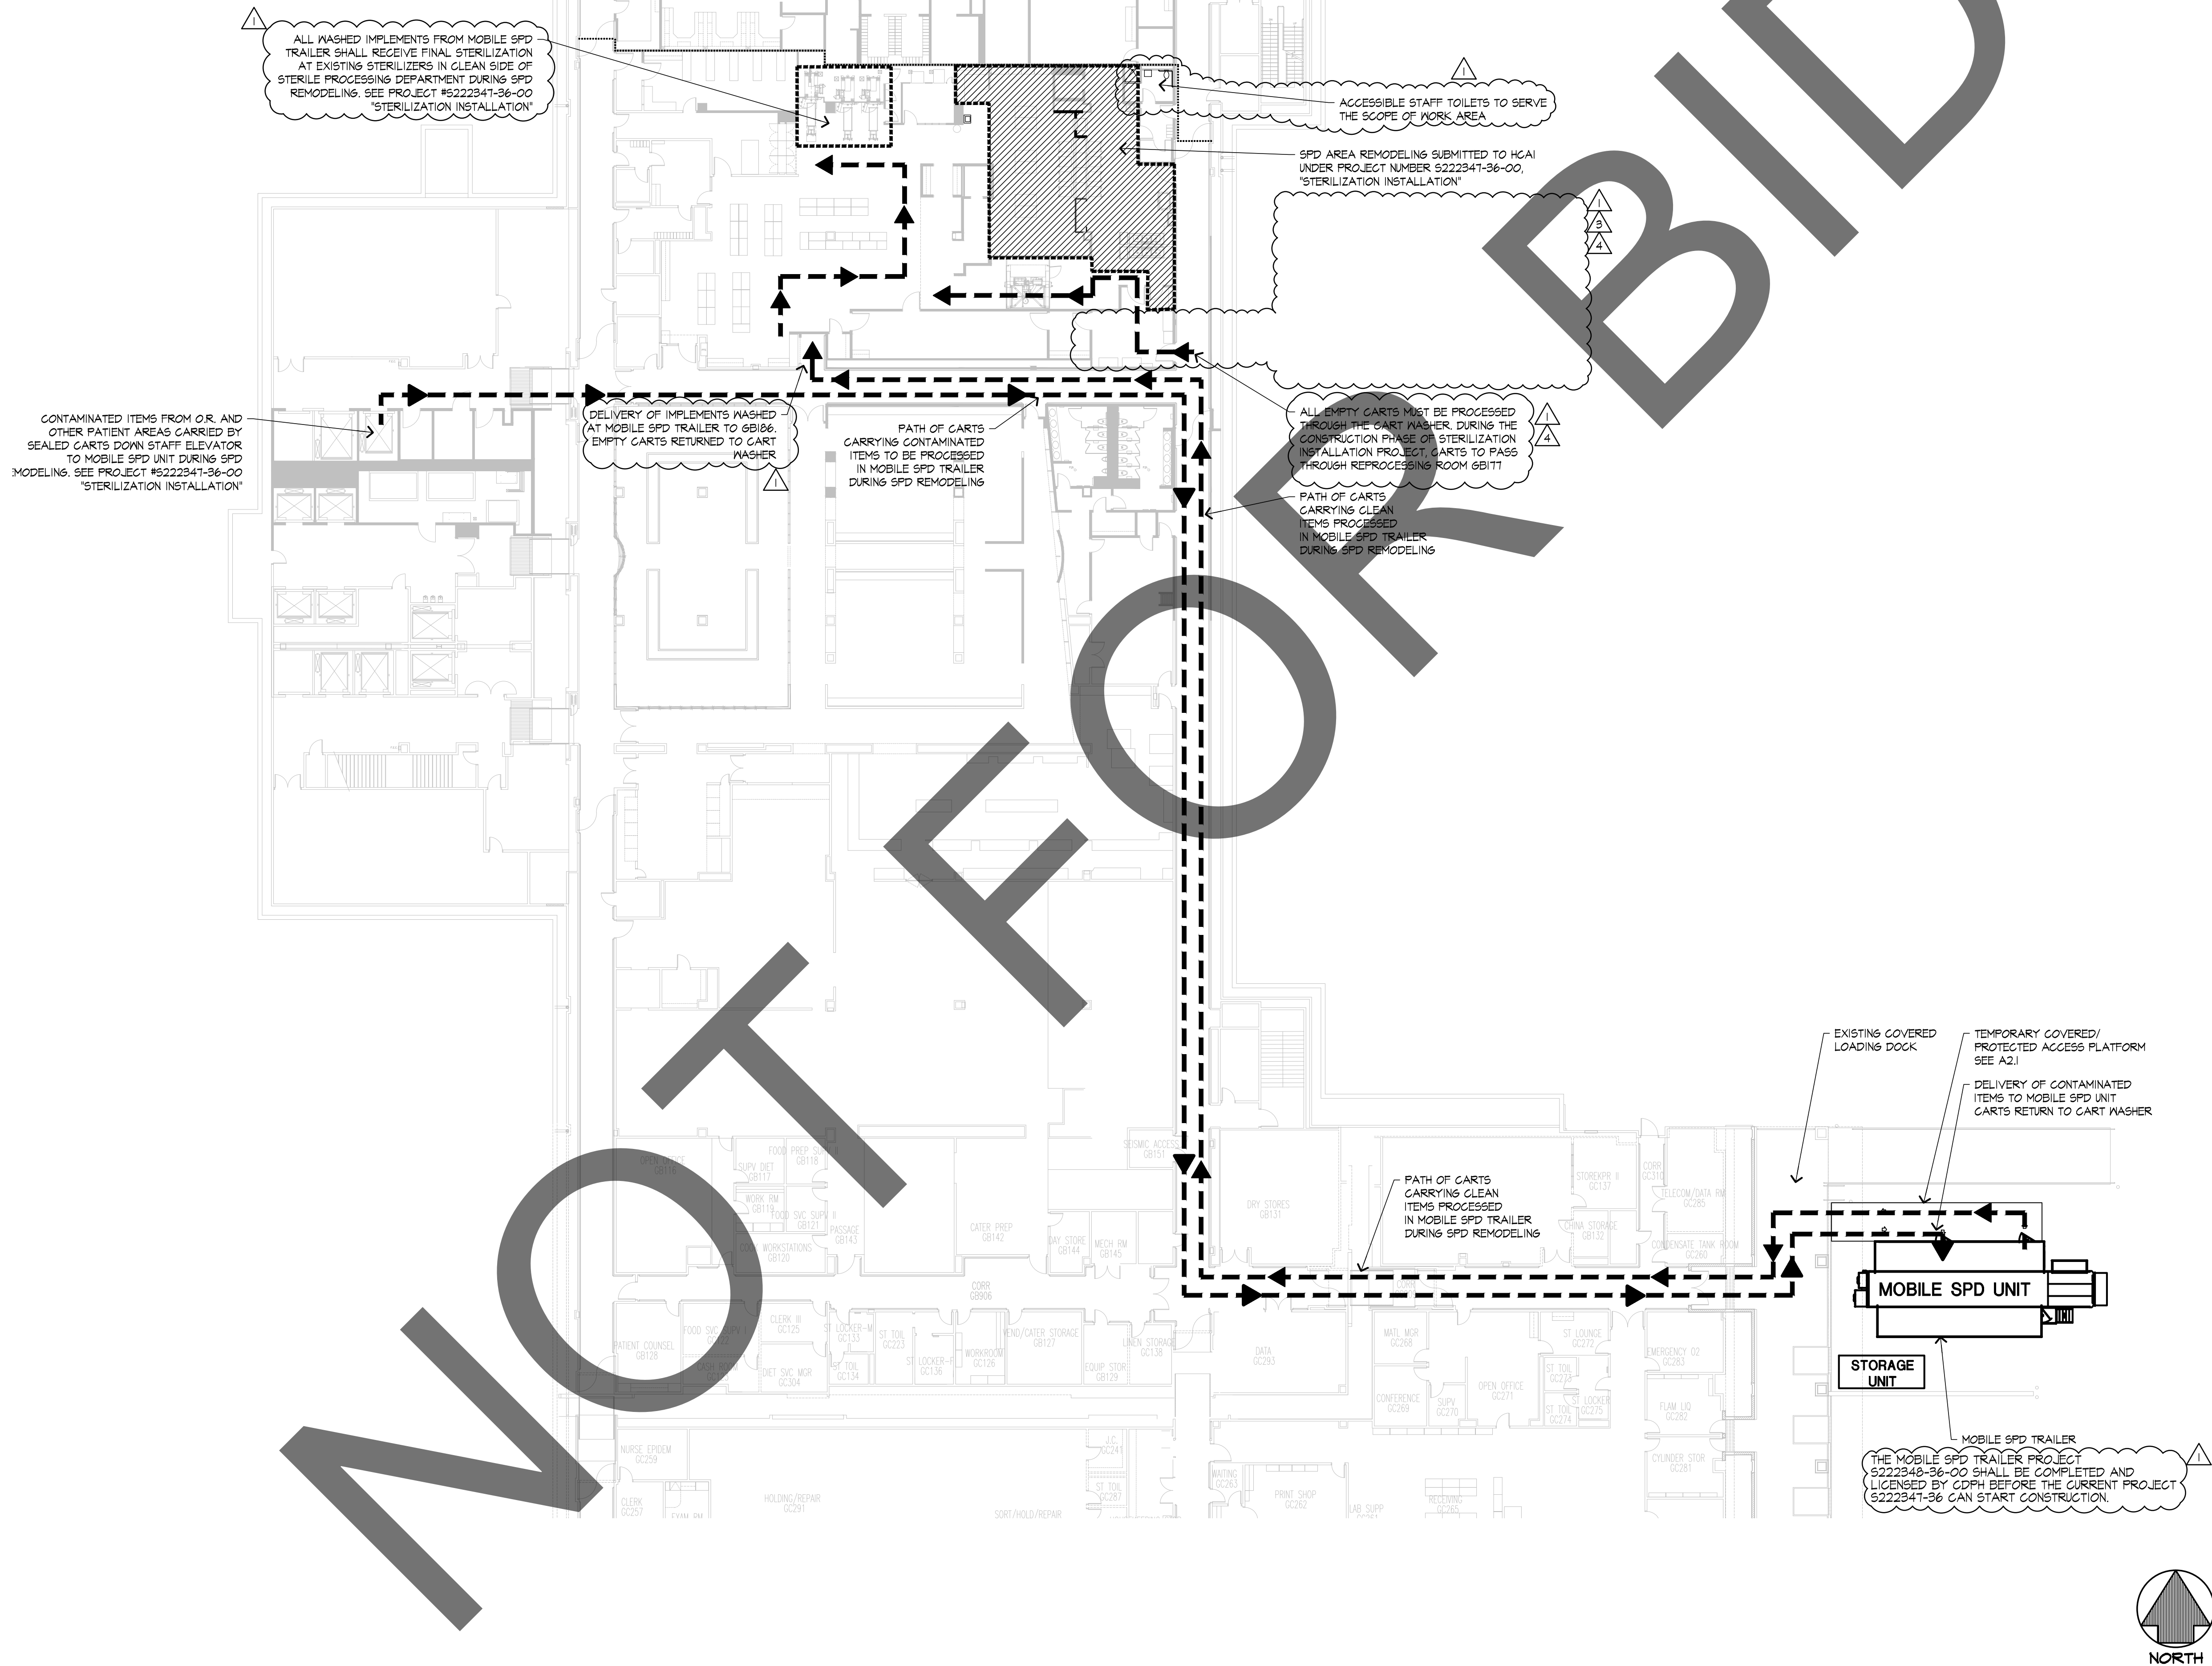


GROUND FLOOR PLAN - TEMPORARY SPD OPERATIONS PLAN DURING SPD REMODELING

1" = 20'-0" 1

PROJECT TITLE  
STERILIZATION SYSTEM  
INSTALLATION  
FOR THE  
ARROWHEAD REGIONAL  
MEDICAL CENTER  
400 N. PEPPER AVE.  
COLTON, CA. 92324  
WBSE #10.10.1142 - CIP #21-154 - CAFM #COL003

Department of Health Care Access and Information  
HCAI # S222347-36-00

REVIEWED IN ACCORDANCE WITH  
THE REQUIREMENTS OF T24, CGR  
**APPROVED**  
Department of Health Care Access & Information  
Office of Statewide Hospital Planning & Development  
1/4/2024, 9:00:12 AM  
S222347-36-00  
Allen Cheng

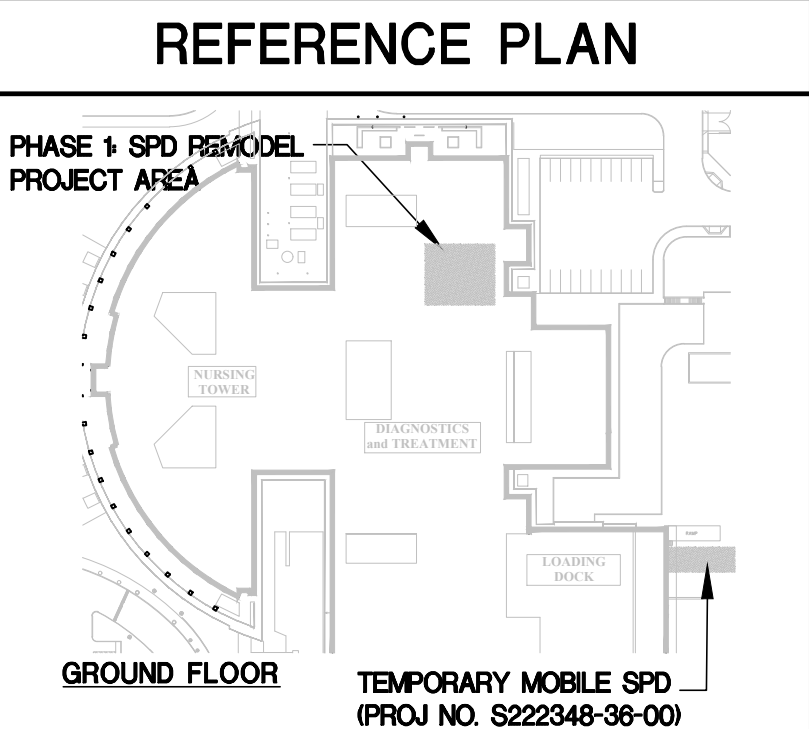

©marks architects, inc. 2022  
ALL REPORTS, PLANS AND DOCUMENTS PREPARED BY MARKS ARCHITECTS, INC. SHALL  
REMAIN THE PROPERTY OF MARKS ARCHITECTS, INC. AND ARE INTENDED FOR THIS SPECIFIC  
PROJECT ONLY. OTHER USES ARE PROHIBITED UNLESS OTHERWISE CONTRACTED.

GROUND FLOOR -  
TEMPORARY SPD OPERATIONS  
PLAN


marks  
architects

73121 fred waring drive suite 200  
palm desert, ca 92260  
760-327-6800

DRAWING TITLE	DATE	REVISIONS	
	DECEMBER 28, 2022		
		1. PLAN CHECK COMMENTS - 02.13.2023	
		2. AMC0001 - 06.13.2023	
		3. PLAN CHECK COMMENTS - 06.27.2023	
		4. PLAN CHECK COMMENTS - 08.15.2023	
			PROJECT NUMBER 3021027
			DRAWING NUMBER A1.2



S:\Active Projects\County of Son Bernardino\On Call Projects\Arrowhead Regional Medical Center\3021027 D2.1.dwg Nov 01, 2023 - 8:37am

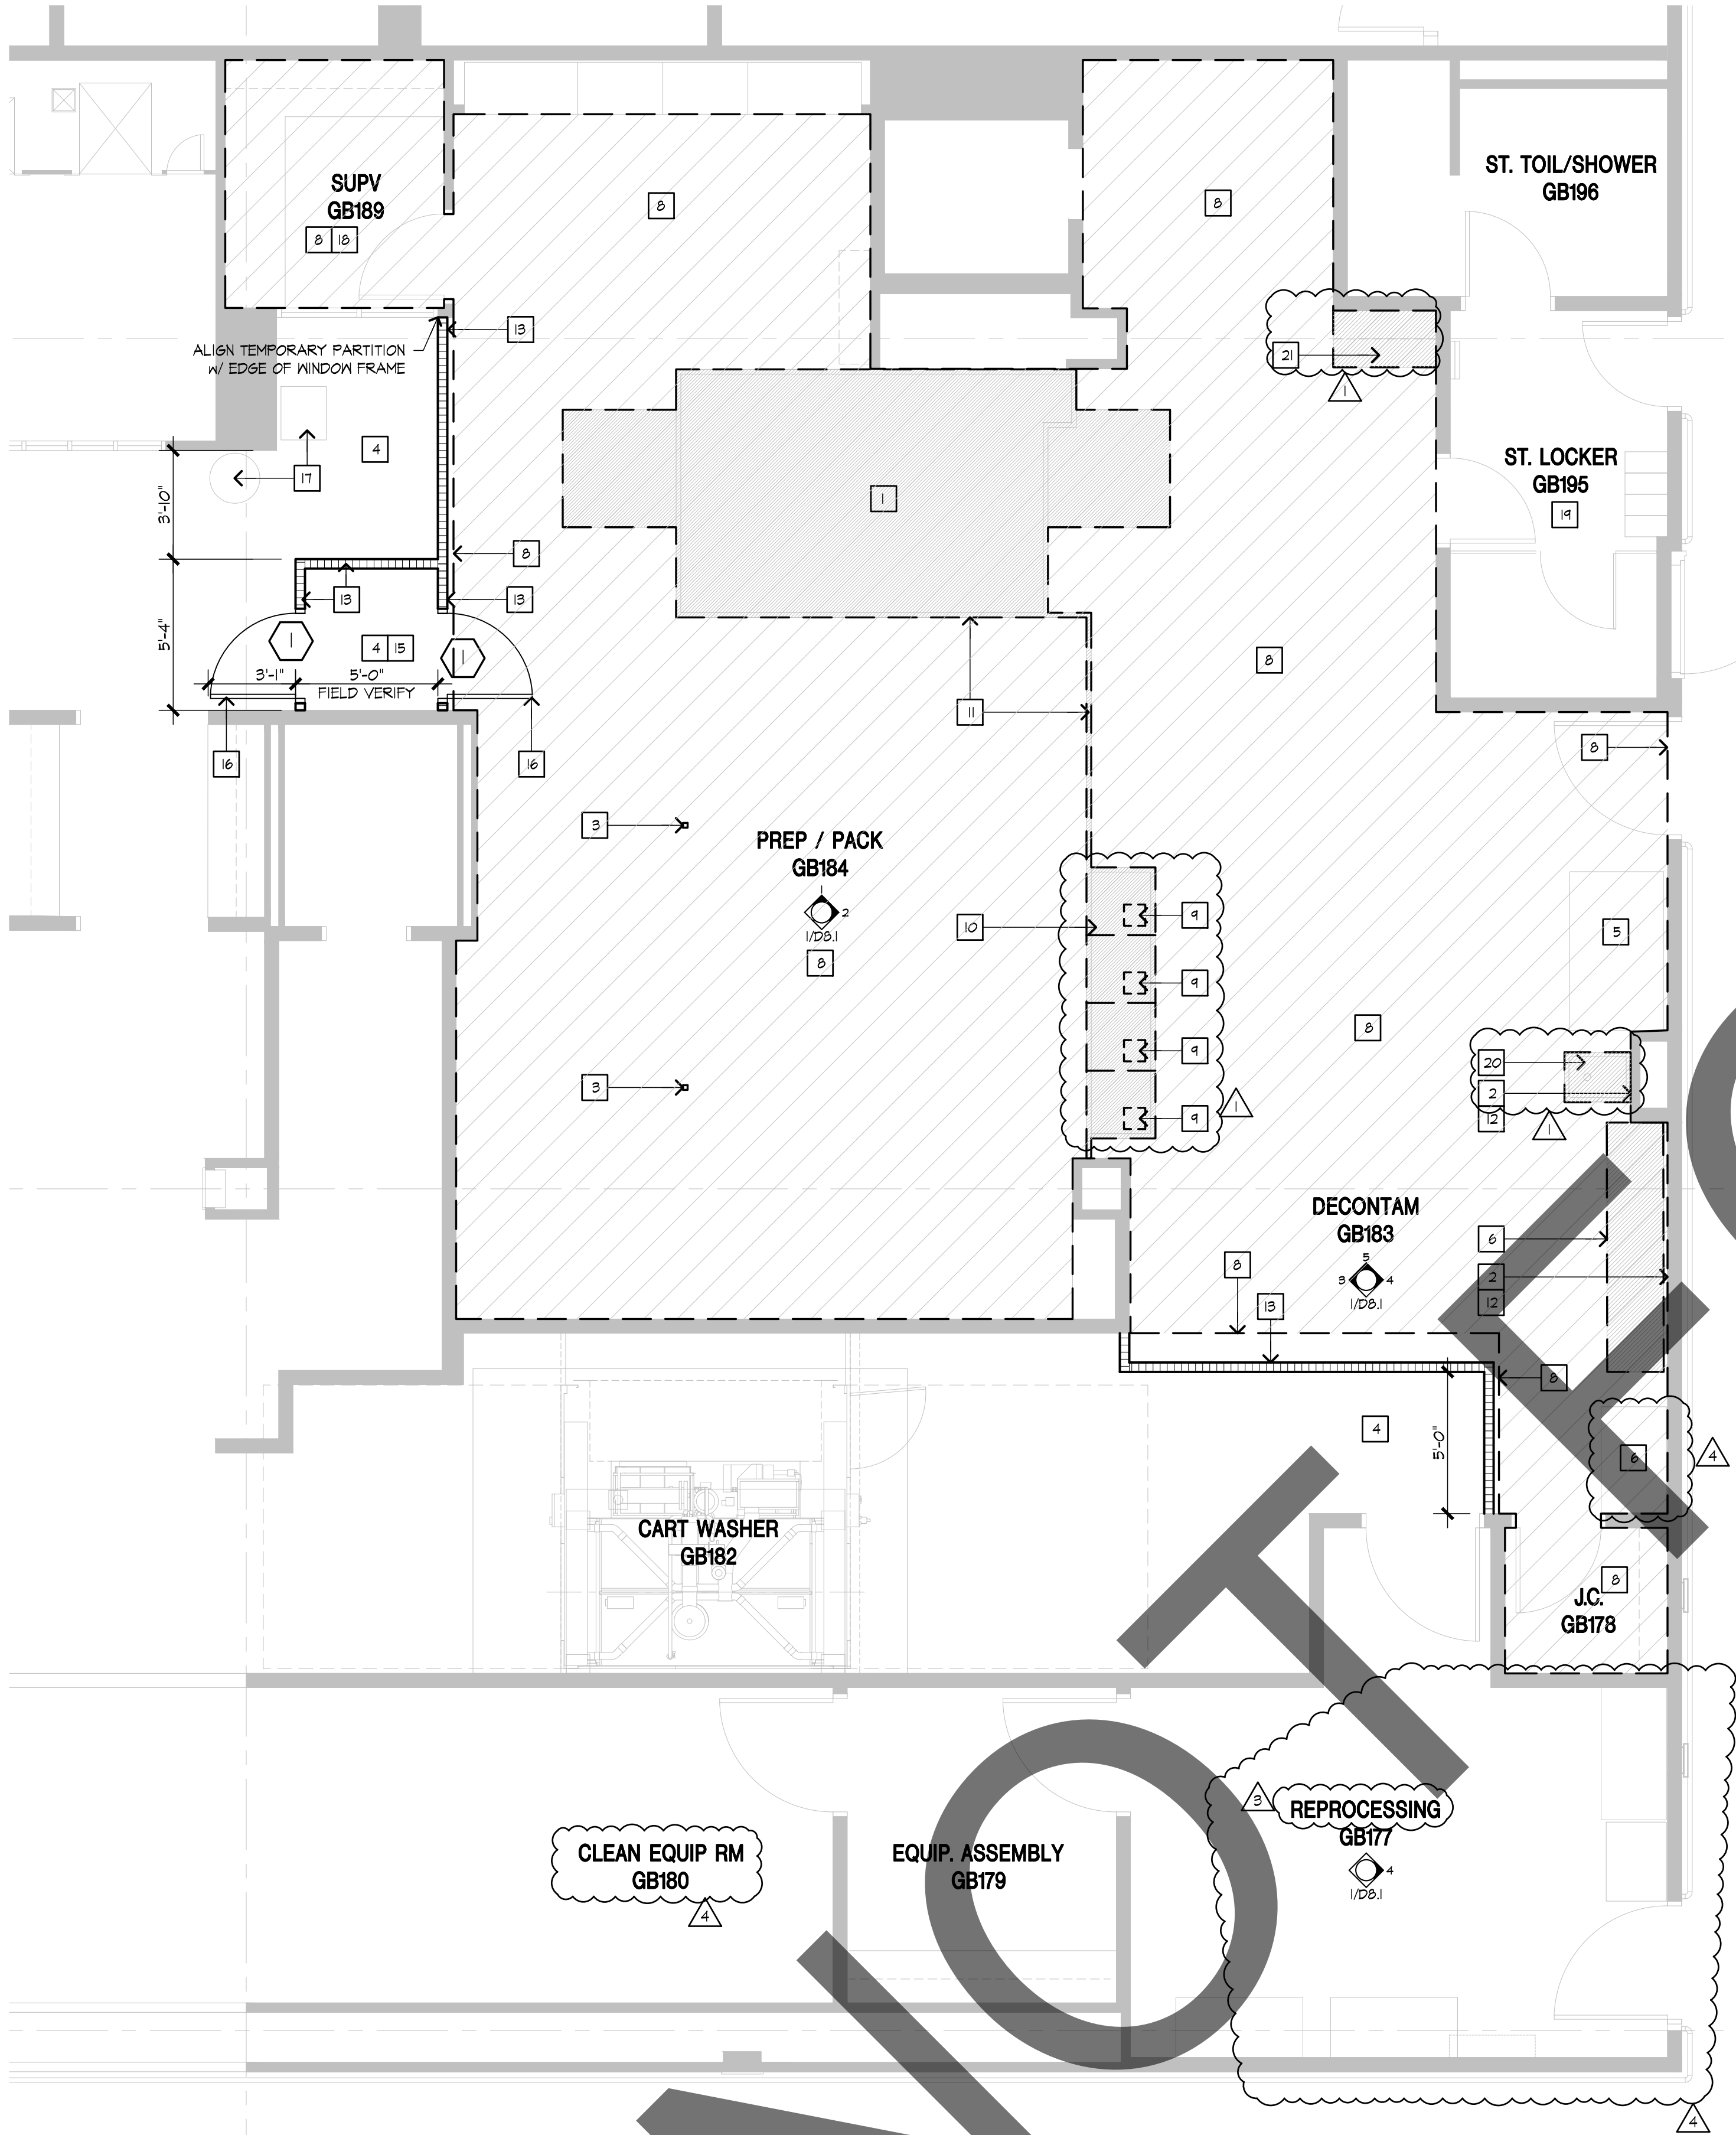

DEMOLITION FLOOR PLAN

1/4"=1'-0"

1

- EXISTING TUNNEL WASHER SHALL BE REMOVED.
- EXISTING TILE ON WALL SHALL BE REMOVED. CONTRACTOR SHALL INSTALL NEW TYPE "X" DRYWALL, PATCH AND REPAIR ALL EXISTING HOLES LEFT FROM THE PLUMBING FIXTURES. CONTRACTOR SHALL PATCH AND REPAIR WALL AS REQUIRED AND PROVIDE ONE COAT PRIMER AND TWO COATS ZERO VOC PAINT, COLOR AND FINISH SURFACE SHALL MATCH EXISTING.
- STAINLESS STEEL POWER AND DATA CHASE SHALL BE REMOVED. PATCH AND REPAIR EXISTING FLOORING TO MATCH EXISTING.
- EXISTING FINISH FLOORING AND BASE SHALL REMAIN. PROTECT DURING CONSTRUCTION.
- EXISTING SONIC IRRIGATION EQUIPMENT SHALL BE REMOVED AND REPLACED UNDER SEPARATE PROJECT AND APPROVAL. S222347-36-00, SONIC IRRIGATION REPLACEMENT. THE ACR IS SUBMITTING BOTH THIS PROJECT AND THE SONIC IRRIGATION REPLACEMENT PROJECT TO HCAI FOR SEPARATE APPROVAL BUT CONCURRENT REVIEW. CONSTRUCTION SHALL ALSO BE EXECUTED CONCURRENTLY BY THE SAME CONTRACTOR.
- EXISTING SONIC IRRIGATION EQUIPMENT TO REMAIN. PROTECT DURING CONSTRUCTION.
- DELETED.
- REMOVE EXISTING FLOORING AND BASE IN THIS AREA BOUNDED BY DASHED LINE.
- EXISTING FLOOR SINKS SHALL BE REMOVED. SEE SHEET A2.1 FOR INFILL DISSECTION.
- EXISTING STERILIZER EQUIPMENT SHALL BE REMOVED BY STERIS. CONTRACTOR SHALL DISCONNECT ALL UTILITIES AND REMOVE SEISMIC ANCHORING PRIOR TO STERIS' REMOVAL OF EQUIPMENT. SEE MECHANICAL, PLUMBING, AND ELECTRICAL PLANS FOR DISCONNECTIONS OF UTILITIES.
- EXISTING STAINLESS STEEL MODULAR WALL PANELS SHALL BE REMOVED AND NOT SALVAGED.
- EXISTING ELECTRICAL SWITCHES, CONDUIT, ELECTRICAL OUTLETS, AND LIGHT SWITCHES SHALL BE REMOVED, REPLACED OR RELOCATED. SEE ELECTRICAL DRAWINGS FOR LOCATIONS.
- PROVIDE AND INSTALL TEMPORARY BARRICADES MEETING IGRA LEVEL 4 CONTAINMENT STANDARDS. A PRE-MANUFACTURED MODULAR WALL SYSTEM (SUCH AS BY STARG SYSTEMS 'REALWALL') IS ACCEPTABLE. WHERE NO FIRE RATING IS REQUIRED, THE USE OF FIRE RESISTANT PLASTIC SHEETING (SOFT BARRICADE) IS NOT ACCEPTABLE. SEE GENERAL NOTE FOR SEPTAL.
- DELETED.
- TEMPORARY STERILE ANTI ROOM. ONLY TO BE USED WHEN ACCESS TO GB184 IS NO LONGER AVAILABLE FROM GB183 DUE TO EQUIPMENT INSTALLATION. COORDINATE WITH SPD SUPERVISOR FOR ACCESS PROCEDURES.
- TEMPORARY DOOR, MIN WIDTH 3'-0". DOOR TO BE PART OF MODULAR WALL SYSTEM. SEE NOTE 13.
- DELETED.
- SUPERVISORS OFFICE GB189 SHALL NOT BE OCCUPIED DURING CONSTRUCTION.
- STAFF LOCKER ROOM GB195 SHALL SERVE AS A STERILE ANTI-ROOM DURING CONSTRUCTION. CONTRACTOR AND SUBCONTRACTORS SHALL USE THIS AS THE PRIMARY ACCESS TO THE CONSTRUCTION AREA UNTIL HCAI ISSUES A TEMPORARY CERTIFICATE OF OCCUPANCY FOR GB189.
- EXISTING SOILED UTILITY SINK TO BE REMOVED. SEE PLUMBING PLANS FOR INSTRUCTIONS FOR REMOVAL OR CAPPING OF PIPING BEHIND THE EXISTING WALL. SEE REMODEL PLAN A2.1 FOR PATCHING INSTRUCTIONS.
- EXISTING CASEWORK BASE AND WALL CABINET TO BE REMOVED.

DEMOLITION KEYNOTES

2


PROJECT TITLE  
**STERILIZATION SYSTEM  
INSTALLATION  
FOR THE  
ARROWHEAD REGIONAL  
MEDICAL CENTER**  
400 N. PEPPER AVE.  
COLTON, CA. 92324  
WBSE #10.10.1142 - CIP #21-154 - CAFM #COL003

Department of Health Care Access and Information

HCAI # S222347-36-00



REFERENCE PLAN

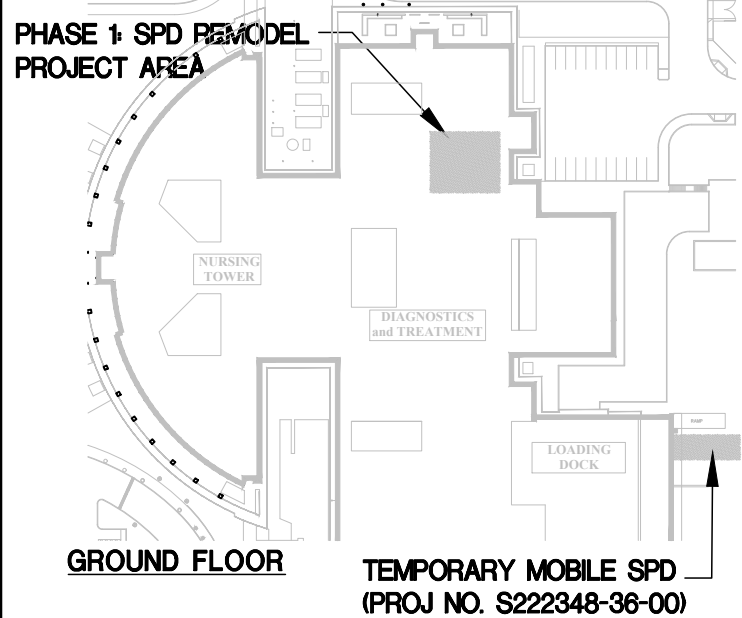

© marks architects, inc. 2022  
ALL REPORTS, PLANS AND DOCUMENTS PREPARED BY MARKS ARCHITECTS, INC. SHALL REMAIN THE PROPERTY OF MARKS ARCHITECTS, INC. AND ARE INTENDED FOR THIS SPECIFIC PROJECT ONLY. OTHER USES ARE PROHIBITED UNLESS OTHERWISE CONTRACTED.

DEMOLITION  
FLOOR PLAN




73121 fred waring drive  
suite 200  
palm desert, ca 92260  
760-327-6800

DATE  
**DECEMBER 28, 2022**

REVISIONS

- |   |                                  |
|---|----------------------------------|
| △ | PLAN CHECK COMMENTS - 02.13.2023 |
| △ | AMC0001 - 06.13.2023             |
| △ | PLAN CHECK COMMENTS - 06.27.2023 |
| △ | PLAN CHECK COMMENTS - 08.15.2023 |

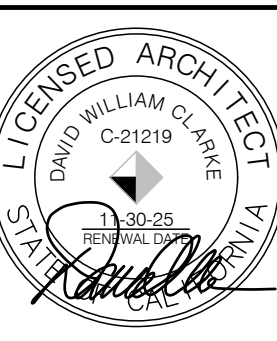

PROJECT NUMBER  
**3021027**

DRAWING NUMBER

**D2.1**



- ## DEMOLITION KEYNOTES

CORR  
GB914

DECONTAM  
GB183

**PREP / PACK**  
**GB184**

**CART WASHER**  
**GB182**

J.C.  
GB178

REPROCESSING ROOM  
GB177

**EQUIP. ASSEMBLY**  
**GB179**


### DEMOLITION REFLECTED CEILING PLAN

$$1/4'' = 1' - 0''$$

1

## 05.1



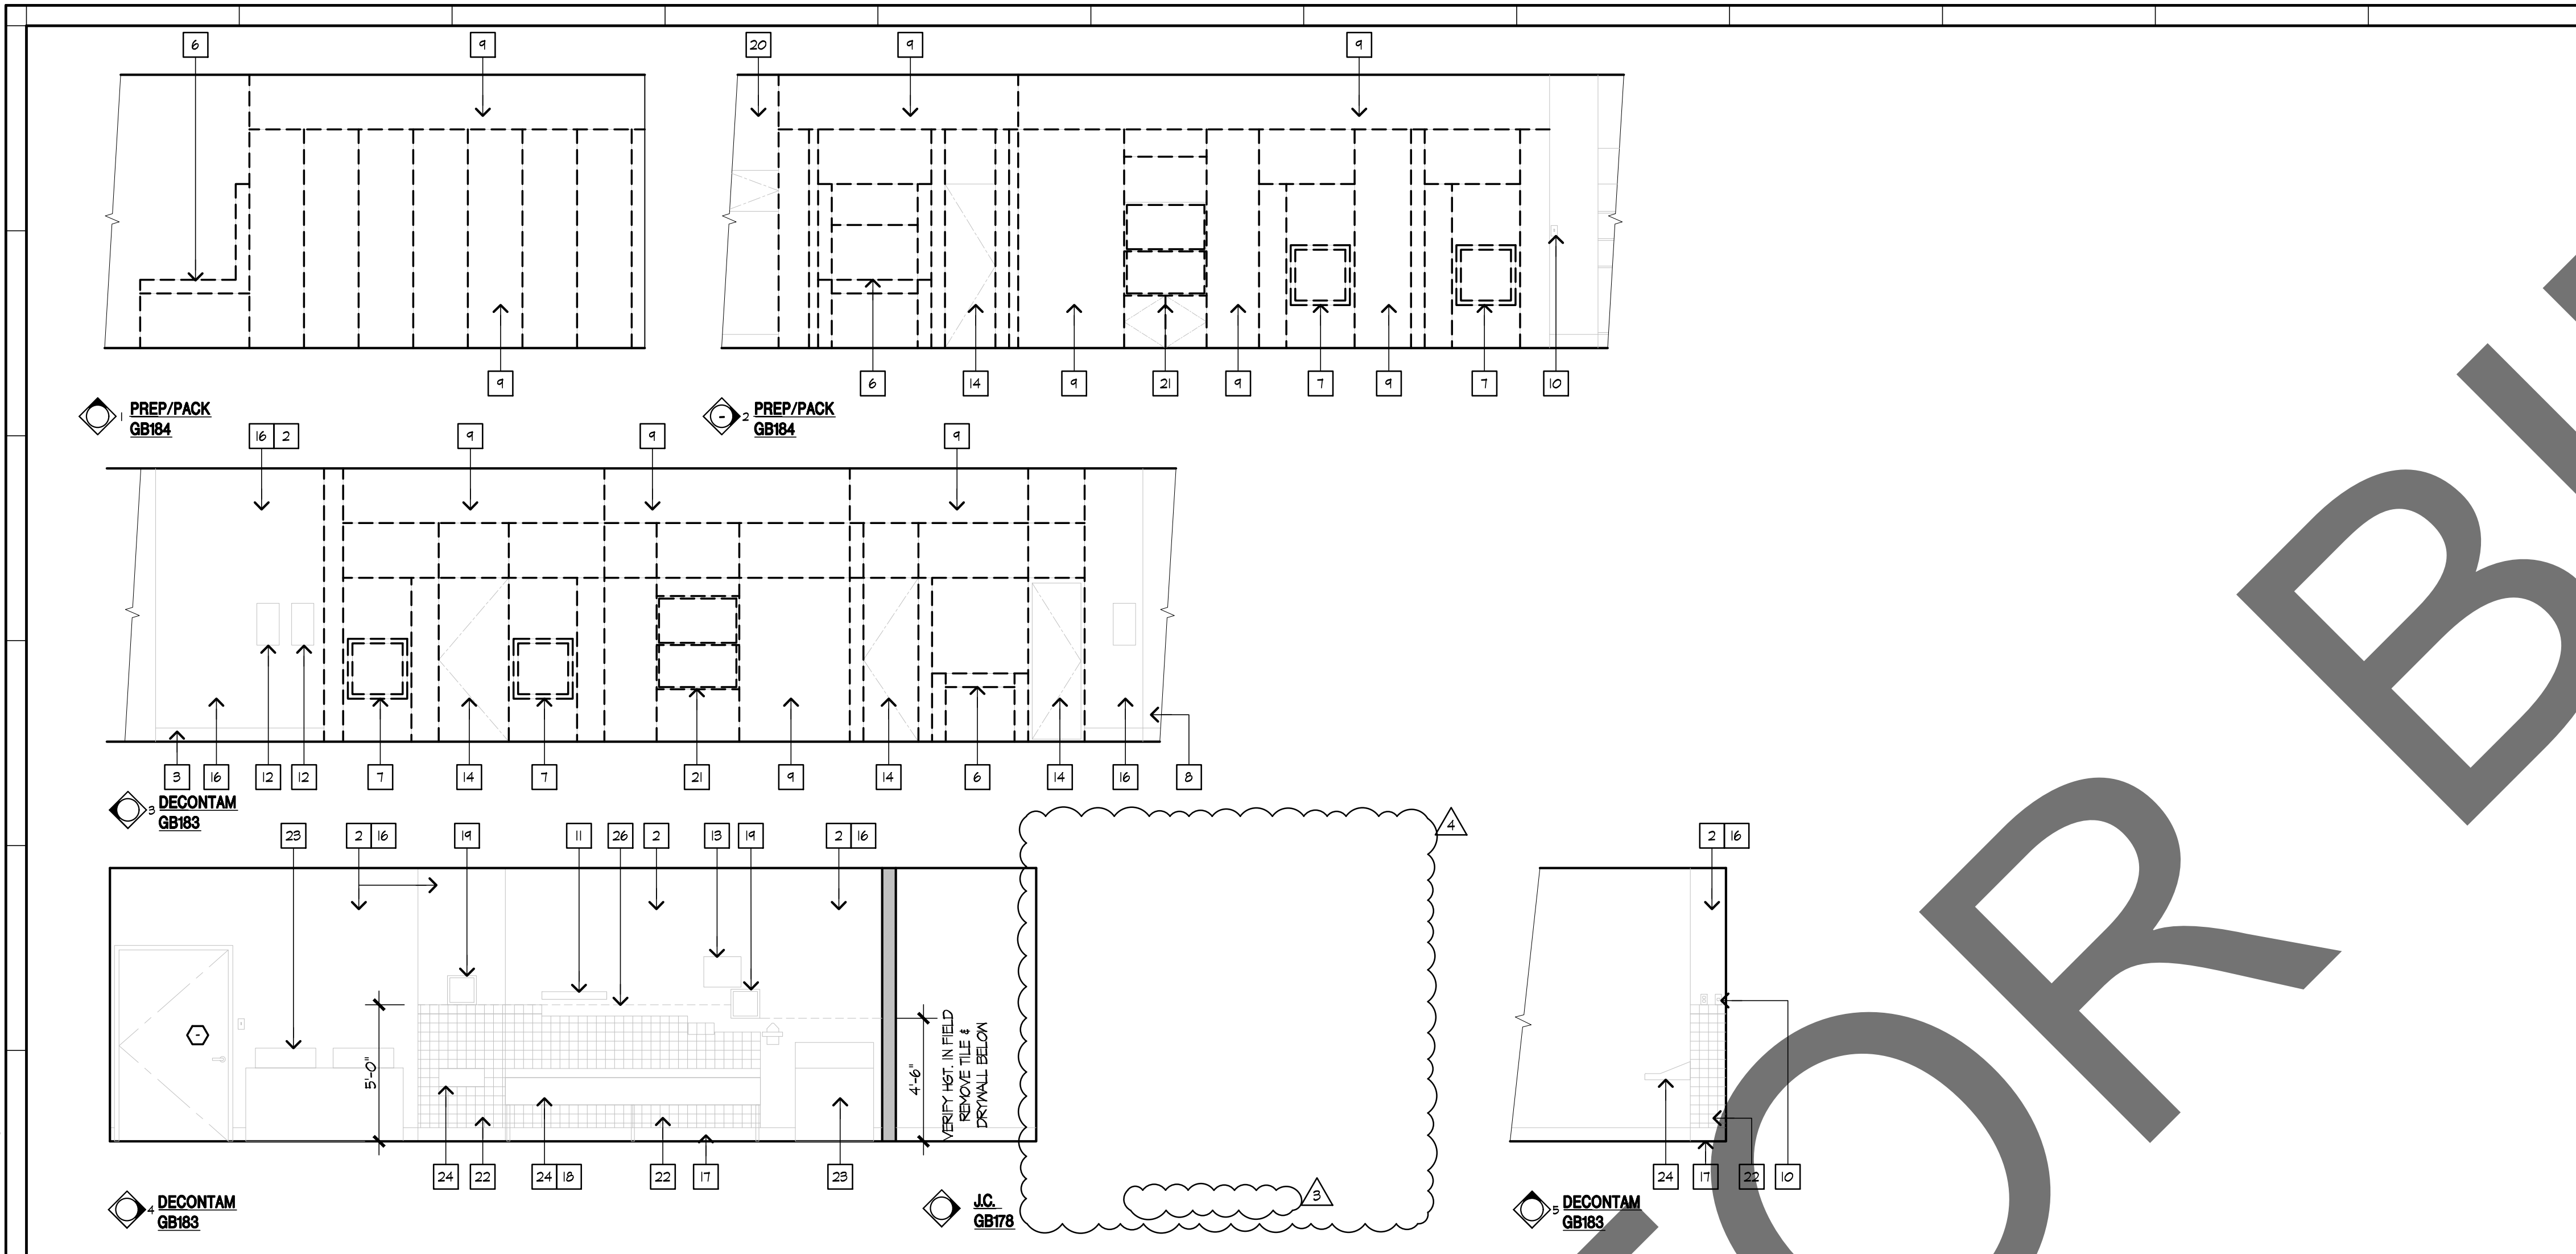

## DEMOLITION INTERIOR ELEVATIONS

1/4"=1'-0"	1
------------	---

1

- 1 EXISTING DASHED FRAME AND HARDWARE SHALL REMAIN. PROTECT DURING CONSTRUCTION.
- 2 EXISTING DRYWALL SHALL REMAIN. PREPARE SURFACE BY REMOVING ANY EXISTING CHIPPED OR PEELING PAINT, SAND SURFACES SMOOTH, AND RE-TEXTURE SURFACES TO MATCH EXISTING, PRIOR TO PAINTING.
- 3 EXISTING WALL BASE SHALL REMAIN. PROTECT DURING CONSTRUCTION.
- 4 EXISTING CORNER GUARD SHALL REMAIN. PROTECT DURING CONSTRUCTION.
- 5 EXISTING EQUIPMENT SHALL REMAIN. PROTECT DURING CONSTRUCTION.
- 6 EXISTING EQUIPMENT SHALL BE REMOVED.
- 7 EXISTING FLOOR LOADER STERILIZER TO BE REMOVED.
- 8 EXISTING STAINLESS-STEEL MODULAR PANEL SYSTEM SHALL REMAIN. PROTECT DURING CONSTRUCTION.
- 9 EXISTING STAINLESS-STEEL MODULAR PANEL TO BE REMOVED.
- 10 EXISTING ELECTRICAL SWITCHES, AND OUTLETS SHALL REMAIN. VERIFY WITH ELECTRICAL DRAWINGS. PROTECT DURING CONSTRUCTION.
- 11 EXISTING WALL MOUNTED SHELF SHALL BE REMOVED.
- 12 EXISTING ELECTRICAL PANEL FOR EMERGENCY SHUT-OFF SWITCH SHALL REMAIN. PROTECT DURING CONSTRUCTION.
- 13 EXISTING SIGNAGE SHALL BE RELOCATED, VERIFY NEW LOCATION WITH HOSPITAL REPRESENTATIVE. PROTECT DURING CONSTRUCTION.
- 14 EXISTING G.S. DOOR AND FRAME SHALL BE REMOVED.
- 15 EXISTING DRYWALL SHALL BE REMOVED.
- 16 PATCH AND REPAIR AS NEEDED DRYWALL SHALL BE SANDED SMOOTH FINISHED WITH A LIGHT STIFFLE FINISH PREPARED FOR PAINTING AND PAINTED WITH ONE COAT PRIMER AND TWO COATS EGGSHELL. VERIFY COLOR WITH HOSPITAL REF. SEE STRUCTURAL FOR FRAMING.
- 17 EXISTING WALL BASE SHALL BE REMOVED.
- 18 ALL PLUMBING EQUIPMENT ON THE WALL SHALL BE REMOVED.
- 19 EXISTING ACCESS DOOR SHALL REMAIN. PROTECT DURING CONSTRUCTION.
- 20 EXISTING CABINETS SHALL REMAIN. PROTECT DURING CONSTRUCTION.
- 21 EXISTING PASS-THRU WINDOW SHALL BE REMOVED.
- 22 EXISTING TILE SHALL BE REMOVED.
- 23 EXISTING SONIC IRRIGATORS SHALL BE REMOVED UNDER A SEPARATE PROJECT, PROJECT NUMBER AND SEPARATE APPROVAL. PROJECT NUMBER FOR THE SONIC IRRIGATORS SHALL BE HCAI #5-36-00. PROJECTS SHALL BE SEPARATED SEPARATELY, BUT CONSTRUCTION SHALL BE EXECUTED SIMULTANEOUSLY.
- 24 EXISTING SINKS SHALL BE REMOVED. SEE PLUMBING DRAWINGS FOR DIRECTION.
- 25 DELETED.
- 26 EXISTING DRYWALL SHALL BE REMOVED. DRYWALL SHALL BE REMOVED BEHIND THE DASHED LINE AS INDICATED ON INT. ELEVATION. PREPARE SURFACE BY REMOVING ANY EXISTING CHIPPED OR PEELING PAINT, SAND SURFACES SMOOTH, AND RE-TEXTURE SURFACES TO MATCH EXISTING, PRIOR TO PAINTING.

PROJECT TITLE

**STERILIZATION SYSTEM  
INSTALLATION  
FOR THE  
ARROWHEAD REGIONAL  
MEDICAL CENTER**

**400 N. PEPPER AVE.  
COLTON, CA. 92324**


**WBSE #10.10.1142 - CIP #21-154 - CAFM #COL003**

Department of Health Care Access and Information

HCAI # S222347-36-00



## REFERENCE PLAN

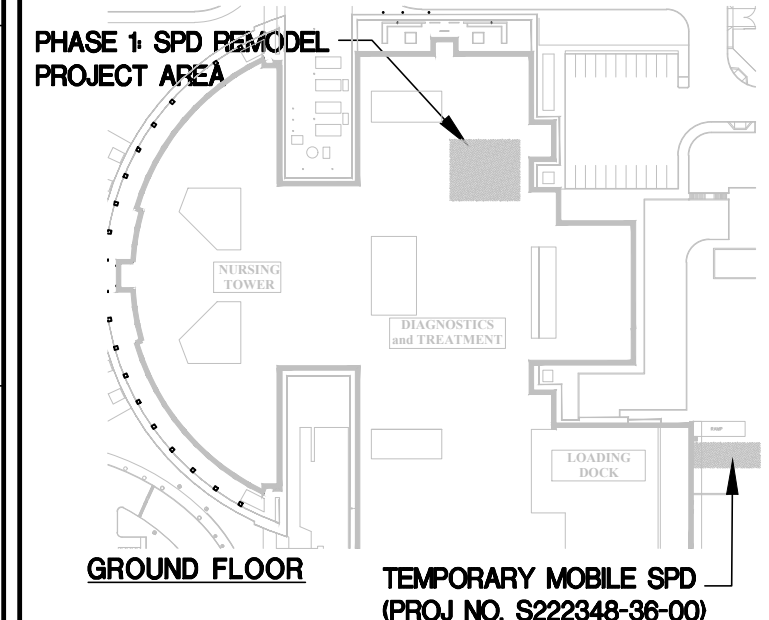

©marks architects, inc. 2022  
ALL REPORTS, PLANS AND DOCUMENTS PREPARED BY MARKS ARCHITECTS, INC. SHALL  
REMAIN THE PROPERTY OF MARKS ARCHITECTS, INC. AND ARE INTENDED FOR THIS SPECIFIC  
PROJECT ONLY. OTHER USES ARE PROHIBITED UNLESS OTHERWISE CONTRACTED.












**TITLE**  
**EMOLITION & REMODEL**  
**INTERIOR ELEVATIONS**




73121 fred waring drive  
suite 200  
palm desert, ca 92260  
760-327-6800

DATE  
DECEMBER 28, 2022


## REVISIONS

	PLAN CHECK COMMENTS - 02.13.2023
	AMC0001 - 06.13.2023
	PLAN CHECK COMMENTS - 06.27.2023
	PLAN CHECK COMMENTS - 08.15.2023
	
	
	
	
	
	
	

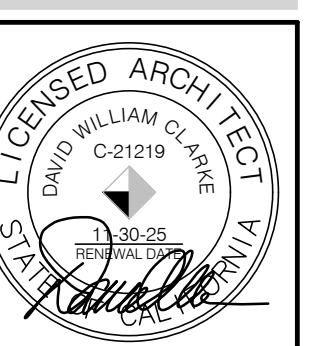

PROJECT NUMBER	3021027
DRAWING NUMBER	

## D8.1

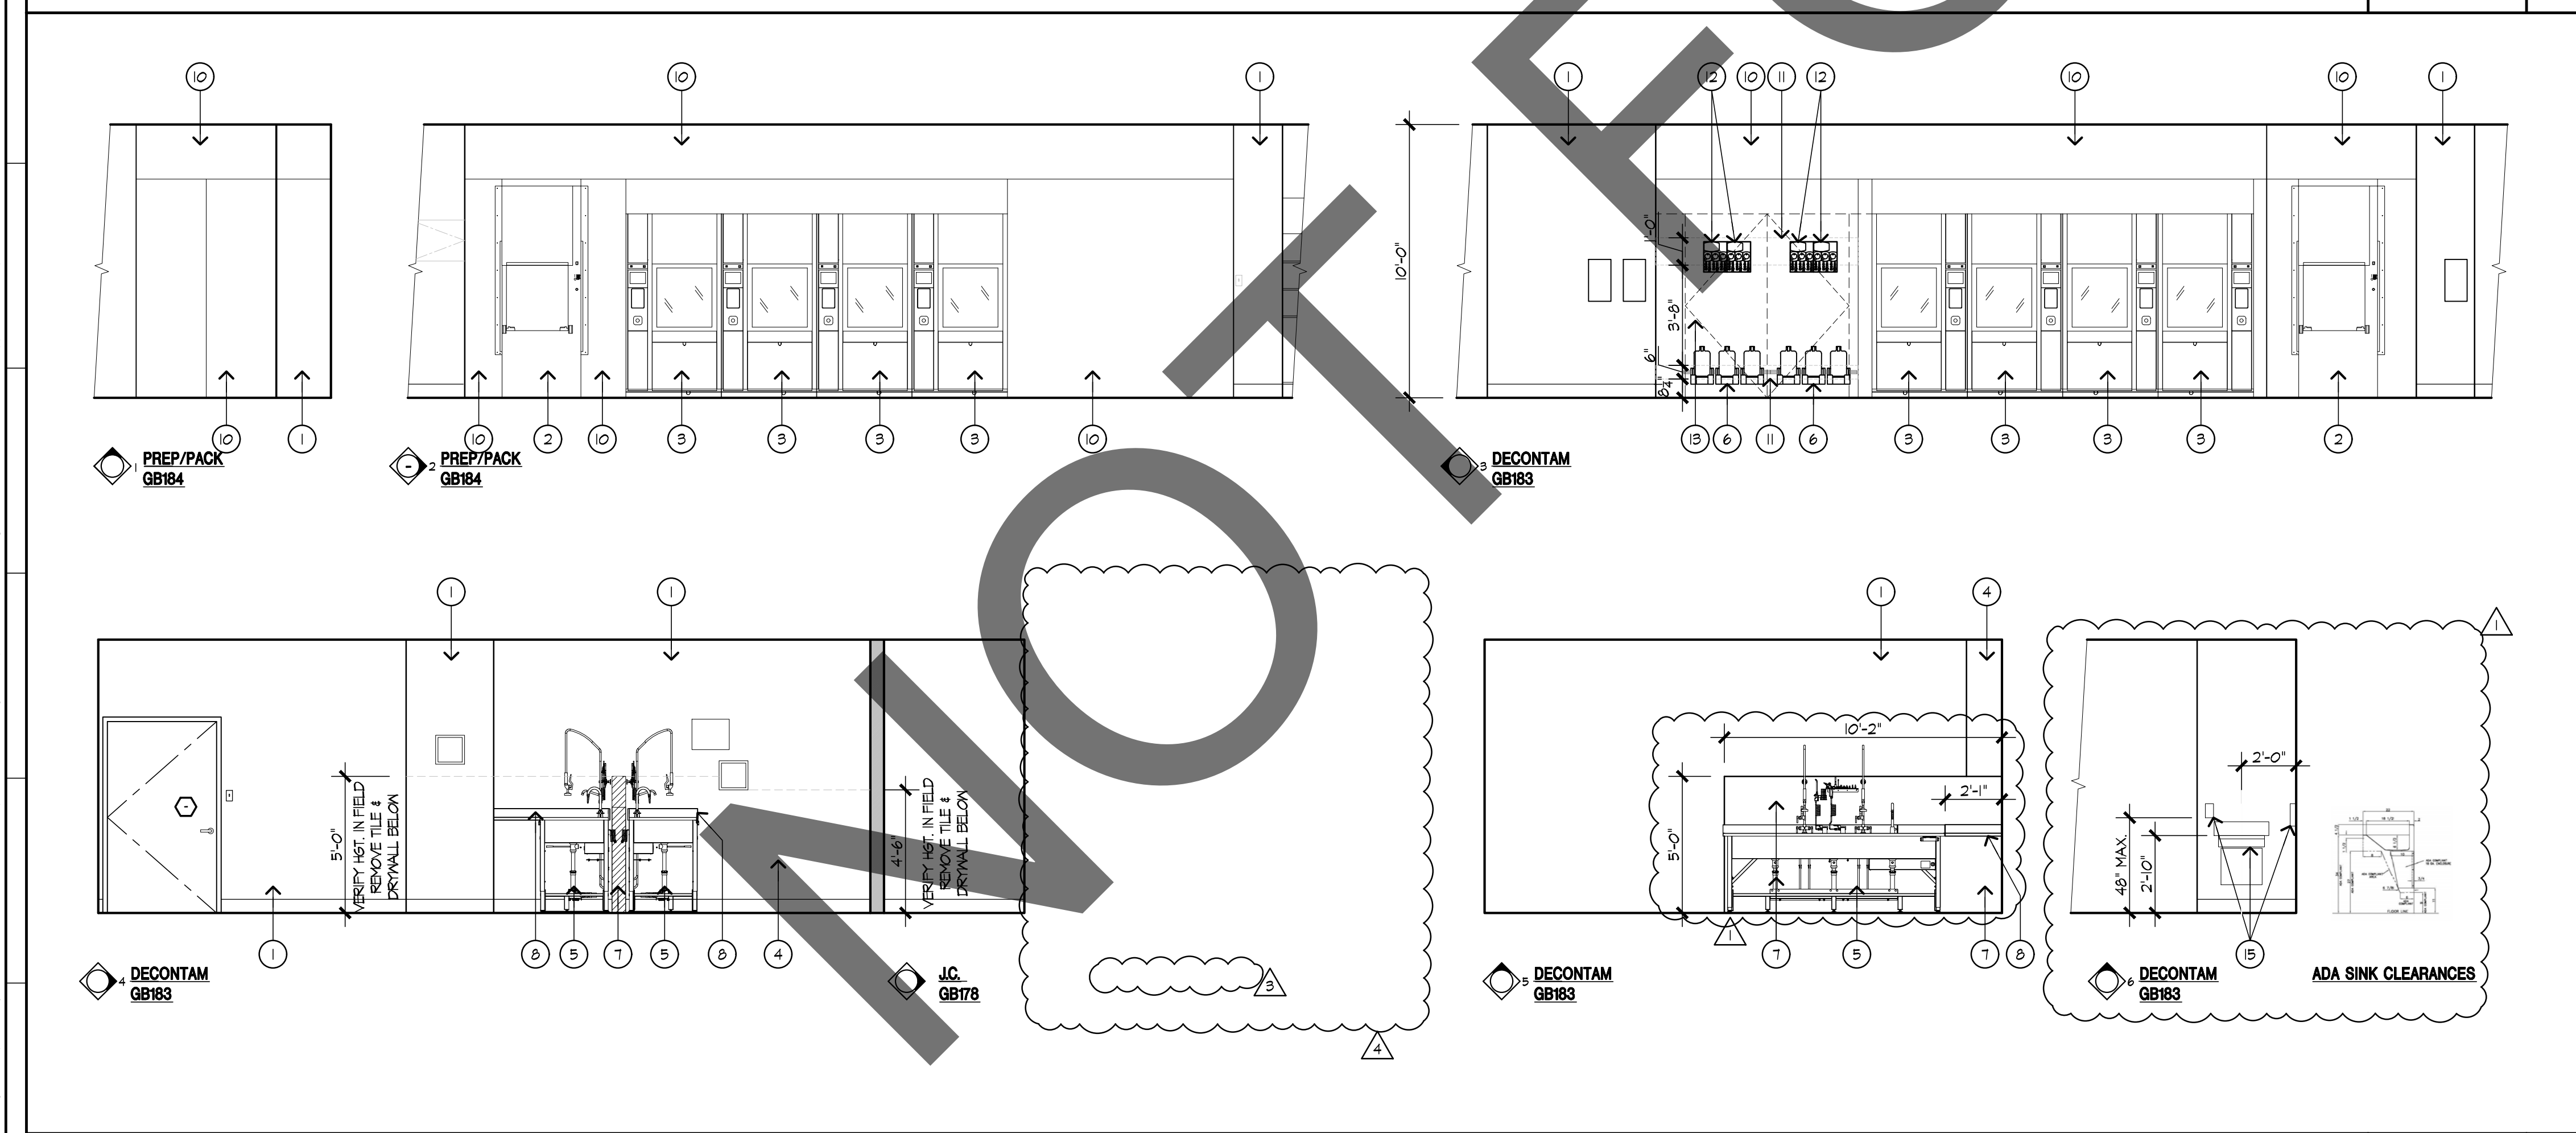

## REMODEL INTERIOR ELEVATIONS

1/4"=1'-0"	2
------------	---


2

## DEMOLITION KEYNOTES

- (1) EXISTING WALL SHALL REMAIN. CONTRACTOR SHALL PATCH AND REPAIR WALL AS REQUIRED AND PROVIDE ONE COAT PRIMER AND TWO COATS ZERO VOC PAINT, COLOR AND FINISH SURFACE SHALL MATCH EXISTING.
- (2) NEW EQUIPMENT - RACK RETURN, VERIFY EQUIPMENT CLEARANCE AND INSTALLATION WITH STERIS REPRESENTATIVE.
- (3) NEW EQUIPMENT - SINGLE CHAMBER WASHER/DISINFECTOR, VERIFY EQUIPMENT CLEARANCE AND INSTALLATION WITH STERIS REPRESENTATIVE.
- (4) PATCH AND REPAIR WALL, CONTRACTOR SHALL INSTALL NEW TYPE "X" GYPSUM BOARD, PATCH AND REPAIR ALL EXISTING HOLES LEFT FROM PLUMBING FIXTURE REMOVAL, CONTRACTOR SHALL PATCH AND REPAIR WALL AS REQUIRED TO MATCH EXISTING TO REMAIN SURFACES, REPAINT ALL AFFECTED WALLS WITH ONE COAT PRIMER AND TWO COATS ZERO VOC PAINT, COLOR AND FINISH SURFACE SHALL MATCH EXISTING.
- (5) NEW TRIPLE SINK, SEE PLUMBING AND STRUCTURAL PLANS.
- (6) ACU-HOLD SYSTEM WITH 3 CHEMICAL CONTAINERS, PROVIDED AND INSTALLED BY STERIS, BACKING BY CONTRACTOR, VERIFY WITH STERIS REPRESENTATIVE FOR EXACT LOCATION.
- (7) NEW 6' X 10 GA. METAL STUD WALL AT 16" O.C. WITH ONE LAYER OF  $\frac{5}{8}$ " GREEN BOARD ON BOTH SIDES, WITH 10 GA. S.S. SHEET METAL PANELS OVER THE GREEN BOARD ON BOTH SIDES, PONY WALL HEIGHT SHALL BE 60".
- (8) NEW 10 GA. 430 S.S. COUNTERTOP, IT SHALL BE AN EXTENSION FROM THE SINK, CONTRACTOR SHALL FIELD VERIFY EXACT DIMENSION BEFORE FABRICATING THE COUNTERTOP.
- (9) DELETED.
- (10) NEW STAINLESS STEEL MODULAR WALL PANELS:  
NEW  $3\frac{5}{8}$ " METAL STUDS WITH 3" BATT INSULATION WITH 10 GA. S.S. SHEET METAL PANELS ON BOTH SIDES, S.S. SHEET METAL WALL/SOME WALLS ONLY HAVE S.S. SHEET METAL ON ONE SIDE. MANUFACTURER SHALL PROVIDE SHOP DRAWINGS TO ARCHITECT FOR REVIEW AND APPROVAL PRIOR TO FABRICATION.
- (11) PROVIDE 166A STL BACKING IN THIS LOCATION
- (12) DOSING SYSTEM WITH 3 PUMPS, PROVIDED AND INSTALLED BY STERIS, BACKING BY CONTRACTOR, VERIFY WITH STERIS REPRESENTATIVE FOR EXACT LOCATION.
- (13) DOUBLE 3'-0" X 6'-8-3/4" 10 GA SS ACCESS DOORS BY SS PANEL SUBCONTRACTOR, PROVIDE SS HINGES AND LATCHING MECHANISM, VERIFY WITH STERIS REPRESENTATIVE HARDWARE REQUIREMENTS.
- (14) RESERVED.
- (15) NEW HAND SINK WITH EYE WASH, SOAP DISPENSER AND TONEL DISPENSER, SEE PLUMBING REQUIREMENTS.


## REMODEL KEYNOTES



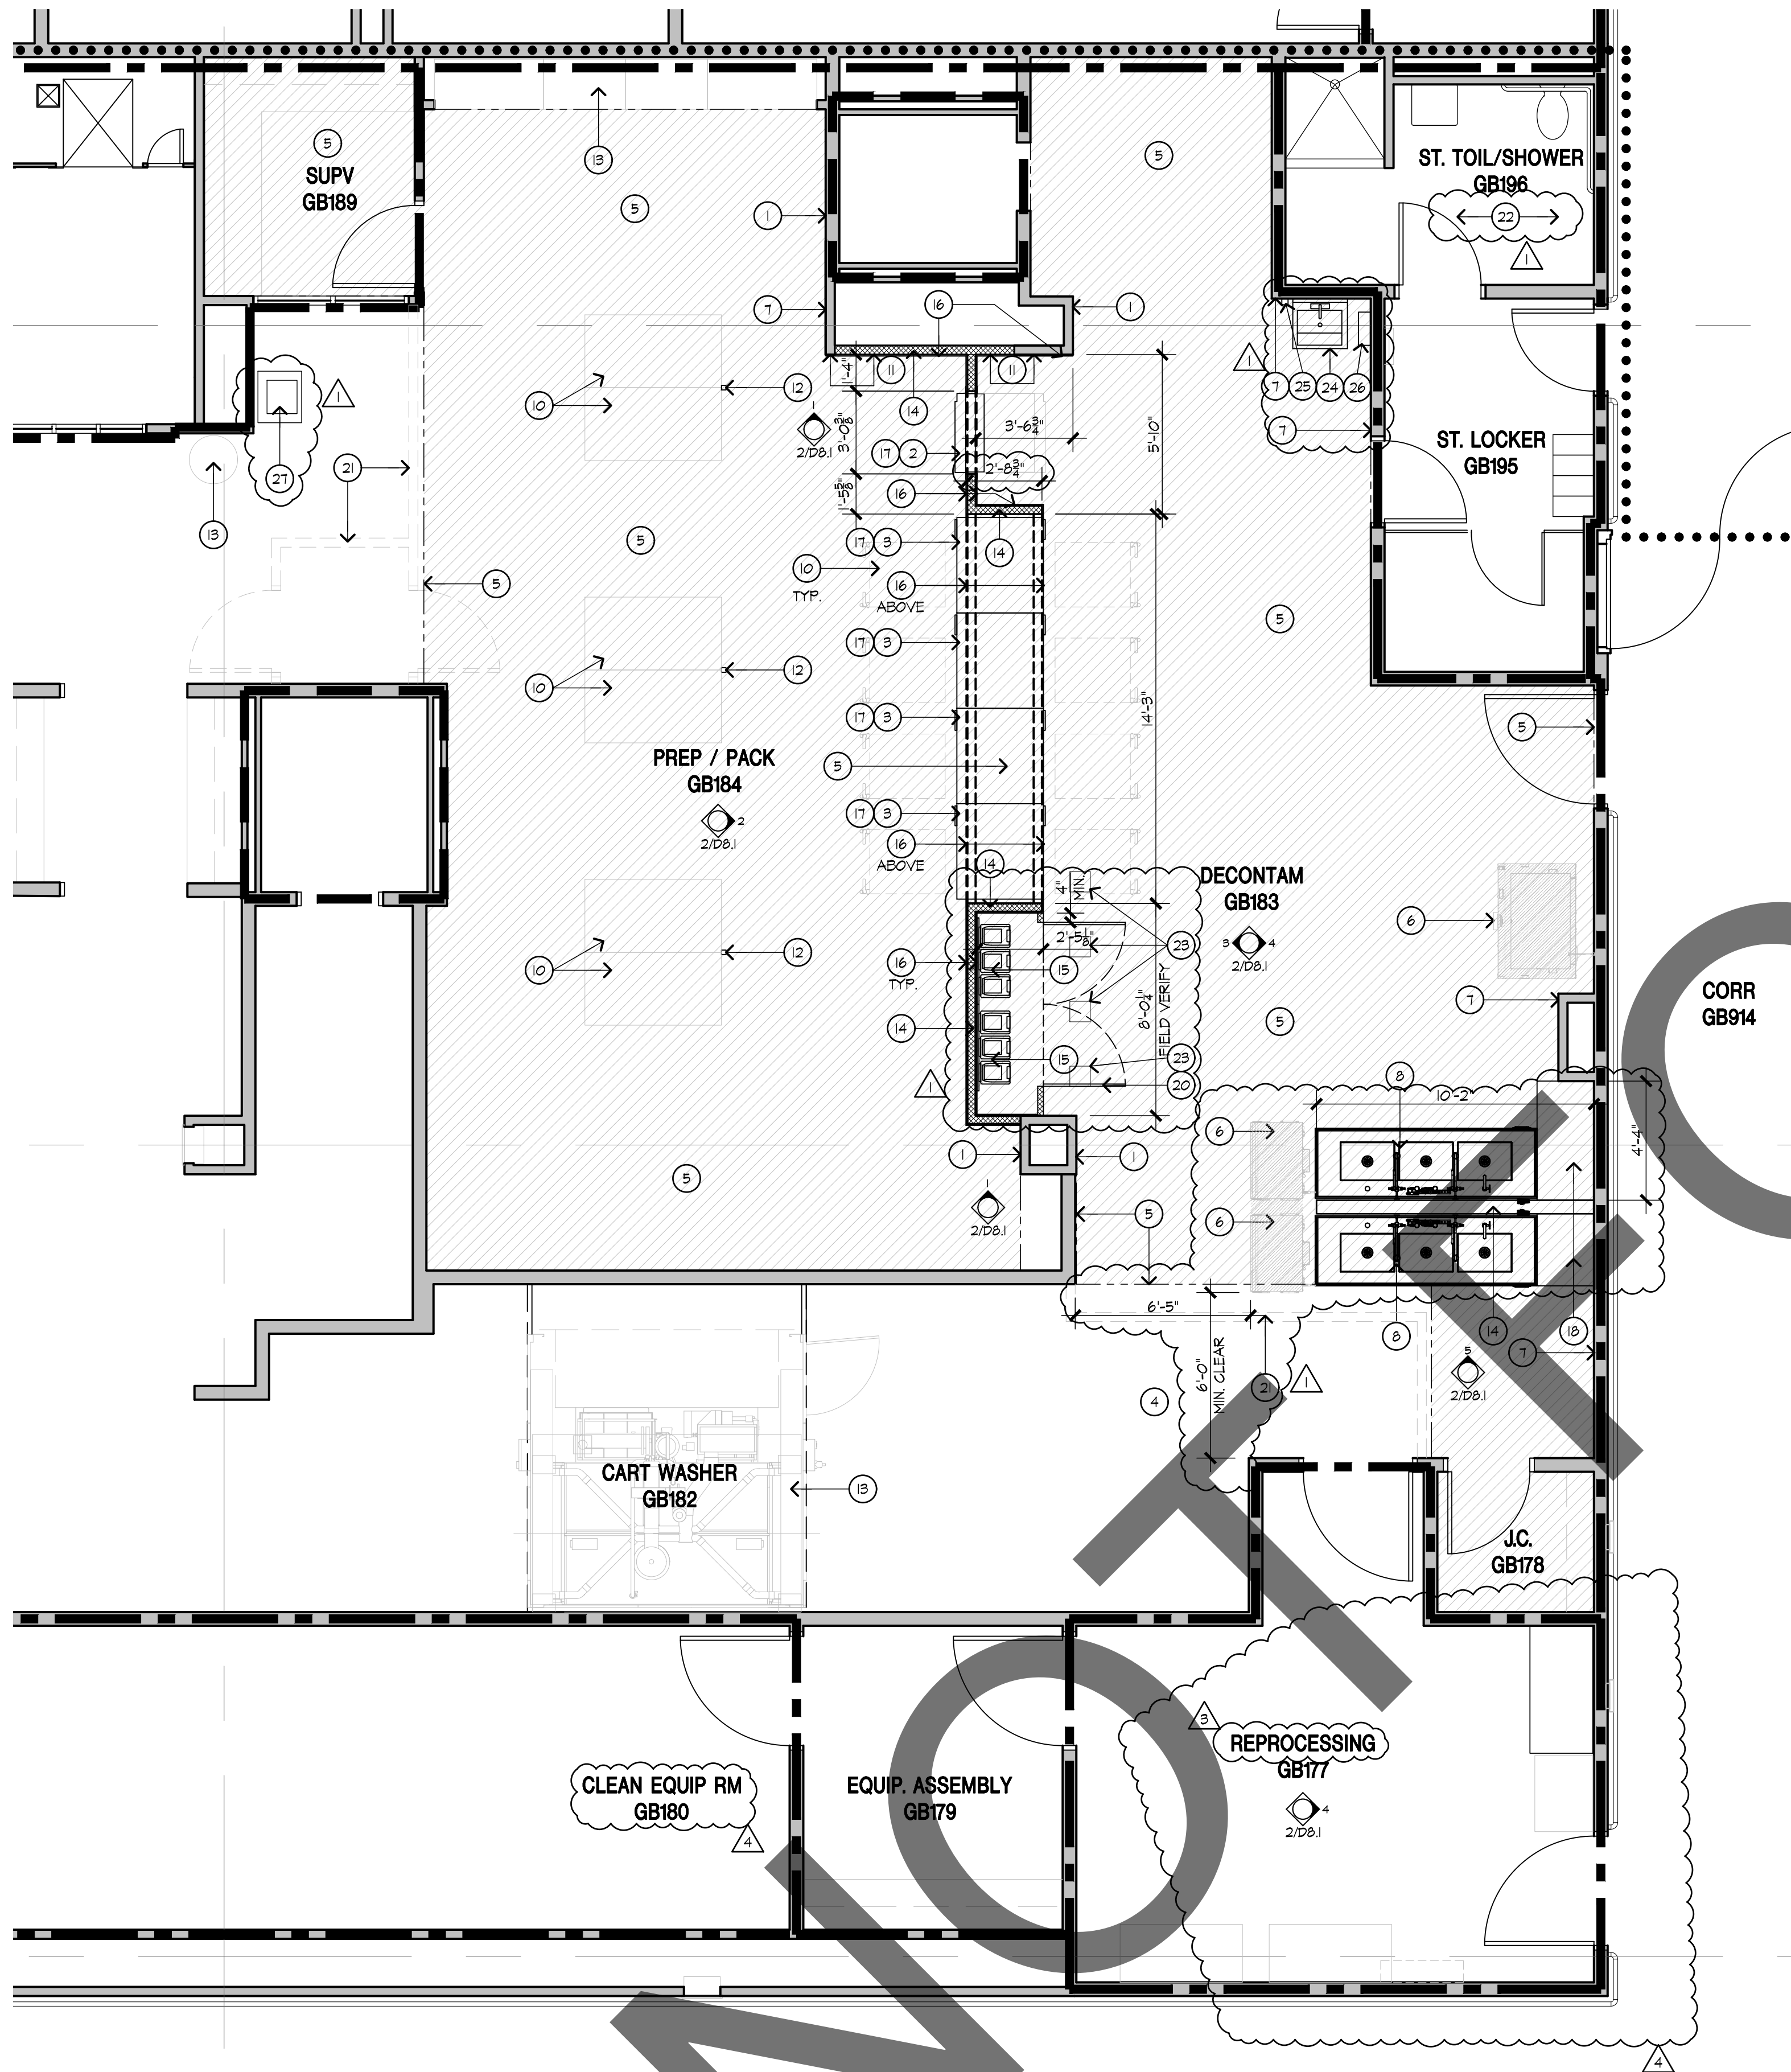


REMODEL FLOOR PLAN

1/4"=1'-0" 1

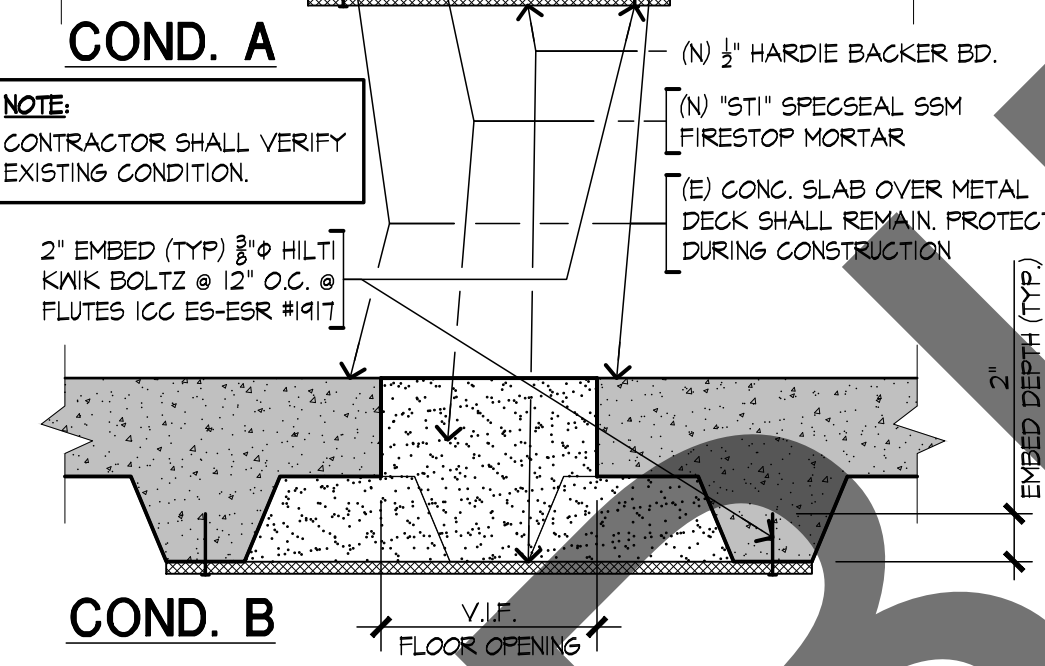

FLOOR SINK REMOVAL FIRESTOP DETAIL

1-1/2"=1'-0" 2

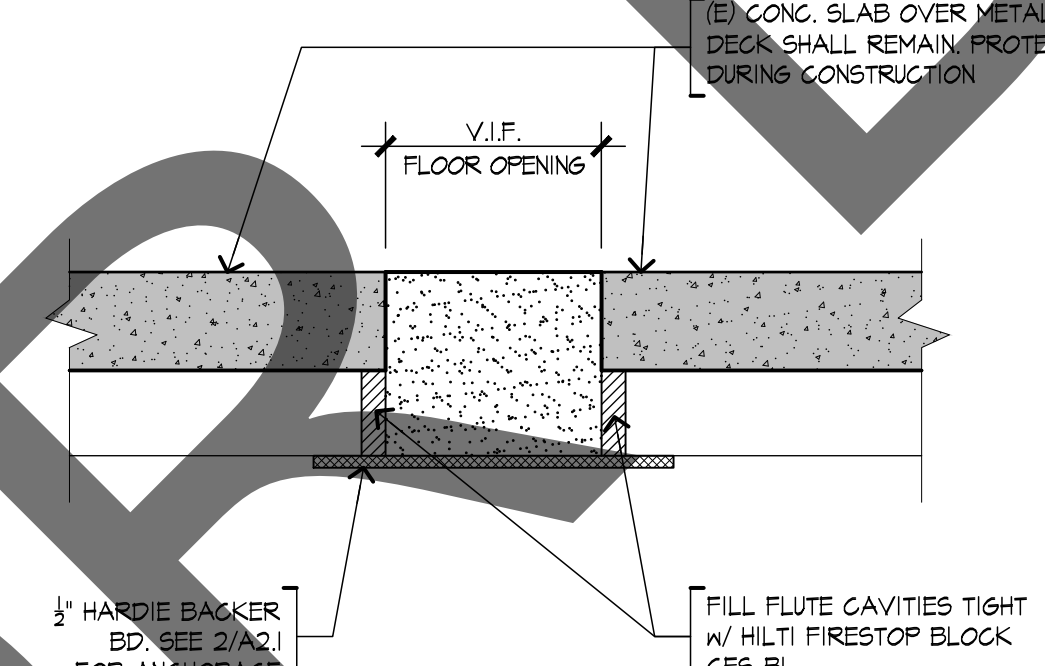

FLOOR SINK REMOVAL FIRESTOP DETAIL

1-1/2"=1'-0" 3

- EXISTING WALL SHALL REMAIN. CONTRACTOR SHALL PROTECT DURING CONSTRUCTION. CONTRACTOR SHALL PATCH AND REPAIR WALL AS REQUIRED AND PROVIDE ONE COAT PRIMER AND TWO COATS ZERO VOC PAINT, COLOR AND FINISH SURFACE SHALL MATCH EXISTING.
- NEW EQUIPMENT - RACK RETURN. VERIFY EQUIPMENT CLEARANCE AND INSTALLATION WITH STERIS REPRESENTATIVE.
- NEW EQUIPMENT - SINGLE CHAMBER WASHER/DISINFECTOR. VERIFY EQUIPMENT CLEARANCE AND INSTALLATION WITH STERIS REPRESENTATIVE.
- EXISTING FINISH FLOORING AND BASE SHALL REMAIN EXCEPT WHERE INDICATED IN NOTE 5. PROTECT FLOORING AND BASE TO REMAIN DURING CONSTRUCTION. BEFORE INSTALLING THE NEW EQUIPMENT, CONTRACTOR SHALL VERIFY THE AREAS THAT NEED PATCHING AND REPAIRING TO THE FLOORING AND BASE.
- REPLACE FLOORING IN THIS AREA. MATCH EXISTING SHEET VINYL FLOORING WITH INTEGRAL COVE/BASE. BEFORE INSTALLING THE NEW EQUIPMENT, CONTRACTOR SHALL IDENTIFY ANY OTHER AREAS THAT NEED PATCHING AND REPAIRING TO THE FLOORING AND BASE. REPAIRS SHALL BE EXECUTED CONCURRENTLY BY THE SAME CONTRACTOR.
- SONIC IRRIGATION EQUIPMENT SHALL BE INSTALLED UNDER SEPARATE PROJECT AND APPROVAL. S22236-36-00, SONIC IRRIGATION REPLACEMENT. THE AOR IS SUBMITTING BOTH THIS PROJECT AND THE SONIC IRRIGATION REPLACEMENT PROJECT TO HCAI FOR SEPARATE APPROVAL BUT CONCURRENT REVIEW. CONSTRUCTION SHALL ALSO BE EXECUTED CONCURRENTLY BY THE SAME CONTRACTOR.
- PATCH AND REPAIR WALL. CONTRACTOR SHALL PATCH AND REPAIR WALL AS REQUIRED WITH 5/8" TYPE X GYPSUM BOARD TO MATCH EXISTING TO REMAINING SURFACES. FLOAT AND REPAINT ALL AFFECTED WALLS WITH ONE COAT PRIMER AND TWO COATS ZERO VOC PAINT, COLOR AND FINISH SURFACE SHALL MATCH EXISTING.
- NEW TRIPLE SINK. SEE PLUMBING AND STRUCTURAL PLANS.
- DELETED.
- NEW ROLLING EQUIPMENT TO BE PROVIDED BY OWNER. NOT IN SCOPE OR WORK.
- ALIGN FRAMING OF NEW WALL TO MATCH EXISTING WALL FOR FLUSH FINISHED WALL SURFACES.
- STAINLESS STEEL POWER AND DATA CHASE. SEE SHEET E8.1.
- EXISTING EQUIPMENT TO REMAIN. PROTECT DURING CONSTRUCTION.
- NEW 6"X10 GA. METAL STUD WALL AT 16" O.C. WITH ONE LAYER OF 5/8" GREEN BOARD ON BOTH SIDES, WITH 10 GA. S.S. SHEET METAL PANELS OVER THE GREEN BOARD. PONY WALL HEIGHT SHALL BE 60".
- DETERGENT DELIVERY SYSTEM. VERIFY WITH STERIS REPRESENTATIVE FOR EXACT LOCATION AND INSTALLATION.
- NEW STAINLESS STEEL MODULAR WALL PANELS: NEW 10 GA. 3/8" METAL STUDS WITH 3" BATT INSULATION WITH 10 GA. S.S. SHEET METAL PANELS ON BOTH SIDES. S.S. SHEET METAL WALL (SOME WALL ONLY HAVE S.S. SHEET METAL ON ONE SIDE. MANUFACTURER SHALL PROVIDE SHOP DRAWINGS TO ARCHITECT FOR REVIEW AND APPROVAL PRIOR TO FABRICATION.
- STERIS SHALL INCLUDE THE FOLLOWING WITHIN THEIR SCOPE OF WORK:
  - DELIVERY AND INSTALLATION OF THE STERIS EVOLUTION STERILIZER EQUIPMENT. EQUIPMENT ARRIVES ASSEMBLED.
  - INSTALLATION OF SEISMIC CONNECTIONS SHOWN ON PLANS WHICH ARE EXPANSION ANCHORS.
  - FINAL CONNECTION OF UTILITIES UP TO TWO (2) FEET FROM THE FINAL POINT OF CONNECTION. COORDINATE CONNECTIONS WITH CONTRACTOR.
  - EXCLUDES FINAL CONNECTION OF ELECTRICAL AND VENT UTILITIES. THAT TASK IS TO BE PERFORMED BY THE CONTRACTOR.
- NEW 10 GA. 430 S.S. COUNTERTOP. IT SHALL BE AN EXTENSION FROM THE SINK. CONTRACTOR SHALL FIELD VERIFY EXACT DIMENSION BEFORE FABRICATING THE COUNTERTOP.
- DELETED.
- DOUBLE 3'-0" X 6'-8-3/4" 10 GA SS ACCESS DOORS BY SS PANEL SUBCONTRACTOR PROVIDE SS HINGES AND LATCHING MECHANISM. LATCH MUST BE ABLE TO KEEP ACCESS DOORS COMPLETELY CLOSED.
- TEMPORARY WALLS MAY BE REMOVED AFTER HCAI ISSUES TEMPORARY CERTIFICATE OF OCCUPANCY. COORDINATE WITH SPD SUPERVISOR BEFORE REMOVING TEMPORARY WALLS.
- EXISTING ACCESSIBLE STAFF TOILETS TO SERVE THE SCOPE OF WORK AREA.
- INFILL EXISTING FLOOR OPENINGS WHERE FLOOR SINKS WERE REMOVED PER DETAILS 2 & 3/A2.1.
- NEW HAND WASH SINK.
- NEW SOAP DISPENSER.
- NEW TOWEL DISPENSER.
- EXISTING HAND WASH SINK.

REMODEL KEYNOTES

- EXISTING WALL TO REMAIN. SEE LIFE SAFETY PLAN FOR WALL TYPES.
- NEW WALL. SEE LIFE SAFETY PLAN FOR WALL TYPES.
- EXISTING ONE-HOUR PARTITION OCCUPANCY SEPARATION WALL.
- EXISTING TWO-HOUR RATED PARTITION AND/OR SHAFTWALLS.
- EXISTING ONE-HOUR RATED SMOKE BARRIER WALL.

WALL LEGEND


PROJECT TITLE  
**STERILIZATION SYSTEM  
INSTALLATION  
FOR THE  
ARROWHEAD REGIONAL  
MEDICAL CENTER**  
400 N. PEPPER AVE.  
COLTON, CA. 92324  
WBSE #10.10.1142 - CIP #21-154 - CAFM #COL003

Department of Health Care Access and Information

HCAI # S222347-36-00



REFERENCE PLAN

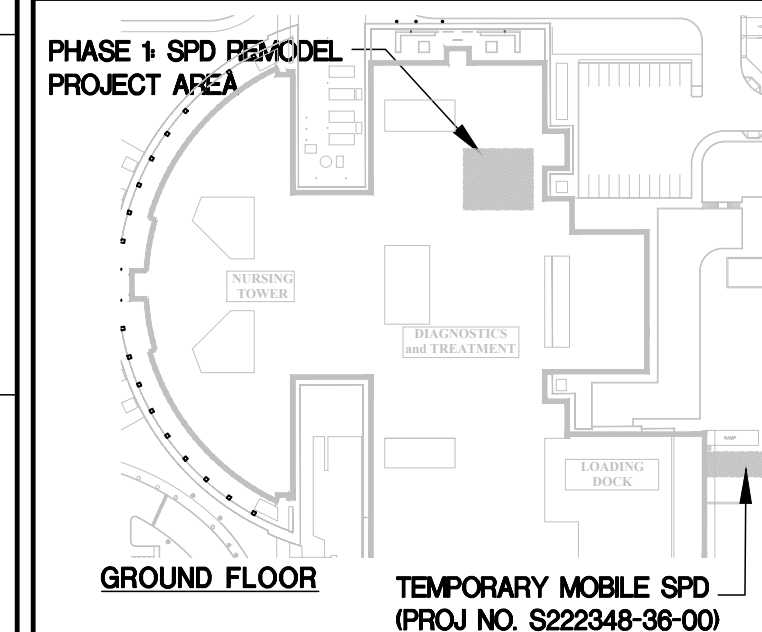

© marks architects, inc. 2022  
ALL REPORTS, PLANS AND DOCUMENTS PREPARED BY MARKS ARCHITECTS, INC. SHALL REMAIN THE PROPERTY OF MARKS ARCHITECTS, INC. AND ARE INTENDED FOR THIS SPECIFIC PROJECT ONLY. OTHER USES ARE PROHIBITED UNLESS OTHERWISE CONTRACTED.

REMODEL  
FLOOR PLAN

DRAWING TITLE

DATE  
**DECEMBER 28, 2022**

REVISIONS

- PLAN CHECK COMMENTS - 02.13.2023
- AMC0001 - 06.13.2023
- PLAN CHECK COMMENTS - 06.27.2023
- PLAN CHECK COMMENTS - 08.15.2023

PROJECT NUMBER  
**3021027**

DRAWING NUMBER



73121 fred waring drive  
suite 200  
palm desert, ca 92260  
760-327-6800




PROJECT NUMBER  
**3021027**

DRAWING NUMBER

**A2.1**



S:\Active Projects\County of San Bernardino\On Call Projects\Arrowhead Regional Medical Center\3021027 ARMC - Sterilizer Installation\3021027 A5.1.dwg Oct 16, 2023 - 11:17am

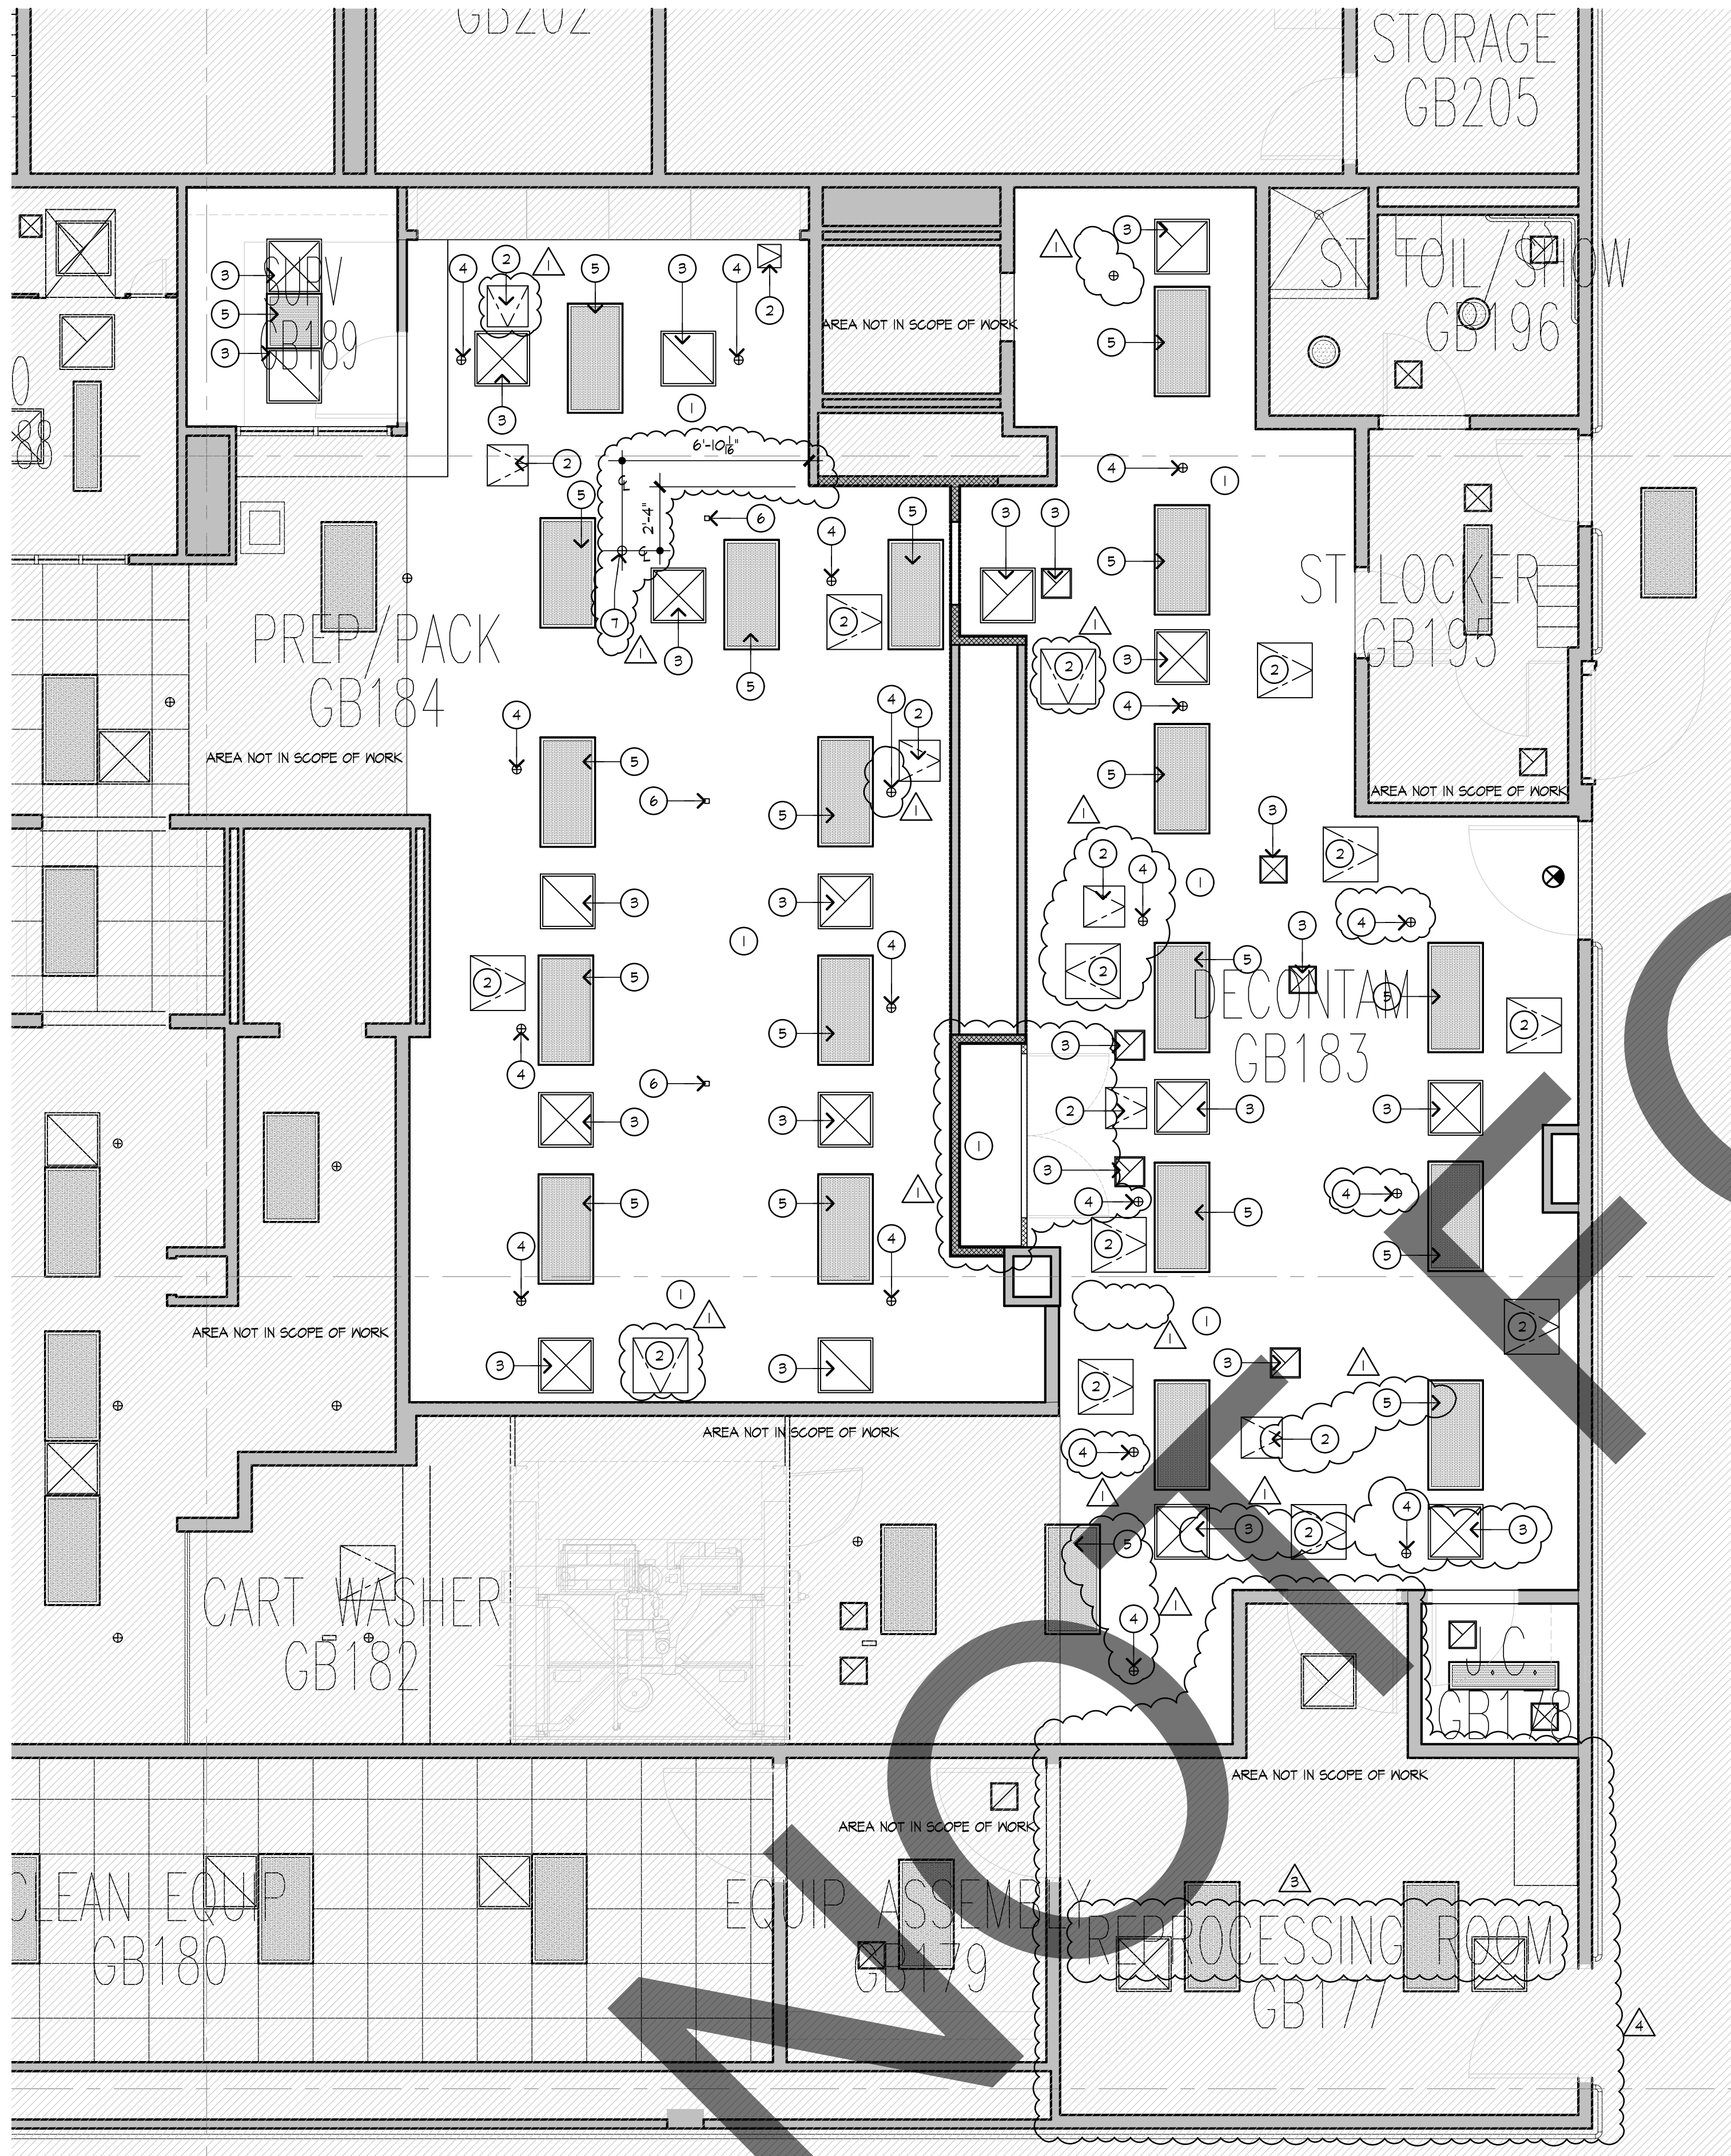

- EXISTING GYP. BD. CEILING SHALL REMAIN. PATCH & REPAIR AS NECESSARY. PAINT WITH ONE COAT PRIMER AND TWO COATS FINISH PAINT TO MATCH EXISTING PAINT.
- EXISTING ACCESS PANEL SHALL REMAIN. PAINT WITH ONE COAT PRIMER AND TWO COATS FINISH PAINT TO MATCH EXISTING CEILING PAINT. PROTECT DURING CONSTRUCTION.
- EXISTING HVAC AIR DIFFUSER AND RETURNS SHALL REMAIN. PAINT WITH ONE COAT PRIMER AND TWO COATS FINISH PAINT TO MATCH EXISTING CEILING PAINT. PROTECT DURING CONSTRUCTION.
- EXISTING FIRE SPRINKLERS SHALL REMAIN. PROTECT DURING CONSTRUCTION.
- EXISTING LIGHT FIXTURES SHALL REMAIN. PROTECT DURING CONSTRUCTION. SEE ELECTRICAL PLANS.
- NEW POWER AND DATA CHASE. SEE ELECTRICAL. PATCH, REPAIR AND PAINT HARD LID CEILING TO MATCH EXISTING ADJACENT CEILING SURFACE.
- NEW FIRE SPRINKLER HEAD TO MATCH EXISTING.

#### REMODEL KEYNOTES

PROJECT TITLE  
**STERILIZATION SYSTEM  
INSTALLATION  
FOR THE  
ARROWHEAD REGIONAL  
MEDICAL CENTER**  
400 N. PEPPER AVE.  
COLTON, CA. 92324  
WBSE #10.10.1142 - CIP #21-154 - CAFM #COL003

#### LEGEND


- INDICATES ROUND RECESSED WALL WASHER.
- INDICATES ROUND RECESSED LIGHT FIXTURE.
- SD ○ INDICATES CEILING, SURFACE MOUNTED SMOKE DETECTOR.
- SP ○ INDICATES CEILING MOUNTED SPEAKER.
- ⊕ INDICATES CEILING MOUNTED FIRE SPRINKLER.
- INDICATES RECESSED 2' X 4' FLUORESCENT LIGHT FIXTURE.
- INDICATES AREA WHERE CABINETS ARE INSTALLED AGAINST SOFFIT.
- ☒ INDICATES CEILING SUPPLY AIR REGISTER.
- ☒ INDICATES CEILING RETURN AIR REGISTER.
- ☒ INDICATES CEILING EXHAUST REGISTER.
- +0'-0" INDICATES HEIGHT OF CEILING ABOVE FINISH SLAB LEVEL, DIRECTLY BELOW CEILING.
- INDICATES LOCATION OF POWER/DATA CHASE.

Department of Health Care Access and Information

HCAI # S222347-36-00



#### REFERENCE PLAN

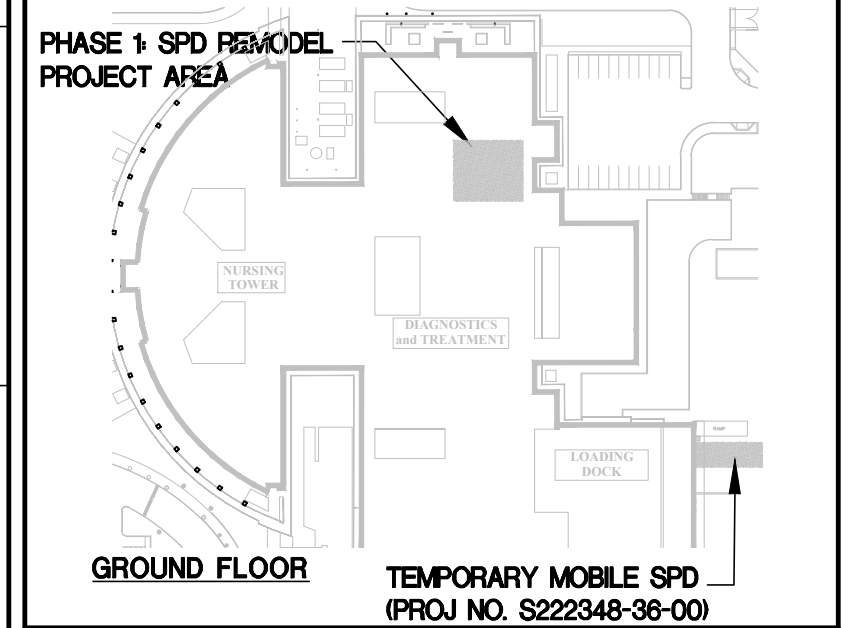

©marks architects, inc. 2022  
ALL REPORTS, PLANS AND DOCUMENTS PREPARED BY MARKS ARCHITECTS, INC. SHALL REMAIN THE PROPERTY OF MARKS ARCHITECTS, INC. AND ARE INTENDED FOR THIS SPECIFIC PROJECT ONLY. OTHER USES ARE PROHIBITED UNLESS OTHERWISE CONTRACTED.

#### REMODEL REFLECTED CEILING PLAN




73121 fred waring drive  
suite 200  
palm desert, ca 92260  
760-327-6800

DATE  
**DECEMBER 28, 2022**

#### REVISIONS

- |   |                                  |
|---|----------------------------------|
| △ | PLAN CHECK COMMENTS - 02.13.2023 |
| △ | AMC0001 - 06.13.2023             |
| △ | PLAN CHECK COMMENTS - 06.27.2023 |
| △ | PLAN CHECK COMMENTS - 06.15.2023 |

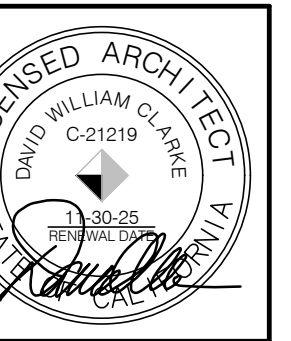

PROJECT NUMBER  
**3021027**

DRAWING NUMBER

**A5.1**

#### REMODEL REFLECTED CEILING PLAN


1/4"=1'-0" 1



## TYPICAL ABBREVIATIONS

(E)	EXISTING	GA.	GAUGE
(N)	NEW	GLV.	GALVANIZED
PL	PLATE	GLB.	GLUE LAMINATED BEAM
A.B.	ANCHOR BOLT	HORIZ.	HORIZONTAL
A/C.	AIR CONDITIONAL	HSS	HOLLOW/TUBULAR STEEL
ARCH.	ARCHITECT/ARCHITECTURAL	INT.	INTERIOR
BLK.	BLOCK	K.P.	KING POST
BLKG.	BLOCKING	L.G.	LONG
BM.	BEAM	LONG.	LONGITUDINAL
BN.	BOUNDARY NAILING	MAX.	MAXIMUM
B.O.B.	BOTTOM OF BEAM	MB.	MACHINE BOLT
BOT.	BOTTOM	MECH.	MECHANICAL
B.S.	BOUNDARY SCREW	MIN.	MINIMUM
CANT.	CANTILEVER	N.T.S.	NOT TO SCALE
CF.	CONTINUOUS FOOTING	ON CENTER	ON CENTER
C.I.P.	CAST IN PLACE CONCRETE	O.H.	OPPOSITE HAND
C.J.	CEILING JOIST/CONTROL JOINT	FF.	FAD FOOTING
CL.	CLEAR	PLYND	PLYWOOD
CL.R.	CLEAR	REIN.	REINFORCING
COL.	COLUMN	REQD.	REQUIRED
CONC.	CONCRETE	R.R.	ROOF RAFTER
CONN.	CONNECTION	SCHED.	SCHEDULE
CONT.	CONTINUOUS	SECT.	SECTION
DIA.	DIAMETER	SIMP.	SIMPSON
DIAG.	DIAGONAL	S.M.S.	SHEET METAL SCREW
DET.	DETAIL	SO.	SQUARE
DP.	DEEP	STD.	STANDARD
DWG.	DRAWING	STIFF.	STIFFENER PLATE
EA.	EACH	STL.	STEEL
EL.	ELEVATION	STRUT	STRUCTURALS
ELEC.	ELECTRICAL	S.T.S.	SELF TAPPING SCREW
EN.	EDGE NAILING	THK.	THICK
EQ.	EQUAL	THRD.	THREADED
E.N.	EACH WAYS	T.O.B.	TOP OF BEAM
EXT.	EXTERIOR	T.O.C.	TOP OF CONCRETE
ENWF.	EXPANDED WELDED WIRE FABRIC	T.O.M.	TOP OF MASONRY
FDN.	FOUNDATION	T.O.P.	TOP OF PARAPET
F.F.	FINISH FLOOR	T.O.S.	TOP OF SHEETING
F.G.	FINISH GRADE	T.O.STL.	TOP OF STEEL
FLR.	FLOOR	T.O.W.	TOP OF WALL
F.N.	FIELD NAILING	TRANS.	TRANSVERSE
F.O.B.	FACE OF BLOCK	T.P.L.	TOP OF PLYWOOD
F.O.C.	FACE OF CONCRETE	TYP.	TYPICAL
F.O.W.	FACE OF WALL	UNO.	UNLESS NOTED OTHERWISE
F.S.	FIELD SCREW	VERT.	VERTICAL
FTG.	FOOTING	W.	WITH
		PL.	PLATE
		Ø	DIAMETER

## STRUCTURAL SYMBOLS / LEGEND

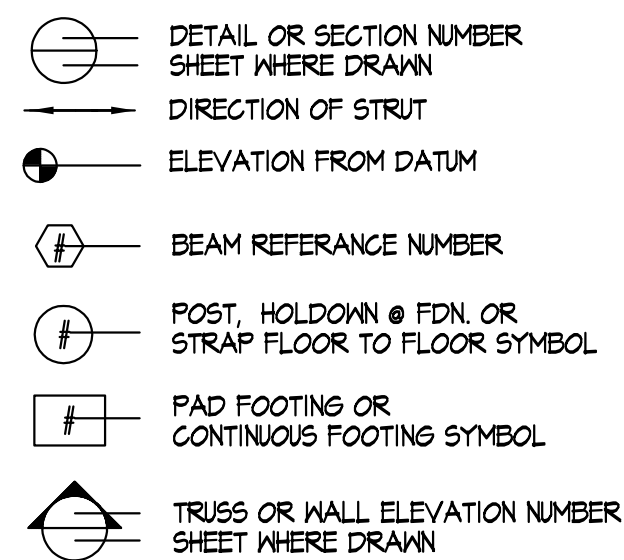

## LATERAL FORCE DESIGN

- ALL WORK SHALL BE DONE IN CONFORMANCE WITH CALIFORNIA BUILDING CODE 2019 C.B.C.
- SEISMIC DESIGN CRITERIA: 2019 C.B.C. WITH SEISMIC COEFFICIENTS PER SECTION 1613 SEISMIC PROVISIONS:  
LATITUDE= 34.0753° N  
LONGITUDE= 117.3513° W  
SITE CLASS= D  
MAPPED SPECTRAL ACCELERATION,  $S_a = 0.2061$  g  
MAPPED SPECTRAL ACCELERATION,  $S_1 = 0.018$  g  
SITE COEFFICIENT,  $F_a = 1.0$   
SITE COEFFICIENT,  $F_v = 1.5$   
MAX SPECTRAL ACCELERATION,  $S_{ms} = 2.473$  g  
DESIGN SPECTRAL ACCELERATION,  $S_{ds} = 1.644$  g  
SEISMIC DESIGN CATEGORY = F  
RISK CATEGORY = IV  
 $I_p = 1.5$

## GENERAL

- THE STRUCTURAL DOCUMENTS REPRESENT THE FINISHED STRUCTURE. THEY DO NOT INDICATE THE METHOD OF CONSTRUCTION. THE CONTRACTOR SHALL PROVIDE ALL MEASURES NECESSARY TO PROTECT THE STRUCTURE DURING CONSTRUCTION. SUCH MEASURES SHALL INCLUDE BUT NOT BE LIMITED TO, BRACING, SHORING FOR LOADS DUE TO CONSTRUCTION EQUIPMENT, ETC. CONTRACTOR WILL BE REQUIRED TO CORRECT AT HIS OWN EXPENSE ANY SUBSIDENCE, STRUCTURAL DAMAGE OR OTHER OBJECTIONABLE CONDITIONS CAUSED BY HIS OPERATIONS.
- ANY CHANGE, MODIFICATION OR ALTERATION OF THESE PLANS SHALL BE AT THE SOLE RISK OF THE PERSON MAKING OR CAUSING THE SAME. ALL CHANGE, MODIFICATION, AND/OR ALTERATION TO THE APPROVED CONSTRUCTION DOCUMENT SHALL BE REVIEWED AND APPROVED BY A LICENSED STRUCTURAL ENGINEER, ARCHITECT OF RECORD AND BY BUILDING & SAFETY PRIOR TO FABRICATION AND INSTALLATION.
- THE OWNER AGREES TO HOLD HARMLESS, INDEMNIFY, AND DEFEND THE ARCHITECT, HIS EMPLOYEES, AND ENGINEERS AGAINST ANY AND ALL LIABILITY, CLAIMS, DAMAGES, AND COST OF DEFENSE ARISING OUT OF THE ERRORS OR OMISSIONS, OR NEGLIGENT ACTS CAUSED BY THE MODIFICATIONS TO THE PLANS AND SPECIFICATIONS.
- ALL WORK SHALL CONFORM TO THE 2019 CALIFORNIA BUILDING CODE STANDARDS, AND THE REGULATIONS OF THE STATE OF CALIFORNIA DIVISION OF INDUSTRIAL SAFETY, AND THOSE CODES AND STANDARDS LISTED IN THESE NOTES.
- THESE NOTES AND SPECIFICATIONS ON STRUCTURAL DRAWINGS GOVERN IN CASE OF CONFLICT WITH OTHER SPECIFICATIONS. NOTIFY ENGINEER OF CONFLICTS WITH OTHER SPECIFICATIONS IMMEDIATELY.
- NOTES AND DETAILS ON STRUCTURAL DRAWINGS SHALL TAKE PRECEDENCE OVER GENERAL NOTES, SPECIFICATIONS AND DETAILS CONSTRUCTION SHALL CONFORM TO SIMILAR WORK ON THE PROJECT.
- THE GENERAL CONTRACTOR SHALL VERIFY ALL DIMENSIONS AND SITE CONDITIONS BEFORE STARTING WORK. ANY DISCREPANCIES SHALL BE REPORTED TO THE ENGINEER/ARCH. IMMEDIATELY.
- DIMENSIONS SHALL TAKE PRECEDENCE OVER SCALES SHOWN ON DRAWINGS. TYPICAL DETAILS AND GENERAL NOTES ARE MINIMUM REQUIREMENTS TO BE USED WHEN CONDITIONS ARE NOT SHOWN OTHERWISE.
- WHERE REFERENCE IS MADE TO VARIOUS TEST STANDARDS FOR MATERIALS, SUCH STANDARDS SHALL BE THE LATEST EDITION AND/OR ADDENDUM.


## LIGHT GAUGE METAL FRAMING:

- THE EXTENT OF THE STRUCTURAL LIGHT GAGE FRAMING IS SHOWN ON THE DRAWINGS AND INCLUDES ALL COLD FORMED FRAMING 22 GA. AND HEAVIER. THE STRUCTURAL LIGHT GAUGE FRAMING INCLUDES BUT IS NOT LIMITED TO: INSTALLATION OF ROOF JOISTS, FLOOR JOISTS, WALL STUDS, AND TRACKS COMPLETE WITH CLIPS, BRIDGING, STIFFENERS, ETC., AS REQUIRED FOR A COMPLETE FRAMING PACKAGE.
- ALL MEMBERS SHALL BE COLD FORMED FROM GALVANIZED STRUCTURAL QUALITY SHEET STEEL MEETING THE REQUIREMENTS OF ASTM A-653 GRADE 33, MINIMUM YIELD OF 33 KSI FOR 18ga. AND LIGHTER, AND MEETING THE REQUIREMENTS OF ASTM A-653 GRADE 50, MINIMUM YIELD OF 50 KSI FOR 16ga. AND HEAVIER. ALL MEMBERS SHALL BE MARKED SO THAT SUPPLIED MATERIALS CAN BE FIELD VERIFIED.
- INSTALLATION:
  - INSTALL STUDS IN CONTINUOUS TRACKS, SIZED TO MATCH STUDS TOP AND BOTTOM, AND SECURE THE STUDS TO THE TRACKS WITH APPROVED CONNECTIONS, INSTALL AS INDICATED ON THE DRAWINGS.
  - DO NOT SPLICE ANY FRAMING MEMBER EXCEPT AS SHOWN ON THE DRAWING OR WITH THE APPROVAL OF THE ENGINEER OF RECORD.
- CONNECTION:
  - WELDS: WELDING SHALL BE IN CONFORMANCE WITH AWS D 13.80. UTILIZING E60XX OR E70XX ELECTRODES. THE ENGINEER OF RECORD MAY REQUEST NON DESTRUCTIVE TEST TO VERIFY PROPER WELDING.
  - SCREWS: ICC ES-ESR #1916 SELF DRILLING AND SELF TAPPING SCREWS CADMIUM PLATED FOR ALL EXTERIOR USES, OF THE SIZE REQUIRED FOR LOADINGS.
  - POUNDER DRIVEN SHOTS: ICC ES-ESR #1663 SIZE AND SPACING AS REQUIRED TO PROPERLY ANCHOR THE FRAMING MEMBERS. USE CHARGE AS APPROPRIATE FOR ACTUAL USE.

## POST-INSTALLED ANCHOR BOLT LOAD TEST:

- ALL CONCRETE ANCHORS BOLTS OF THE EXPANSION TYPE (LOADED IN EITHER PULLOUT OR SHEAR) SHALL HAVE 50 PERCENT OF THE BOLTS (ALTERATIONS BOLTS IN ANY GROUP ARRANGEMENT) PROOF TESTED IN TENSION TO 1 1/4 TIMES THE TENSION STRENGTH. VERIFY AND COORDINATE WITH 2019 CBC SECTION 1905.4 - "IF ANY ANCHOR FAILS TESTING, ALL ANCHORS OF THE SAME TYPE SHALL BE TESTED, WHICH ARE INSTALLED BY THE SAME TRADE, NOT PREVIOUSLY TESTED UNTIL TWENTY (20) CONSECUTIVE ANCHORS PASS, THEN RESUME THE INITIAL TEST FREQUENCY".
- ALL POST INSTALLED ANCHOR IN CONCRETE SHALL HAVE SPECIAL INSPECTION PER 2019 CBC 1705A.5 AND 1705A.1.3 AND MANUFACTURERS REQUIREMENT.
- THE FOLLOWING CRITERIA APPLY FOR THE ACCEPTANCE OF INSTALLED ANCHORS:
  - INSTALLATION TEST METHOD, THE APPLICABLE TEST MUST BE REACHED WITHIN THE FOLLOWING LIMITS:
    - WEDGE OR SLEEVE TYPE, ONE-HALF (1/2) TURN OF THE NUT.
    - ONE-QUARTER (1/4) TURN OF THE NUT FOR THE 3/8 IN. SLEEVE ANCHOR ONLY.
- TESTING SHOULD OCCUR 24HRS AFTER INSTALLATION, TO ALLOW THE ANCHORS TO RELAX AFTER INITIAL SETTING.

TYPE OF MATERIALS	TEST / SPECS.	3/8" Ø 55 KNK BOLT-T22 ICC ES-ESR #4266	1/2" Ø 55 KNK BOLT-T22 ICC ES-ESR #4266	5/8" Ø 55 KNK BOLT-T22 ICC ES-ESR #4266
HARD ROCK CONCRETE 3,000 PSI	DIRECT PULL-TENSION: INSTALLATION TEST: MINIMUM EMBED. DEPTH:	1,144 LBS. 30 FT. LBS 2-1/2"	1,000 LBS. 40 FT. LBS 3 1/4"	1,250 LBS. 60 FT. LBS 3 3/4"

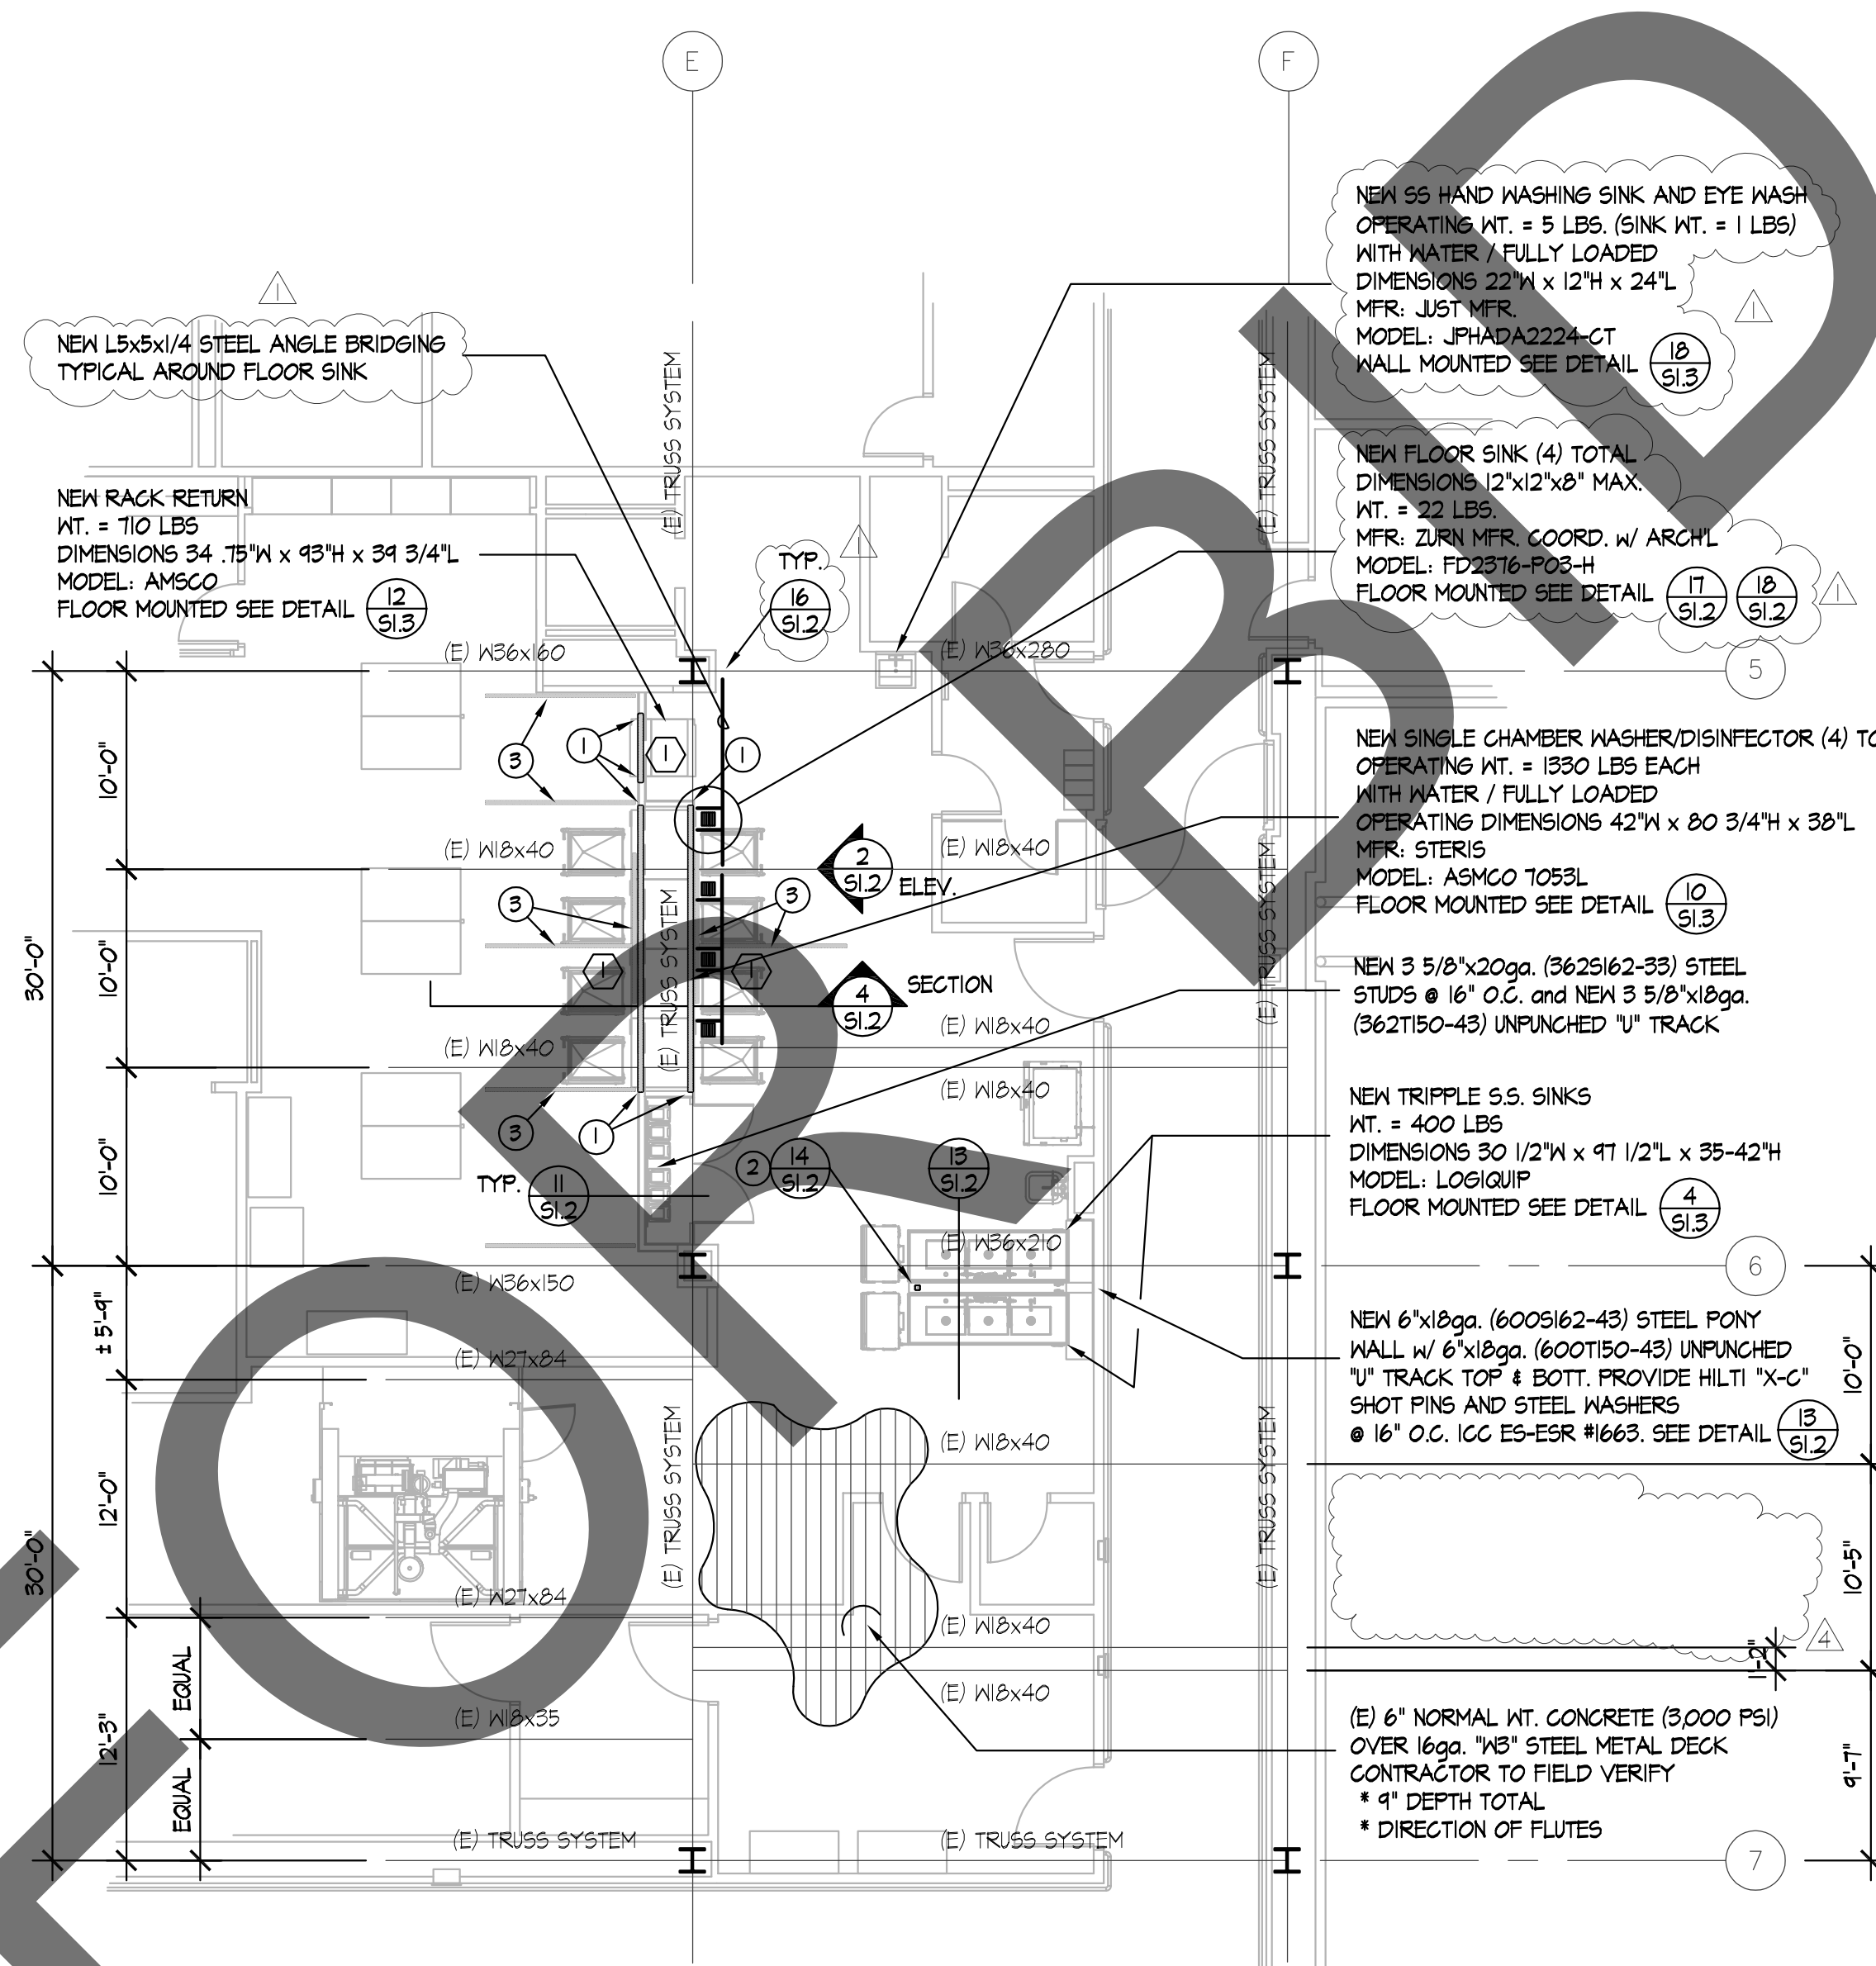

## BOX BEAM &amp; HEADER SCHEDULE

MARK	BOX BEAM BOTH SIDES	TRACK TOP & BOTTOM	MAX. SPAN	DETAIL
①	6"x18ga OR BETTER (600S200-43)	3 5/8"x18ga. OR BETTER (362T150-43)		(8C) (S12)

## STEEL STUD/JOIST/TRACK SCHEDULE, U.N.O.

SIZE	WIDTH	DEPTH	GAUGE	SPACING	MARK
3 5/8" x 18ga.	1 5/8"	3 5/8"	18ga.	16" O.C.	362S162-43
3 5/8" x 18ga.	1 1/2"	3 5/8"	18ga.	TRACK	362T150-43
6" x 18ga.	1 5/8"	6"	18ga.	16" O.C.	600S162-43
6" x 18ga.	1 1/2"	6"	18ga.	TRACK	600T150-43

## POST &amp; HOLDOWN SCHEDULE

MARK	POST/MULTI KING STUD CONT. TO TOP PLATE, TYP., U.N.O.	HOLDOWN	DETAIL/COMMENT
①	DBL. JAMB STUDS		(8A) (8B) (S12) (S12)
②	HSS3x3x1/4		(14) (S12)
③	L3x3x1/4 DIAG. BRACE		(4) (S12)

## IMPORTANT NOTES TO CONTRACTOR:

- COORDINATE WITH ARCHITECTURAL PLANS FOR EQUIPMENT LAYOUT/DIMENSIONS/BRAKETS/SPECS.
- FIELD VERIFY ALL EXISTING MEMBERS \ HARDWARE CALLED OUT ON PLANS AND DETAILS. IF ANY MEMBER \ HARDWARE IS MISSING, NOTIFY ARCHITECT OR EOR IN WRITING OF ANY DISCREPANCIES.

PROJECT TITLE  
**STERILIZATION SYSTEM  
INSTALLATION  
FOR THE  
ARROWHEAD REGIONAL  
MEDICAL CENTER**  
400 N. PEPPER AVE.  
COLTON, CA. 92324  
WBSE #10.10.1142 - CIP #21-154 - CAFM #COL003

CONSULTANT  
**TANG STRUCTURAL  
ENGINEERS, INC.**

7950 CHERRY AVE. SUITE 114 Bldg. (909) 424-0450  
FONTANA, CA. 92336 Email: chentang-se.com  
THESE STRUCTURAL DRAWINGS ARE THE PROPERTY OF TANG STRUCTURAL ENGINEERS, INC. THE USE OF THESE STRUCTURAL PLANS IS RESTRICTED AND LIMITED TO THE ORIGINAL SITE TO WHICH THEY HAVE BEEN PREPARED FOR. THESE STRUCTURAL PLANS MAY NOT BE RE-USED, REPRODUCED, CHANGED, OR COPIED IN WHOLE OR IN PART WITHOUT THE EXPRESSED WRITTEN CONSENT OF THE ENGINEER OF RECORD. COPYRIGHT 2004




Department of Health Care Access and Information

HCAI # S222347-36-00



## REFERENCE PLAN

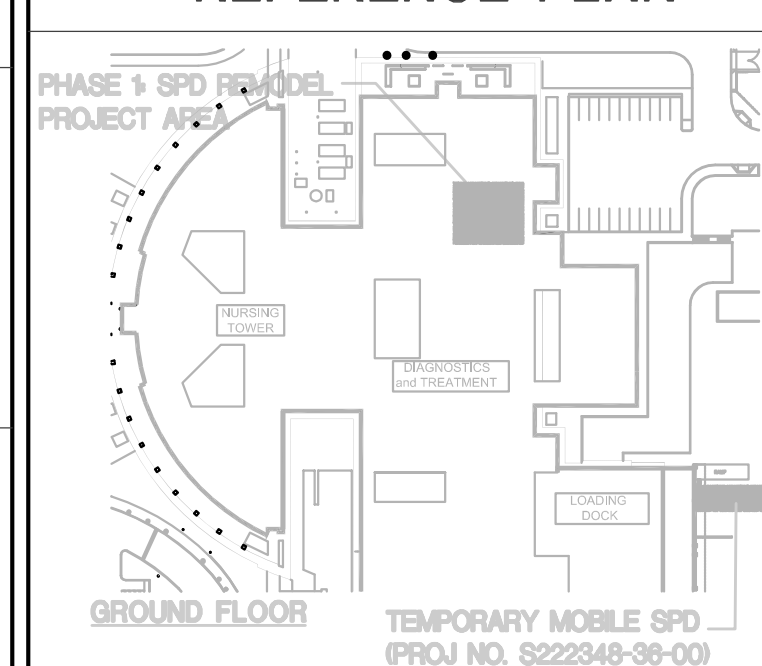

© marks architects, inc. 2022

ALL REPORTS, PLANS AND DOCUMENTS PREPARED BY MARKS ARCHITECTS, INC. SHALL REMAIN THE PROPERTY OF MARKS ARCHITECTS, INC. AND ARE INTENDED FOR THE SPECIFIC PROJECT ONLY. OTHER USES ARE PROHIBITED UNLESS OTHERWISE CONTRACTED.

GENERAL NOTES &  
EQUIPMENT PLAN

DATE  
**DECEMBER 28, 2022**

REVISIONS
1. PLAN CHECK COMMENTS - 02.13.2023
2. AMC0001 - 06.13.2023
3. PLAN CHECK COMMENTS - 06.27.2023
4. PLAN CHECK COMMENTS - 08.15.2023

PROJECT NUMBER  
**3021027**

DRAWING NUMBER



**S1.1**





S1.2



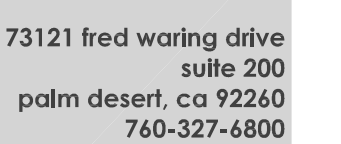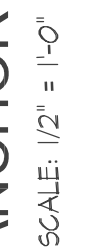

3021027

DRAWING NUMBER

### S1.3



NAME

LEVEL NAME

10'-0"

HEIGHT ABOVE PROJECT 0'-0"

INDICATES NOTE USED TO DESCRIBE ADDITIONAL INFORMATION ABOUT WORK REQUIRED, SPECIFIC TO THE SHEET AND/OR DETAIL

INDICATES DIRECTION OF TRUE NORTH

PLAN OR DETAIL NUMBER

PLAN OR DETAIL NAME

VIEW NAME

1/8" = 1'-0"

PLAN OR DETAIL SCALE

SIM

DETAIL REFERRED TO BY SECTION CUT

M101

SHEET DETAIL IS LOCATED ON

T101

4

3

2

1

LINE TYPE AND TAG KEY:

NEW WORK BY THIS CONTRACTOR (WIDE LINE)

NEW

EXISTING TO BE REMOVED (SHORT DASHED PATTERN)

NEW UNDERFLOOR OR UNDERGROUND (LONG DASHED PATTERN)

EXISTING TO REMAIN OR WORK BY OTHERS (NARROW LINE)

EXISTING

EXISTING TO BE REMOVED BY OTHERS (SHORT DASHED PATTERN)

EXISTING UNDERFLOOR OR UNDERGROUND (LONG DASHED PATTERN)

HALF-DOTTING DOES NOT MODIFY SCORE.

'TAG'(E)

TAGS WITH (E) INDICATE THAT THE REFERENCED OBJECT IS EXISTING

TAG-

UNDENLINED TAG INDICATES OBJECT IS IN SCOPE. IF NEW, ADDITIONAL INFORMATION IS AVAILABLE IN A SCHEDULE, MATERIAL LIST, OR SYMBOL LIST

INDICATES AN EXISTING SYSTEM'S POINT OF CONNECTION/REMOVAL

FIRE / SMOKE BARRIER DESIGNATIONS

THE LINE TYPES SHOWN ARE FOR THE CONVENIENCE OF THE CONTRACTOR. THE CONTRACTOR SHALL VERIFY RATINGS WITH THE LATEST SET OF ARCHITECTURAL PLANS AND FURNISH ALL MATERIALS REQUIRED TO COMPLY WITH THOSE RATINGS WHETHER SHOWN OR NOT.

ALL [FLOOR, FLOOR CEILING, AND ROOF CEILING] ASSEMBLIES SHALL BE DESIGNATED AS [1], [2], [3], [4] HOUR FIRE [SMOKE], BARRIER(S), UNLESS NOTED OTHERWISE ON THE PLANS. RATINGS WERE ACQUIRED FROM THE ARCHITECTURAL PLANS DATED [01/06/22].

EXISTING ONE-HOUR PARTITION OCCUPANCY SEPARATION TO REMAIN.

EXISTING TWO-HOUR RATED PARTITION AND/OR SHAFTWALLS TO REMAIN.

EXISTING ONE-HOUR RATED SMOLE BARRIER WALL TO REMAIN.

CONTRACTOR ABBREVIATION KEY	
ABBR:	DESCRIPTION:
C.M.	CONSTRUCTION MANAGER
E.C.	ELECTRICAL CONTRACTOR
G.C.	GENERAL CONTRACTOR
M.C.	MECHANICAL CONTRACTOR
P.C.	PLUMBING CONTRACTOR

MECHANICAL RENOVATION NOTES:

THESE NOTES APPLY TO ALL MECHANICAL SHEETS AND TRADES, INCLUDING BUT NOT LIMITED TO VENTILATION AND TEMPERATURE CONTROL.

1. EXISTING CONDITIONS ARE SHOWN BASED ON INFORMATION OBTAINED FROM FIELD SURVEYS, EXISTING BUILDING DOCUMENTS, AND STAFF. VERIFY EXISTING CONDITIONS AND REPORT ANY CONFLICTS BEFORE PROCEEDING.

2. NOT ALL EXISTING DUCTWORK AND PIPING IS SHOWN. VERIFY EXISTING CONDITIONS BEFORE STARTING WORK. NOTIFY ENGINEER OF ANY CONFLICTS WITH NEW WORK.

3. FIELD VERIFY THE AVAILABLE CLEARANCES FOR DUCTWORK AND PIPING BEFORE FABRICATION. RISES AND DROPS MAY BE NECESSARY BECAUSE OF EXISTING FIELD CONDITIONS.

4. EACH CONTRACTOR SHALL FIELD VERIFY ACCESSIBILITY TO THE AREA OF THEIR WORK AND SHALL NOTIFY THE GENERAL CONTRACTOR PRIOR TO BIDDING IF OTHER UTILITIES ARE REQUIRED TO BE REMOVED OR RELOCATED TO ALLOW ACCESS TO THEIR AREA OF WORK.

5. THE GENERAL CONTRACTOR IS RESPONSIBLE FOR CUTTING, REMOVAL AND PATCHING OF ROOFS, WALLS, AND FLOORS ASSOCIATED WITH WORK BY ALL CONTRACTORS.

6. THE GENERAL CONTRACTOR IS RESPONSIBLE FOR REMOVAL AND REPLACEMENT OF CEILINGS, CEILING TILES, AND CEILING GRIDS ASSOCIATED WITH AREAS OF WORK BY ALL CONTRACTORS. NOTIFY THE GENERAL CONTRACTOR OF AFFECTED AREAS PRIOR TO BIDDING.

7. WHERE EXISTING MECHANICAL SYSTEMS ARE LOCATED IN AREAS THAT CONFLICT WITH NEW EQUIPMENT, PIPING, OR DUCTWORK IN SUCH A FASHION THAT IT DOES NOT CONFLICT WITH EXISTING SYSTEMS, OR REWORK EXISTING MECHANICAL SYSTEMS TO ALLOW FOR INSTALLATION OF NEW EQUIPMENT, PIPING, OR DUCTWORK.

8. PROVIDE TEMPORARY CONNECTIONS TO MAINTAIN EXISTING SYSTEMS IN SERVICE DURING CONSTRUCTION. MAINTAIN ACCESS TO EXISTING MECHANICAL INSTALLATIONS THAT REMAIN ACTIVE.

9. OBTAIN PERMISSION FROM OWNER BEFORE SHUTTING DOWN ANY SYSTEM FOR ANY REASON. MAINTAIN SERVICE TO ALL COMPONENTS THAT ARE TO REMAIN UNTIL NEW SYSTEMS ARE INSTALLED.

10. MAINTAIN EXISTING SYSTEMS IN SERVICE UNTIL NEW SYSTEM IS COMPLETE AND READY FOR TIE IN AND SWITCHOVER. DRAIN SYSTEM ONLY TO MAKE SWITCHOVERS AND CONNECTIONS. OBTAIN PERMISSION FROM OWNER BEFORE PARTIALLY OR COMPLETELY DRAINING SYSTEM. MAKE CHANGEOVER TO NEW SYSTEMS WITH MINIMUM OUTAGE.

11. DISCONNECT AND REMOVE MECHANICAL DEVICES AND EQUIPMENT SERVING EQUIPMENT THAT HAS BEEN REMOVED.

TAB PRE-DEMOLITION NOTES:

1. BEFORE ANY DEMOLITION WORK IS BEGUN A COMPLETE AIR BALANCE TEST SHALL BE PERFORMED BY THE TESTING, ADJUSTING AND BALANCING (TAB) CONTRACTOR ON EXISTING AIR HANDLERS AND EXHAUST FANS SERVING THE AREAS AFFECTED BY CONSTRUCTION. EQUIPMENT TO BE DEMOLISHED DOES NOT REQUIRE TESTING. PROVIDE AIR BALANCE TESTING ONLY ON EQUIPMENT THAT WILL CONTINUE TO BE USED TO SERVE RENOVATED AREAS AFTER THE CONSTRUCTION PHASE IS COMPLETED.

2. PROVIDE DUCT TRAVERSE READINGS AT LOCATIONS DESIGNATED ON THE DRAWINGS BY THE "AIRFLOW MEASUREMENT SYMBOL". THOSE MEASUREMENTS SHALL BE INCLUDED IN THE PRE-DEMOLITION REPORT AND SHALL BE DESIGNATED WITH THE IDENTIFIER AS MARKED ON THE DRAWINGS. READINGS SHALL BE DESIGNATED WITH THE ROOM NAME AND NUMBER AS MARKED ON THE DRAWINGS. IF FLOOR PLANS DO NOT HAVE UNIQUE ROOM NAMES AND NUMBERS, TAB CONTRACTOR SHALL INCLUDE FLOOR PLAN WITH UNIQUE NUMBER DESIGNATIONS ASSIGNED TO READINGS THAT MATCH THOSE USED IN THE FINAL PRE-DEMOLITION REPORT. DRAWINGS THAT ARE HAND-MARKED WITH RED INK ARE ACCEPTABLE, PROVIDED THEY ARE LEGIBLE.

3. IN THE EVENT A DUCT TRAVERSE LOCATION AS MARKED ON THIS PLAN IS INACCESSIBLE FOR MEASUREMENT, THE TAB CONTRACTOR SHALL PERFORM THE TRAVERSE AT AN ALTERNATE LOCATION OR SHALL TAKE MULTIPLE DUCT TRAVERSES AND/OR READINGS AS REQUIRED TO DETERMINE THE AIRFLOW READING WHERE THE DUCT TRAVERSE SYMBOL IS SHOWN. IN THE EVENT TRAVERSES ARE TAKEN AT ALTERNATE LOCATION(S), TAB CONTRACTOR SHALL INCLUDE A DRAWING THAT SHOWS THE LOCATIONS WHERE THE ACTUAL MEASUREMENTS WERE TAKEN.

4. TAKE A DUCT STATIC PRESSURE READING AT EACH LOCATION WHERE A DUCT TRAVERSE READING IS TAKEN AND INCLUDE IN THE FINAL PRE-DEMOLITION TAB REPORT.

5. TAB CONTRACTOR SHALL COMPARE AND SUBMIT FOUR COPIES OF THE FINAL PRE-DEMOLITION REPORT WITHIN 10 WORKING DAYS AFTER THE FIELD MEASUREMENTS ARE COMPLETED. FINAL TAB REPORT SHALL BE SUBMITTED FOR REVIEW TO THE ARCHITECT/ENGINEER. TESTING SHALL INCLUDE ALL ITEMS REQUIRED IN THE SPECIFICATIONS.

6. TAB CONTRACTOR SHALL PROVIDE DUCT TRAVERSE READINGS AT LOCATIONS DESIGNATED ON THE DRAWINGS BY THE "AIRFLOW MEASUREMENT SYMBOL". THOSE MEASUREMENTS SHALL BE INCLUDED IN THE POST-CONSTRUCTION REPORT AND SHALL BE DESIGNATED WITH THE IDENTIFIER AS MARKED ON THE CONSTRUCTION DRAWINGS. GRILLE AND DIFFUSER READINGS SHALL BE DESIGNATED WITH THE ROOM NAME AND NUMBER AS MARKED ON THE DRAWINGS. IF THE DRAWINGS DO NOT HAVE UNIQUE ROOM NAMES AND NUMBERS, TAB CONTRACTOR SHALL INCLUDE FLOOR PLANS WITH UNIQUE NUMBER DESIGNATIONS ASSIGNED TO TRAVERSES, GRILLES, AND DIFFUSERS THAT MATCH THOSE USED IN THE FINAL PRE-DEMOLITION REPORT. SIMILAR ROOM NAMES, NUMBERS, OR DESIGNATIONS SHALL BE USED TO SIMPLIFY THE CROSS-REFERENCING OF READINGS TAKEN BETWEEN PRE-DEMOLITION AND POST-CONSTRUCTION REPORTS.

7. BALANCING CONTRACTOR SHALL PRE-BALANCE ALL EXISTING SYSTEMS TO REMAIN PER SPECIFICATION SECTION 23 05 93. BALANCE READINGS WILL BE REQUIRED AT AIR OUTLETS AND DUCT TRAVERSES TO VERIFY EXISTING AIRFLOW TO UNAFFECTED SPACES.

TAB POST-CONSTRUCTION NOTES:

1. AFTER CONSTRUCTION ACTIVITIES ARE COMPLETE, TESTING, ADJUSTING (TAB) AND BALANCING CONTRACTOR SHALL REBALANCE AIR HANDLING UNITS AND EXHAUST FANS AS REQUIRED TO ACHIEVE THE NEW AIRFLOW VALUES SHOWN ON THE CONSTRUCTION DRAWINGS.

2. AREAS SERVED BY THIS EQUIPMENT WHICH WERE NOT RENOVATED SHALL BE RE-BALANCED TO THE AIRFLOW RATES MEASURED BEFORE THE RENOVATION OCCURRED (REFER TO THE FINAL PRE-DEMOLITION REPORT).

3. IF DUCT TRAVERSE LOCATION AS MARKED ON THE DRAWINGS IS INACCESSIBLE FOR MEASUREMENT, THE TAB CONTRACTOR SHALL PERFORM THE TRAVERSE AT AN ALTERNATE LOCATION OR SHALL TAKE MULTIPLE DUCT TRAVERSES AND/OR GRILLE READINGS AS REQUIRED TO DETERMINE THE FLOW RATE. IN THE EVENT TRAVERSES ARE TAKEN AT AN ALTERNATE LOCATION(S), TAB CONTRACTOR SHALL INCLUDE A DRAWING THAT SHOWS THE LOCATIONS WHERE THE ACTUAL MEASUREMENTS WERE TAKEN.

4. A DUCT STATIC PRESSURE READING SHALL BE TAKEN AT EACH LOCATION WHERE A DUCT TRAVERSE READING IS TAKEN AND SHALL BE INCLUDED IN THE FINAL POST-CONSTRUCTION TAB REPORT.

5. TAB CONTRACTOR SHALL COMPILE AND SUBMIT COPIES OF THE FINAL POST-CONSTRUCTION TAB REPORT AS REQUIRED BY SECTION 23 05 93.

6. THE FINAL POST CONSTRUCTION REPORT SHALL INCLUDE ALL ITEMS REQUIRED IN THE SPECIFICATIONS.

VENTILATION GENERAL NOTES:

1. EXISTING AIR INLET AND OUTLET CFM SHOWN ON DRAWINGS ARE FROM PRE-BALANCE VALUES INDICATED ON AIR MANAGEMENT INDUSTRIES(AMI) HVAC SYSTEM SURVEY DATED DECEMBER 14, 2021.

2. CONTRACTOR MAY REUSE PORTIONS OF EXISTING DUCT PROVIDED SIZES AND PRESSURE CLASSES ARE CORRECT, DUCT IS THOROUGHLY CLEANED AND FREE OF DEFECTS, AND ALL TRANSVERSE JOINTS, LONGITUDINAL SEAMS, AND DUCT WALL PENETRATIONS ARE SEALED AS SPECIFIED FOR NEW DUCTWORK.

MECHANICAL GENERAL NOTES:

THESE NOTES APPLY TO ALL MECHANICAL SHEETS AND TRADES, INCLUDING BUT NOT LIMITED TO, FIRE PROTECTION, PLUMBING, MEDICAL GAS, VENTILATION, PIPING AND TEMPERATURE CONTROL.

1. DRAWINGS SHOWING LOCATIONS OF EQUIPMENT, DUCTWORK, PIPING, ETC. ARE DIAGRAMMATIC AND MAY NOT ALWAYS REFLECT EXACT INSTALLATION CONDITIONS. DRAWINGS SHOW THE GENERAL ARRANGEMENT OF DUCTWORK, PIPING, EQUIPMENT, ETC., AND MAY NOT INCLUDE ALL OFFSETS AND FITTINGS REQUIRED FOR COMPLETE INSTALLATION. THE DRAWINGS SHALL BE FOLLOWED AS CLOSELY AS ACTUAL BUILDING CONSTRUCTION AND THE WORK OF OTHERS WILL PERMIT.

2. DO NOT SCALE DRAWINGS. VERIFY ALL DIMENSIONS AND CLEARANCES FROM ARCHITECTURAL, STRUCTURAL, SUBMITTALS, AND OTHER APPROPRIATE DRAWINGS OR PHYSICALLY AT SITE. REVIEW ALL DRAWINGS, INCLUDING THOSE OF OTHER TRADES.

3. COORDINATE ALL WORK WITH ALL OTHER TRADES PRIOR TO INSTALLATION TO PROVIDE CLEARANCES REQUIRED FOR OPERATION, MAINTENANCE, CODE COMPLIANCE, AND TO VERIFY NON-INTERFERENCE WITH OTHER WORK. DO NOT FABRICATE PRIOR TO VERIFICATION OF NECESSARY CLEARANCES FOR ALL TRADES. BRING ANY INTERFERENCES OR CONFLICTS TO THE ATTENTION OF THE ARCHITECT/ENGINEER BEFORE PROCEEDING WITH FABRICATION OR EQUIPMENT ORDERS.

4. REVIEW SPACE REQUIREMENTS OF EQUIPMENT SPECIFIED OR SUBSTITUTED AND MAKE REASONABLE ACCOMMODATIONS IN LAYOUT AND POSITIONING TO PROVIDE PROPER ACCESS.

5. ANY CHANGES REQUIRED TO ELIMINATE CONFLICTS OR THAT RESULT FROM A FAILURE TO COORDINATE SHALL BE MADE BY THE CONTRACTOR WITHOUT ADDITIONAL COST OR EXPENSE TO OTHERS.

6. EACH CONTRACTOR IS RESPONSIBLE FOR ALL COSTS ASSOCIATED WITH ELECTRICAL CHANGES REQUIRED FOR EQUIPMENT PROPOSED THAT DIFFERS FROM THE BASIS OF DESIGN.

7. REFER TO ARCHITECTURAL REFLECTED CEILING PLAN, ELECTRICAL, TECHNOLOGY AUDIO/VISUAL, AND OTHER MECHANICAL PLANS FOR EXACT LOCATIONS OF ALL CEILING MOUNTED DEVICES, OTHER THAN SPRINKLERS.

8. EACH CONTRACTOR IS RESPONSIBLE FOR DAMAGE CAUSED BY THEIR ACTIONS TO WALLS, FLOORS, CEILINGS, AND ROOFS. THE CONTRACTOR WHOSE WORK CAUSES DAMAGE IS RESPONSIBLE FOR PATCHING TO MATCH ORIGINAL CONSTRUCTION, FIRE RATING, AND FINISH.

9. IN AREAS WITH DRYWALL CEILINGS COORDINATE LOCATIONS OF ACCESS PANELS WITH THE GC FOR ACCESS TO VALVES, DUCTWORK ACCESSORIES, DAMPERS, ETC. COORDINATE PANEL TYPE AND COLOR WITH ARCHITECT. NOTIFY THE GC OF THE REQUIRED ACCESS PANELS PRIOR TO BIDDING.

10. SEAL ALL FLOOR AND WALL PENETRATIONS AIRTIGHT WHERE CONDUITS, PIPING, AND DUCTS PENETRATE. CAULK ALL PIPE AND DUCT PENETRATIONS OF FULL-HEIGHT NON-FIRE RATED WALL, PARTITION, FLOOR, AND ROOF ASSEMBLIES. THIS IS ESSENTIAL TO PREVENT NOISE TRANSMISSION FROM ONE ROOM TO ANOTHER AND TO PROVIDE THE DESIRED NC LEVELS WITHIN ROOMS.

11. WHERE PIPES AND DUCTS ARE SHOWN TO PENETRATE FLOORS, PROVIDE SLEEVED OPENINGS WITH THE TOP EDGE RAISED ABOVE FLOOR SURFACE IN ACCORDANCE WITH ALL RELEVANT SPEC SECTIONS. SEAL SLEEVE PERIMETER TO BE WATERTIGHT.

12. EQUIPMENT SIZES AND SERVICE CLEARANCE REQUIREMENTS VARY AMONG DIFFERENT MANUFACTURERS. CONSULT APPROVED SHOP DRAWINGS FOR EQUIPMENT SIZES AND REQUIRED SERVICE CLEARANCES. COORDINATE WITH LAYOUT OF EQUIPMENT PADS, PIPING, DUCTWORK, ETC.

13. DO NOT BLOCK TUBE PULL OR EQUIPMENT SERVICE CLEARANCES.

14. MAINTAIN A MINIMUM WORKING CLEARANCE OF 3'-6" IN FRONT OF ALL ELECTRICAL EQUIPMENT REQUIRING MAINTENANCE, INSPECTION, AND TESTING INCLUDING BUT NOT LIMITED TO PANELS, DISTRIBUTION PANELS, SWITCHBOARDS, MOTOR CONTROL CENTERS, TRANSFORMERS, EQUIPMENT DISCONNECTS AND STARTERS.

15. MAINTAIN THE DEDICATED ELECTRICAL EQUIPMENT SPACE DEFINED BY THE WIDTH / DEPTH OF ELECTRICAL EQUIPMENT MEASURED FROM THE FLOOR TO A HEIGHT 6'-0" ABOVE THE EQUIPMENT OR THE STRUCTURAL CEILING, WHICHEVER IS LOWER. SYSTEMS FOREIGN TO THE ELECTRICAL DISTRIBUTION SYSTEM ARE NOT ALLOWED IN THE DEDICATED ELECTRICAL SPACE INCLUDING: DUCTWORK, PIPING, ETC.

16. PROVIDE CONCRETE EQUIPMENT PAD FOR ALL FLOOR MOUNTED EQUIPMENT. PAD SHALL EXTEND MINIMUM 6" BEYOND ALL SIDES OF EQUIPMENT.

17. DO NOT SUPPORT EQUIPMENT, PIPING, OR DUCTWORK FROM METAL DECKING OR OTHER NON-STRUCTURAL BUILDING ELEMENTS. ANCHORS EMBEDDED IN CONCRETE SHALL BE CRACKED CONCRETE APPROVED IN ACCORDANCE WITH SPECIFICATIONS.

ME COMPONENT ANCHORAGE NOTES:

1. EQUIPMENT ANCHORAGE NOTE:

ALL MECHANICAL, PLUMBING, AND ELECTRICAL COMPONENTS SHALL BE ANCHORED AND INSTALLED PER THE DETAILS ON THE HCAI APPROVED CONSTRUCTION DOCUMENTS. THE FOLLOWING COMPONENTS SHALL BE ANCHORED OR BRACED TO MEET THE FORCE AND DISPLACEMENT REQUIREMENTS PRESCRIBED IN THE 2019 CBC, SECTION 1616A.18 THROUGH 1616A.1.26 AND ASCE 7-16 CHAPTERS 13.26, AND 30.

1. ALL PERMANENT EQUIPMENT AND COMPONENTS.

2. TEMPORARY, MOVABLE OR MOBILE EQUIPMENT THAT IS PERMANENTLY ATTACHED (E.G. HARDWIRED) TO THE BUILDING UTILITY SERVICES SUCH AS ELECTRICITY, GAS OR WATER. "PERMANENTLY ATTACHED" SHALL INCLUDE ALL ELECTRICAL CONNECTION EXCEPT PLUGS FOR 110/220 VOLT RECEPTACLES HAVING A FLEXIBLE CABLE.

3. TEMPORARY, MOVABLE OR MOBILE EQUIPMENT WHICH IS HEAVIER THAN 400 POUNDS OR HAS A CENTER MASS LOCATED 4 FEET OR MORE ABOVE THE ADJACENT FLOOR OR ROOF LEVEL THAT DIRECTLY SUPPORT THE COMPONENTS IS REQUIRED TO BE RETAINED IN A MANNER APPROVED BY HCAI.

THE FOLLOWING MECHANICAL AND ELECTRICAL COMPONENTS SHALL BE POSITIVELY ATTACHED DOT THE STRUCTURE, BUT NEED NOT DEMONSTRATE DESIGN COMPLIANCE WITH THE REFERENCES NOTES ABOVE. THESE COMPONENTS SHALL HAVE FLEXIBLE CONNECTIONS PROVIDED BETWEEN THE COMPONENT AND ASSOCIATED DUCTWORK, PIPING, AND CONDUIT. FLEXIBLE CONNECTIONS MUST ALLOW MOVEMENT IN BOTH TRANSFERS AND LONGITUDINAL DIRECTIONS.

A. COMPONENTS WEIGHING LESS THAN 400 POUNDS AND HAVE A CENTER OF MASS LOCATED 4 FEET OR LESS ABOVE THE ADJACENT FLOOR OR ROOF LEVEL THAT DIRECTLY SUPPORT THE COMPONENT.

B. COMPONENTS WEIGHING LESS THAN 20 POUNDS, OR IN THE CASE OF DISTRIBUTED SYSTEMS, LESS THAN 6 POUNDS PER FOOT, WHICH ARE SUSPENDED FROM A ROOF OR FLOOR OR HUNG FROM A WALL.

THE ANCHORAGE OF ALL MECHANICAL, ELECTRICAL, AND PLUMBING COMPONENTS SHALL BE SUBJECT TO THE APPROVAL OF THE DESIGN PROFESSIONAL IN GENERAL RESPONSIBLE CHARGE OF STRUCTURAL ENGINEER DELEGATE RESPONSIBILITY AND ACCEPTANCE BY DSA. THE PROJECT INSPECTOR WILL VERIFY THAT ALL COMPONENTS AND EQUIPMENT HAVE BEEN ANCHORED IN ACCORDANCE WITH THE ABOVE REQUIREMENTS.

2. PIPING, DUCTWORK, AND ELECTRICAL DISTRIBUTION SYSTEMS BRACING NOTE.

PIPES, DUCTWORK, AND ELECTRICAL DISTRIBUTION SYSTEM SHALL BE BRACED TO COMPLY WITH THE FORCES AND DISPLACEMENT PRESCRIBED IN ASCE 7-16 SECTION 13.3 AS DEFINED INS ASCE 7-16 SECTION 13.6.5.6, 13.6.7, 13.6.8, AND 2019 CBC, SECTIONS 1616A.1.24, 1616A.1.25 AND 1616A.1.26.

THE METHOD OF SHOWING BRACING AND ATTACHMENTS TO THE STRUCTURE FOR THE IDENTIFIED DISTRIBUTION SYSTEM ARE AS NOTED BELOW. WHEN BRACING AND ATTACHMENTS ARE BASED ON A PREAPPROVED INSTALLATION GUIDE (E.G. OSHPD OPM FOR 2013 OR LATER), COPIES OF THE BRACING SYSTEM INSTALLATION GUIDE OR MANUAL SHALL BE AVAILABLE ON THE JOBSITE PRIOR TO THE STAR OF AND DURING THE HANGING AND BRACING OF THE DISTRIBUTION SYSTEMS. THE STRUCTURAL ENGINEER OF RECORD SHALL VERIFY THE ADEQUACY OF THE STRUCTURE TO SUPPORT THE HANGER AND BRACE LOADS.

MECHANICAL PIPING (MP), MECHANICAL DUCTS (MD), PLUMBING PIPING (PP):  
DETAILED ON THE APPROVED DRAWINGS WITH PROJECT SPECIFIC NOTES AND DETAILS.  
SHALL COMPLY WITH THE APPLICABLE HCAI PRE-APPROVAL (OPM#) #0052-13.

APPLICABLE CODES AND STANDARDS:

2019 CALIFORNIA BUILDING STANDARDS ADMINISTRATIVE CODE  
CALIFORNIA CODE OF REGULATIONS (CCR) TITLE 24, PART 1

2019 CALIFORNIA BUILDING CODE (CBC)  
CALIFORNIA CODE OF REGULATIONS (CALIFORNIA CODE OF REGULATIONS (CCR) TITLE 24, PART 2)  
TITLE 24, PART 2  
(2018 INTERNATIONAL BUILDING CODE (IBC) W/ 2019 CALIFORNIA AMENDMENTS)

2019 CALIFORNIA ELECTRICAL CODE (CEC)  
CALIFORNIA CODE OF REGULATIONS (CCR) TITLE 24, PART 3  
(2017 NATIONAL ELECTRICAL CODE (NEC) W/ 2019 CALIFORNIA AMENDMENTS)

2019 CALIFORNIA ENERGY CODE  
CALIFORNIA CODE OF REGULATIONS (CCR) TITLE 24, PART 6

2019 CALIFORNIA FIRE CODE (FC)  
CALIFORNIA CODES OF REGULATIONS (CRR) TITLE 24, PART 9  
(2018 INTERNATIONAL FIRE CODE (IFC) W/ 2019 CALIFORNIA AMENDMENTS)

2019 CALIFORNIA EXISTING BUILDING CODE  
CALIFORNIA CODE OF REGULATIONS (CCR) TITLE 24, PART 10  
(2018 INTERNATIONAL EXISTING BUILDING CODE (IEBC))

2019 CALIFORNIA REFERENCES STANDARDS CODE  
CALIFORNIA DOE OF REGULATIONS (CCR) TITLE 24, PART 12

AMERICANS WITH DISABILITIES ACT (ADA)  
TITLE II - ACCESSIBILITY GUIDELINES FOR BUILDINGS AND FACILITIES (ADAG)  
1990 STATE FIRE MARSHAL REGULATIONS AND AMENDMENTS TO-DATE

CALIFORNIA CODE OF REGULATIONS (CCR) TITLE 24, CALIFORNIA STATE ACCESSIBILITY STANDARDS  
CALIFORNIA CODE OF REGULATIONS (CCR) TITLE 19  
2019 CALIFORNIA GREEN BUILDING STANDARDS CODE  
(CAL GREEN), PART II, TITLE 24 C.C.R.

MECHANICAL SHEET INDEX	
M0.1	MECHANICAL COVERSHEET
M0.2	SCHEDULES
M0.3	SPECIFICATIONS
M0.4	SPECIFICATIONS
M0.5	SPECIFICATIONS
M0.6	SPECIFICATIONS
M3.1	DETAILS
M3.2	DETAILS
M3.3	DETAILS
M1.1	GROUND LEVEL DEMOLITION PLAN - MECHANICAL
M2.1	GROUND LEVEL REMODEL PLAN - MECHANICAL
GRAND TOTAL: 11	

IMEG

901 VIA PIEMONTE, SUITE 400  
ONTARIO, CA 91764  
909.477.8915 FAX: 909.477.8916  
www.imegcorp.com  
PROJECT # 21007609.00

IMEG CORP RESERVES PROPRIETARY RIGHTS, INCLUDING COPYRIGHTS, TO THIS DRAWING AND THE DATA SHOWN THEREON. SAID DRAWING AND/OR DATA ARE THE EXCLUSIVE PROPERTY OF IMEG CORP AND SHALL NOT BE USED OR REPRODUCED FOR ANY OTHER PROJECT WITHOUT THE EXPRESS WRITTEN APPROVAL AND PARTICIPATION OF IMEG CORP.

© 2021 IMEG CORP.

REFERENCE SCALE IN INCHES  
0 1 2 3

REGISTERED PROFESSIONAL ENGINEER  
TIMOTHY P. SPANIER  
No. M25602  
Exp. 9/30/24  
MECHANICAL  
STATE OF CALIFORNIA

PROJECT TITLE

STERILIZATION SYSTEM  
INSTALLATION  
FOR THE  
ARROWHEAD REGIONAL  
MEDICAL CENTER  
400 N. PEPPER AVE.  
COLTON, CA. 92324  
WBSE #10.10.1142 - CIP #21-154 - CAFM #COL003

Office of Statewide Health Planning and Development

HCAI # S222347-36-00

REVIEWED IN ACCORDANCE WITH  
THE REQUIREMENTS OF T24, CCR

APPROVED

Department of Health Care Access & Information  
Office of Statewide Hospital Planning & Development  
1/4/2024, 9:00:12 AM  
S222347-36-00  
Allen Cheng

REFERENCE PLAN

PHASE 1: SPD REMODEL  
PROJECT AREA

NURSING TOWER

TRANSFORMER'S  
AND TREATMENT

TOBACCO  
DOCK

GROUND FLOOR

TEMPORARY MOBILE SPD  
(PROJ NO. S222348-36-00)

©marks architects, inc. 2022  
ALL REPORTS, PLANS AND DOCUMENTS PREPARED BY MARKS ARCHITECTS, INC. SHALL REMAIN THE PROPERTY OF MARKS ARCHITECTS, INC. AND ARE INTENDED FOR THE SPECIFIC PROJECT ONLY. OTHER USES ARE PROHIBITED UNLESS OTHERWISE CONTRACTED.

DRAWING TITLE  
MECHANICAL  
COVERSHEET

marks  
architects

73121 fred waring drive  
suite 200  
palm desert, ca 92260  
760-327-6800

DRAWING DATE  
DECEMBER 28, 2022

REVISIONS

HCAI COMMENTS 02.13.23

PLAN CHECK COMMENTS 08.15.23


LICENSED ARCHITECT  
DAVID WILLIAM D. ARKES  
C-21219  
FEB 20 2025

PROJECT NUMBER  
3021027

DRAWING NUMBER  
M0.1



HCAI # S222347-36-00

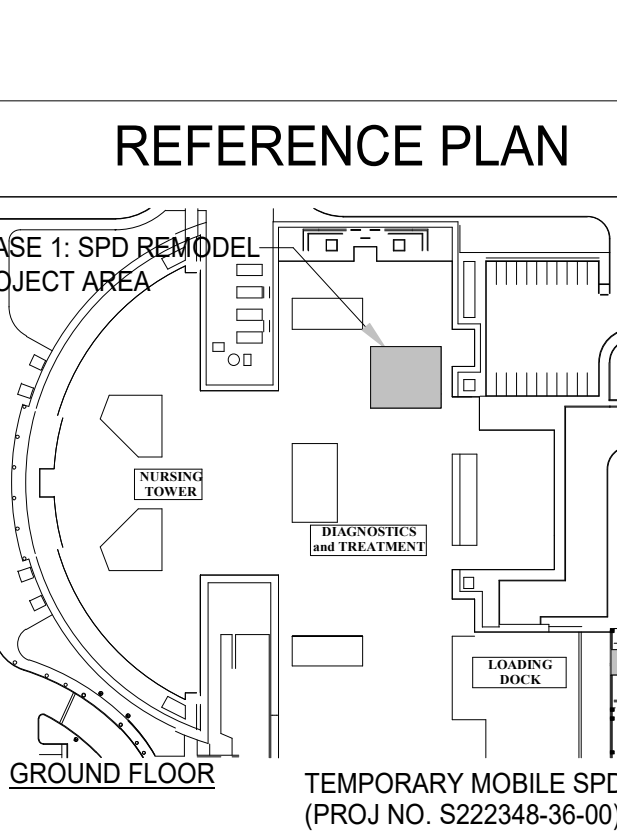

An architectural drawing of a building facade. The drawing is a line drawing showing a large, stylized 'M' logo. The logo is composed of two main vertical bars and a central triangular void. The text 'marks architects' is written in a lowercase, sans-serif font below the logo. The drawing is set against a light gray background.

DATE	<b>DECEMBER 28, 2022</b>	
	<b>REVISIONS</b>	
△	HCAI COMMENTS 02.13.23	
△	PLAN CHECK COMMENTS 08.15.23	
△		
△		
	<b>LICENSED ARCHITECT</b> DAVID WILLIAM OLAFRE C-215219 EXPIRES 03-25-2025 <i>(Signature)</i>
PROJECT NUMBER <b>3021027</b>	
DRAWING NUMBER <b>M0.2</b>	

- ## AIR TERMINAL SCHEDULE

TAG NAME	FACE SIZE (IN.) (NOTE 2)	TYPE	BORDER (NOTE 1)	MATERIAL	FINISH	VOLUME DAMPER REQUIRED	MANUFACTURER	MODEL	NOTES
EG/RG	VARIES	PERFORATED FACE	LAY-IN	ALUMINUM	WHITE	NO	TITUS	271-FL	
SD	24x24	LOUVER FACE	LAY-IN	ALUMINUM	WHITE	NO	TITUS	TDC-AA	

1. AIR QUANTITIES SHOWN IN THE TABLE BELOW IS FOR THE ENTIRE SPD AREA. THIS INCLUDES DECONTAMINATION ROOM GB183, WHICH IS OUR PROJECT AREA.

HVAC AIR BALANCE SUMMARY - ARMC AC STERILE DEPARTMENT																	
Rm NO.	ROOM NAME	SPACE FUNCTION (PER TABLE 4A)	AREA (Sq Ft)	HEIGHT (Ft)	VOLUME (Cubic Ft)	REQUIRED QSA				NOTED QSA				EXH. AIR (CFM)	(MAX) RET. AIR (CFM)	ROOM PRESSURIZATION	UNIT SERVED
						MIN. REQ'D	DESIGN	MIN. REQ'D	DESIGN*	MIN. REQ'D <sup>1</sup>	DESIGN	MIN. REQ'D	DESIGN*				
GB111	CORRIDOR	PATIENT CORRIDOR	579	9.0	5215	0	5.6	0	484	2	10.4	174	900	0	900	NR	
GB124	SERVICE ROOM	STERILIZER EQUIPMENT ROOM	181	9.0	1627	0	23.8	0	846	10	44.3	271	1200	1320	0	N	
GB177	SOILED EQUIPMENT	SOILED WORK ROOM/UTILITY ROOM	280	9.0	2520	2	6.7	84	280	10	12.4	420	520	570	0	N	
GB178	J.C.	JANITOR CLOSET	29	9.0	265		8.5	0	38	10	15.9	44	70	90	0	N	
GB179	EQUIPMENT ASSEMBLY	SUBSTERILE SERVICE AREA	105	9.0	949	2	4.8	32	75	6	8.9	95	140	0	90	NR	
GB180	CLEAN EQUIPMENT	CLEAN WORK ROOM	507	10.0	5065	2	4.0	169	334	4	7.3	338	820	0	560	P	
GB181	J.C.	JANITOR CLOSET	30	9.0	273		7.1	0	32	10	13.2	46	60	60	0	N	
GB182	CART WASHER	STERILIZER EQUIPMENT ROOM	120	11.0	1322	0	0.0	0	0	10	0.0	220	0	1400	0	N	
GB183	DECONTAM	SOILED OR DECONTAMINATION ROOM	982	10.0	9817	2	6.2	327	1011	6	11.5	982	1890	3840	0	N	
GB184	PREP / PACK	PREPARATION ROOM	957	10.0	9569	2	8.0	319	1272	6	14.8	957	2365	455	800	P	
GB185	CART HOLD	CLEAN WORKROOM OR CLEAN HOLDING	253	10.0	2530	2	4.9	84	207	4	9.1	169	385	0	0	P	
GB186	PROCESSED STORES	STERILE STORAGE	2984	10.0	29840	2	5.5	395	2755	4	10.0	1389	5120	0	3235	P	
GB187	SVC INTER	STERILIZER EQUIPMENT ROOM	36	9.0	864	0	14.9	0	215	10	27.8	144	400	445	0	NR	
GB188	STERRAD	STERILIZER EQUIPMENT ROOM	114	9.0	1025	0	12.6	0	215	10	23.4	171	400	445	0	N	
GB189	SUPV	ADMINISTRATIVE	67	8.0	539	2	5.4	18	48	6	10.0	54	90	0	90	NR	
GB195	ST. LOCKER	MEDICAL STAFF SUPPORT	102	9.0	922	2	7.0	31	108	6	13.0	32	200	170	0	NR	
GB196	ST. TOIL/SHOWER	TOILET ROOM	85	9.0	768	0	6.7	0	86	10	12.5	128	160	190	0	N	
GB247	CONVENIENCE CENTER	MEDICAL STAFF SUPPORT	489	9.0	4398	2	4.0	147	291	6	7.4	440	540	0	540	NR	
GB248	WAITING	WAITING AREA PRIMARY CARE CLINIC	82	9.0	742	2	3.9	25	48	10	7.3	124	90	0	90	NR	
GB249	ST LOCKER-M	MEDICAL STAFF SUPPORT	49	9.0	439	2	6.6	15	48	6	12.3	44	90	65	0	NR	
GB250	ST LOUNGE	MEDICAL STAFF SUPPORT	207	9.0	1864	2	6.9	62	215	6	12.9	186	400	0	400	NR	
GB251	ST TOIL-M	TOILET ROOM	58	9.0	522	0	5.3	0	51	10	10.9	87	95	120	0	N	
GB252	LINEN PACK	CLEAN LINEN STORAGE	370	9.0	3327	0	5.0	0	280	2	8.3	111	460	0	460	NR	
GB253	ST LOCKER-F	MEDICAL STAFF SUPPORT	129	9.0	1162	2	7.5	39	145	6	13.9	116	270	240	0	NR	
GB254	ST TOIL-F	TOILET ROOM	67	9.0	603	0	7.5	0	75	10	13.9	100	140	170	0	N	
GB255	E. C.	MEDICAL STAFF SUPPORT	91	11.0	1005	2	9.5	33	59	6	6.6	100	110	0	110	NR	
GB914	CORRIDOR	PATIENT CORRIDOR	545	9.0	4903		5.4	0	441	2	10.0	163	820	0	820	NR	
			9560						9461			TOTAL = 17525	9600	8095			



 901 VIA PIEMONTE, SUITE 400  
 ONTARIO, CA 91764  
 909.477.6915 FAX: 909.477.6916  
[www.imegcorp.com](http://www.imegcorp.com)  
 PROJECT # 21007609.00

IMEG CORP RESERVES PROPRIETARY RIGHTS, INCLUDING COPYRIGHTS, TO THIS  
 DRAWING AND THE DATA SHOWN THEREON. SAID DRAWING AND/OR DATA ARE  
 THE EXCLUSIVE PROPERTY OF IMEG CORP AND SHALL NOT BE USED OR  
 REPRODUCED FOR ANY OTHER PROJECT WITHOUT THE EXPRESS WRITTEN  
 APPROVAL AND PARTICIPATION OF IMEG CORP. © 2011 IMEG CORP

REFERENCE SCALE IN INCHES  
 0 2 3





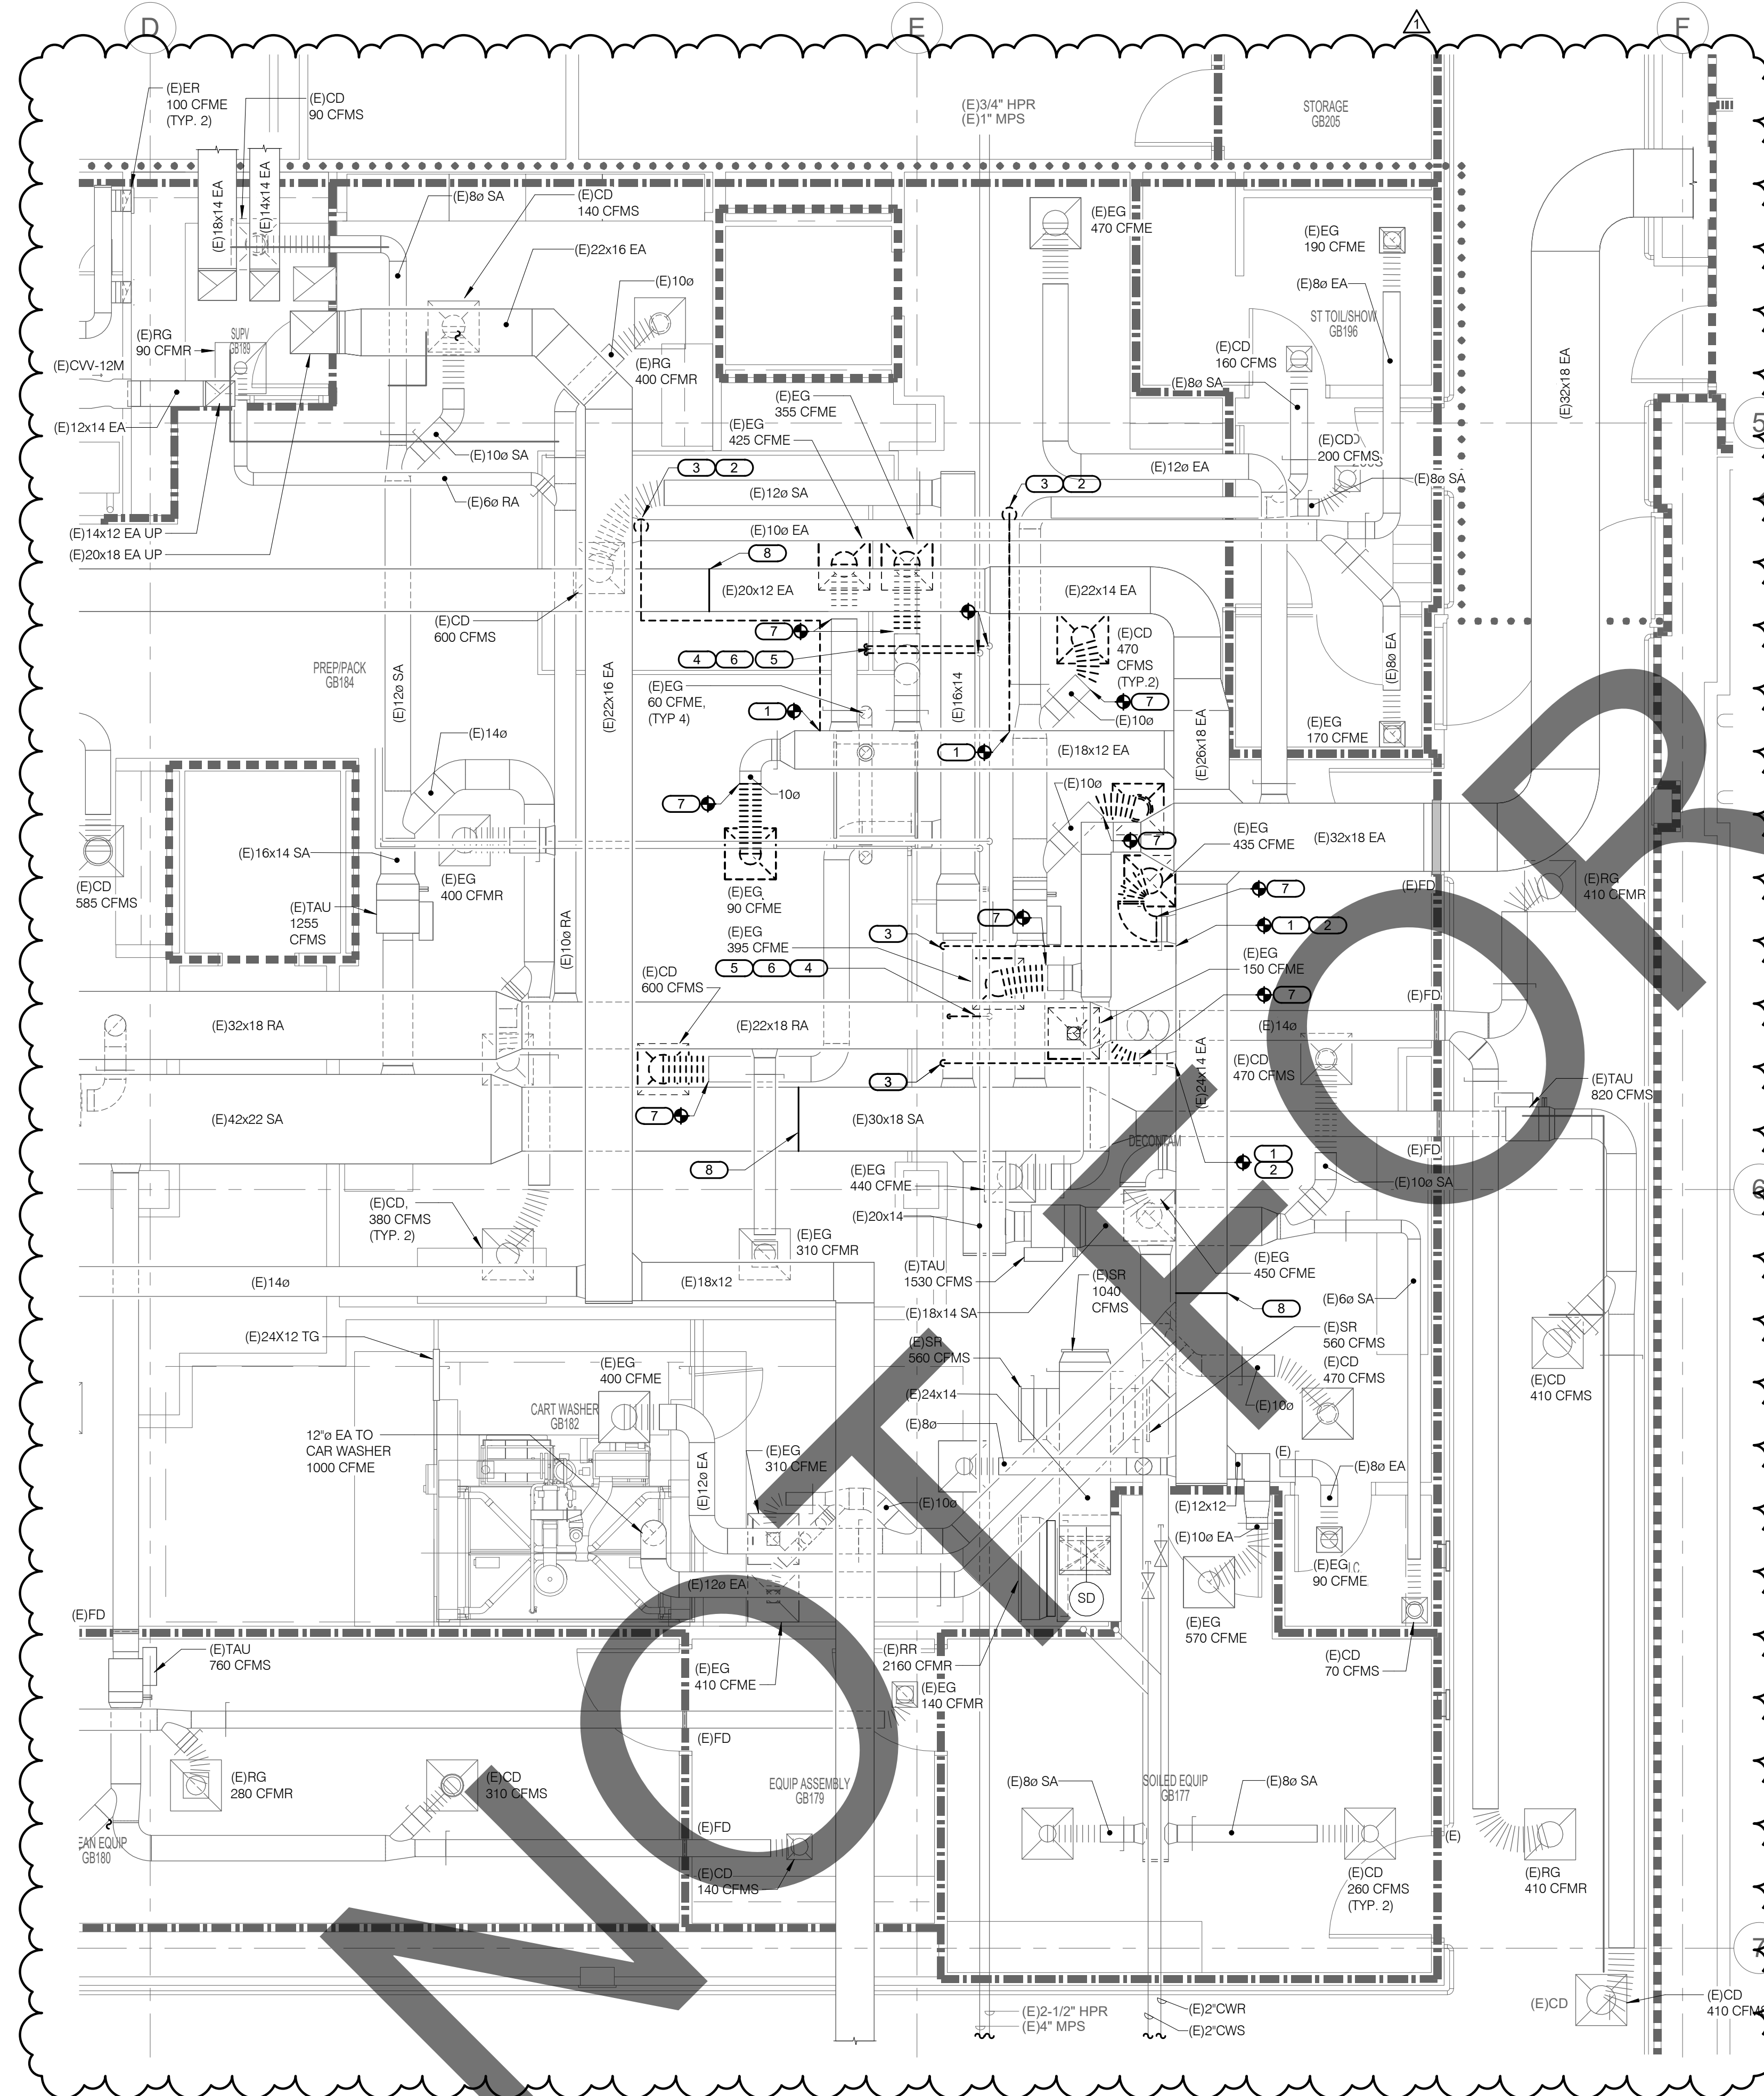

1 GROUND LEVEL DEMOLITION PLAN - MECHANICAL  
NO SCALE

## GENERAL SHEET NOTES

- SUPPLY AIR, RETURN AIR AND EXHAUST AIR CFM SHOWN ON THIS DRAWING ARE PRE-BALANCE VALUES INDICATED ON AIR MANAGEMENT INDUSTRIES(AMI) HVAC SYSTEM SURVEY DATED DECEMBER 14, 2021.
- CLOSE EXISTING BRANCH VOLUME DAMPER AND CAP DURING CONSTRUCTION. TYPICAL EACH AIR DEVICE TO BE REMOVED.

## KEY NOTES #

- EXISTING EXHAUST DUCTWORK POINT OF DISCONNECTION. PROVIDE DUCTWORK END CAP AS INDICATED ON DRAWING.
- DEMOLISH EXISTING EXHAUST DUCTWORK INCLUDING FITTINGS AND SUPPORTS.
- DISCONNECT EXISTING EXHAUST DUCTWORK FROM EXISTING EQUIPMENT.
- EXISTING STEAM AND CONDENSATE RETURN PIPING POINT OF DISCONNECTION. PROVIDE ISOLATION VALVE/END CAP OR USE SOME OTHER METHOD TO ALLOW PIPING DISCONNECTIONS WITHOUT ANY INTERRUPTION OF STEAM SERVICE.
- DEMOLISH EXISTING STEAM AND CONDENSATE RETURN PIPING INCLUDING FITTINGS, INSULATION AND SUPPORTS.
- DISCONNECT EXISTING STEAM AND CONDENSATE RETURN PIPING FROM EXISTING EQUIPMENT.
- REMOVE EXISTING AIR DEVICE
- PROVIDE PRECONSTRUCTION DUCT TRAVERSE READING AT THIS LOCATION


PROJECT TITLE  
**STERILIZATION SYSTEM  
INSTALLATION  
FOR THE  
ARROWHEAD REGIONAL  
MEDICAL CENTER**  
400 N. PEPPER AVE.  
COLTON, CA. 92324  
WBSE #: 10.10.1142  
CIP #: 21-154  
CAFM #: COL003

Office of Statewide Health Planning and Development

HCAI # S222347-36-00



## REFERENCE PLAN

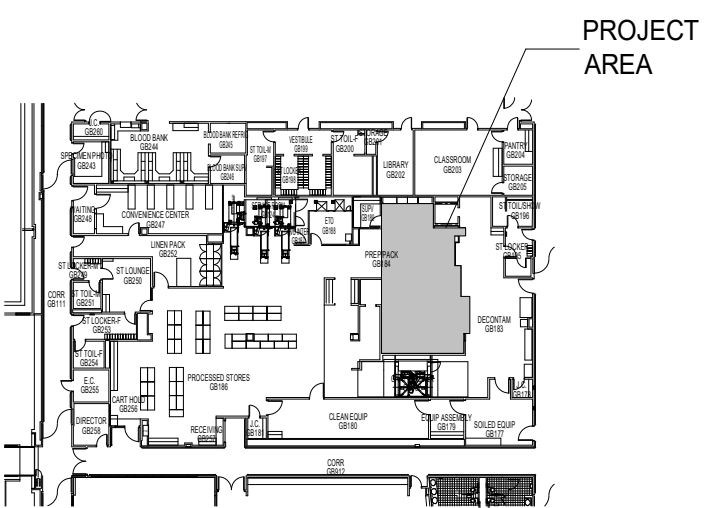

GRD FLOOR


© urrutia marks architects 2022 ALL REPORTS, PLANS AND DOCUMENTS PREPARED BY URRUTIA MARKS ARCHITECTS SHALL REMAIN THE PROPERTY OF URRUTIA MARKS ARCHITECTS AND ARE INTENDED FOR THIS SPECIFIC PROJECT ONLY.

## GROUND LEVEL DEMOLITION PLAN - MECHANICAL

DATE  
**12/28/2022**  
REVISIONS  
HCAI COMMENTS 2/13/2023



73121 fred waring drive  
suite 200  
palm desert, ca 92260  
760-327-6800

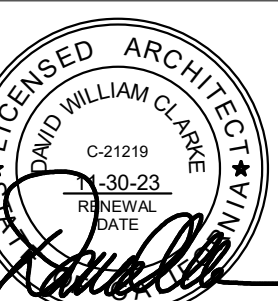

PROJECT NUMBER  
**3021022**

DRAWING NUMBER

**M1.1**

