

ADDENDUM NO. 02

TO THE CONSTRUCTION DOCUMENTS BID PACKAGE

Client: Arrowhead Regional Medical Center

Project: Oncology-Ambulatory Clinic

SHA Project No.: 18242.100

Date: September 12, 2019

To All Plan Holders:

The following changes, additions, and/or deletions are hereby made a part of the Construction Documents for the above noted project, fully and completely as if the same were fully contained therein. All other terms, conditions, and specifications of the original Invitation to Bid remain unchanged. This amendment must be acknowledged in the space provided on the Bid Schedule.

The Submittal Date and Time is NOT changed. It remains: September 26, 2019 @ 1:00 PM

The modifications directed by this Addendum No.02 are described in this page and the following attachments:

- 1. Additional Instructions to Bidders (as indicated below)
- 2. Pre-Bid RFI Responses
- 3. Revised Drawings (as indicated below)
- 4. Revised Specification Sections (as indicated below)

CHANGES TO BID Documents

As follows:

Drawings:

G001 Sheet names in List of Drawings revised to match sheets.

A111 Existing room names added to the corridor that is to the north of the project area, scope revised to indicate partial demolition of the ceiling in this corridor.

General Note added to sheet regarding accommodations for equipment or material deliveries and trash removal from the project area.

- A121 Removed "NOT IN CONTRACT" from room identification tags in rooms that require partial ceiling demolition.
- A122 Keynote FP06 revised to indicate new gypsum board at existing framing.

General Note regarding Owner Furnished Items added to General Notes.

- A123 Keynote FP06 revised to indicate new gypsum board at existing framing.
- A131 General Note added to sheet regarding patching back of existing ceilings in corridor.

General Note regarding Owner Furnished Items added to General Notes.

A201 Clinical Assistant 018 Interior Elevation E added to sheet at N2/-.

Cabinet locks added to various elevations and Keynote EL30 added to Keynotes.

General Note prohibiting cabinet locks at accessible sink aprons added to General Notes.

Detail callout revised to reference correct detail.

A202 Physician's Office 037A, B, C Interior Elevations A & B added to sheet at N2/-.

Cabinet locks added to various elevations and Keynote EL30 added to Keynotes.

General Note prohibiting cabinet locks at accessible sink aprons added to General Notes.

Elevation E6 revised to show padlock hasp at plastic laminate lockers.

Elevation J1 revised to match floor plan.

Various detail callouts revised to reference correct detail.

Elevation E2/- added to sheet.

A203 Cabinet locks added to various elevations and Keynote EL30 added to Keynotes.

General Notes prohibiting cabinet locks at accessible sink aprons added to General Notes.

Various detail callouts revised to reference correct detail.

A204 Cabinet locks added to elevation A12/- and Keynote EL30 added to Keynotes.

General Note prohibiting cabinet locks at accessible sink aprons added to General Notes.

- A605 Revised detail number.
- M111 Revised demolition scope in the existing public restrooms.
- M122 Revised ductwork.
- M125 Added note to sheet regarding patching exterior finishes.

Added General Note #4 referencing framing details.

ID300 Added Note to plan regarding Window Treatments.

ID600 Typical Toilet Room Interior Elevations revised to match Architectural drawings.

Detail 11/- omitted from drawings.

Reception and Nurse Station Elevations and Details revised to match Architectural.

ID700 Revised Finish Schedule.

Specifications:

TOC Various typos corrected in Table of Contents

O16500 Specification section revised to remove language referencing "Equipment Drawings, Schedules or Specifications"

O64100 Specification sub-section 2.3 G 6 & 7 revised to omit Keyboard Trays and Articulating Keyboard Supports.

090000 Specification sub-section 1.2 B revised to indicate sink per plumbing drawings.

Specification sub-section 1.11 B revised to include Window Treatment specifications.

Specification sub-section 1.11 D revised to omit Metal Lockers.

Additional Instructions to Bidders:


- 1. The contractor will not be allowed to use the MOB elevators for equipment or material deliveries to, or for trash removal from, the project. For these items, the contractor will be allowed to remove and replace one, or two, exterior windows. The location(s) will be coordinated and approved by the Construction Manager and ARMC Facilities. Contractor shall use all due care and caution in doing the work. When the window is re-installed there shall be no difference in construction detail or appearance from the original condition. During construction, the openings shall be weather protected to prevent moisture intrusion.
- 2. The contractor is to assume that the laydown area for equipment deliveries and storage will be located in close proximity to the ARMC hospital loading dock. The actual location will be coordinated with the Construction Manager and ARMC Facilities. Because of space constraints, the laydown area will be restricted. Exact size/area will be determined by the Construction Manager and ARMC Facilities at the time of construction.
- 3. Project workers will be allowed to access the work area through the stair at the northwest corner of the 1st Floor Lobby. Access will be coordinated with ARMC Facilities and Security.
- 4. Workers will be allowed to park in Lot 14, at the north end of the ARMC site.
- 5. All workers will be required to provide proof that they have received flu shots within 12 weeks.
- 6. All workers will be required to check in each day at the Materials Management office for badging. Badges are to be turned back in at the end of the day.
- 7. Any and all clouds shown on the plumbing drawings and clouds without Delta Symbol A on the mechanical drawings are not related to this Addendum and should be disregarded.


END OF ADDENDUM NO. 02



nursday	September 12, 2019	Healthcare Architects
No.	Question	Response
	On sheet E123 in the Exam Rooms there are two nurse call devices shown, a staff station	The Nurse Call system is a Defered Approval Item per sheet G001 (see attached) and
001.1	and a duty station. In an acute care hospital, these types of stations are not required in an exam room (2016 CBC - Table 1224.4.6.5). There is no requirement for a duty station and staff station in a clinic exam room. However, there may be a need for a staff assist button, which is typically used in clinic exam and procedure rooms.	the electrical drawings are for "Information Only" for the purpose of providing accurate
002.1	Will use of Reptrack system be required for this project ?	No.
002.2	Does the facility have a preferred fire alarm vendor?	Johnson Controls is the service contractor on the site, but not required.
002.3	Will the facility provide secured storage for equipment and materials during the project?	No, each contractor will be responsible for their own secure storage. The location of that storage will be coordinated with ARMC and Kitchell.
002.4	Sheet G001 shows clouding of sheets M601, M602, M603, M604 however no changes are shown on these sheets? Please advise. Sheet A111 DM15 shows removal of ceiling in restrooms 207 & 208. Sheet M122 shows	The names of the clouded sheets were revised as they appear in the list only. No revisions were made the actual sheets. Keynote DM15 indicates to DEMOLISH EXISTING CEILING AS REQUIRED BY NEW
002.5	these areas as "not in contract". Please confirm these areas are in the scope of work.	MECHANICAL WORK ONLY. Coordinate with scope shown on Mechanical drawings. M122 should NOT indicate "NOT IN SCOPE". See revised Mechanical sheets attached.
002.6	Sheet M112 shows new CFSD's crossing corridor 202 into another space not shown on the plans. Please provide additional information about this area. Additionally M122 shows this area as "not in contract" Please confirm this area is in the scope of work.	
003.1	Section 064100/2.3.6.13.a, indicates cabinet locks as indicated on drawings. Interior elevations and casework details do not show locks. Please clarify the locations of any casework locks.	Cabinet locks are to be provided per the attached revised interior elevations.
003.2	Section 064100/2.3.G.6 & 7, indicate keyboard trays and articulating keyboard supports. Interior elevations and casework details do not show keyboard trays or supports. Please	Keyboard trays and supports are not part of this contract, and have been removed from Specification Section 064100. See revised Specification Section attached.
	clarify locations of keyboard trays and supports. Interior elevations A3, E7 & J7/A204 show wall hung sinks at Patient and Staff Toilet Rooms. Elevations 2 & 3/ID600 & Finish Schedule on ID700 show solid surface countertop	The sinks shown on the Architectural interior elevations and referenced in this RFI are to
003.3	with undermount sink at these locations. Please clarify if these sinks are wall or countermounted.	wall hung per the architectural drawings. The Interior Design drawings have been revised, see attached revised ID drawings.
003.4	Section 09 00 00/1.2.B indicates solid surface integral sinks, but Plumbing Schedule on P001 indicates sinks are stainless steel. Please clarify.	1 Specification Section 090000 is incorrect. The sinks referenced in this RFI shall be Stainles Steel per Plumbing drawings. See revised Specification Section and Interior Design drawin attached.
004.1	Elevation E6/A202 shows plastic laminate lockers per Keynote EL02 and Section 105060, but section 090000 Finish Material Legend identifies the lockers as LKR-1 Metal Lockers. Please clarify.	The lockers are to be Plastic Laminate, Metal Lockers have been removed from Specification Section 090000. Please use Specification Section 105060 per architectural drawings. See revised Specification Sections.
005.1	Please advise who is responsible for Window Treatment. Specification section 09 00 00 calls for Window Treatment SHD-1 to match building standards, but there are no call outs on the drawings.	Window Treatments are to be contractor furnished/contractor installed. See revised Interior Design drawings and Specification Sections attached.
006.1	I wanted to ask a question regarding the Oncology Infusion Clinic Project for Arrowhead Regional Medical Center (Project #10.10.0265). The bid documents ask for a Class "B" General Building Contractor License. Would a Class "C-7" Low Voltage Systems Contractor	The County is only accepting pricing for the complete scope of work, which will require a Class B license.
	License be acceptable? Keynote DM04 on sheet A111 Demolition Plan calls to "Demolish Existing Gypsum Board"	Existing gypsum board along all perimeter walls is to be demolished. FP06 on sheets A122
007.1	On One Side Only, Protect Framing In Place" along the West, South & East perimeter walls, but keynote FP06 on sheet A122 Floor Plan - Area A calls for "Existing Gypsum Board Furring to Remain, Protect in Place. Please advise if existing gypsum board along the perimeter wall is to remain, or to be demolished and replaced with new framing and	
008.1	drywall. Please advise if the existing roof warranty program is still in effect and who is the vendor	There is no impact or Work to existing roofing.
000 1	for the existing roof. Specifications section 01 65 00 Owner Furnished Products refer to Equipment Drawings &	Specification section 016500 should not reference "Equipment Drawings, Schedules or
009.1	an Equipment Schedule, please provide.	specifications". All equipment is identified on sheets A122 and A123 and is Owner Furnished/Contractor Installed. Specifications revised accordingly.
,		

ARROWHEAD REGIONAL MEDICAL CENTER M.O.B. ONCOLOGY-AMBULATORY CLINIC

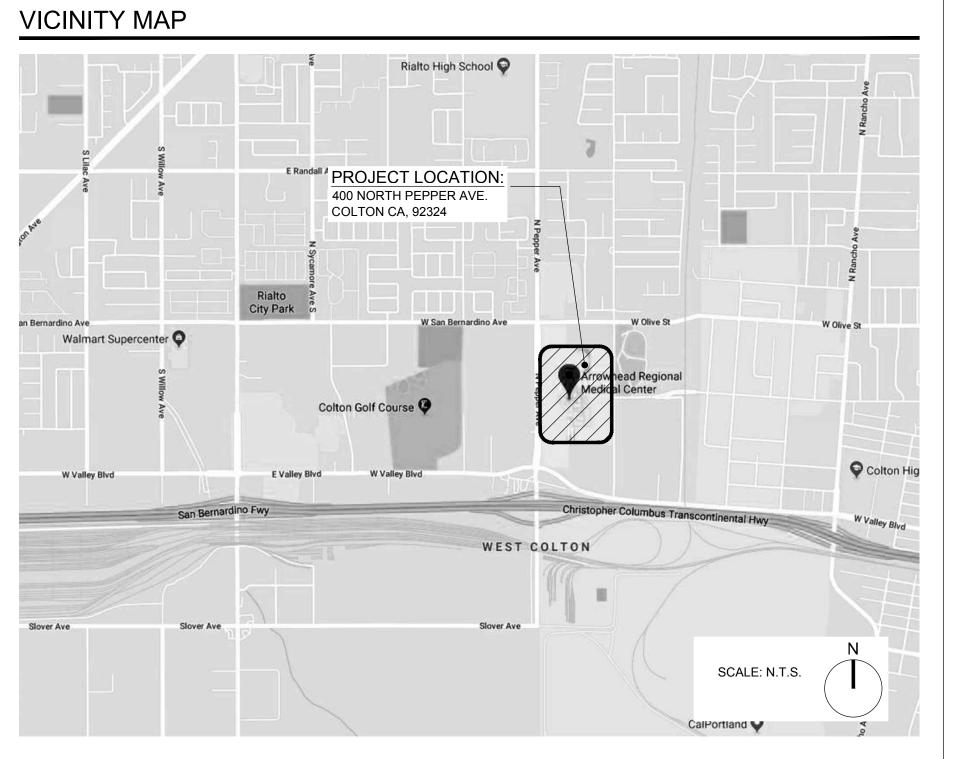

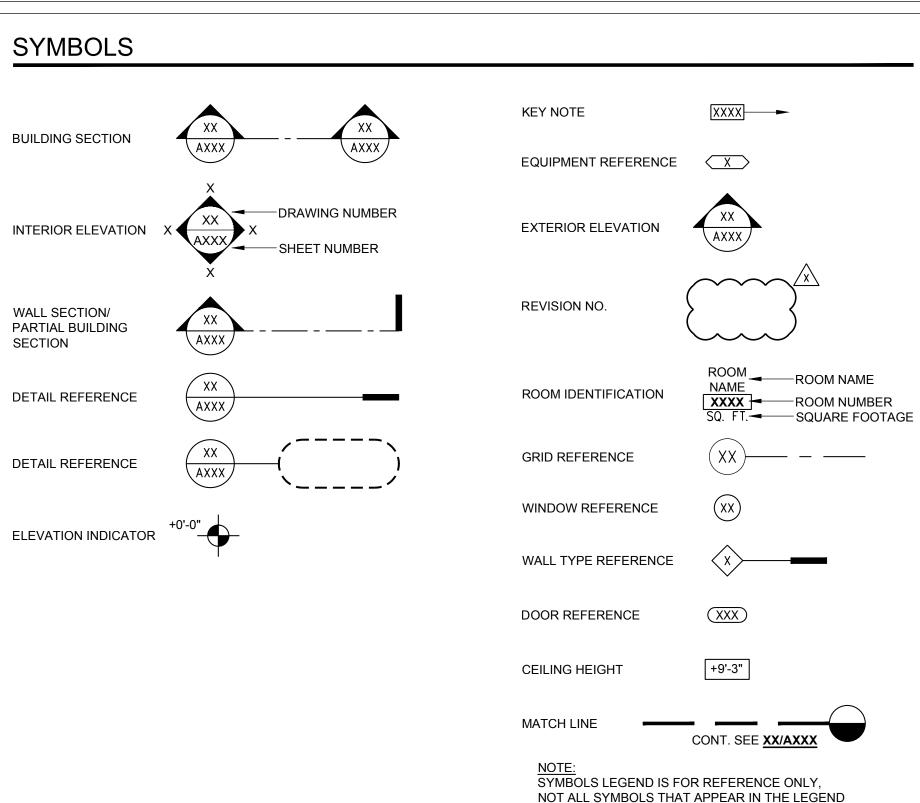

					N THE PROJECT
ABBI	REVIATIONS				
A.B. A.C. ADJ. A.F.F. A.F.S. A.H.J. ALT. APPROX. BLDG. BLKG. BSMT. CAB. C.B.C. C.C.T.V. C.G. CLR. CLR. CLNG. C.J. COL.	ANCHOR BOLT ASPHALT CONCRETE ADJUSTABLE ABOVE FINISH FLOOR ABOVE FINISH GRADE ABOVE FINISH SLAB AUTHORITY HAVING JURISDICTION ALTERNATE APPROXIMATELY BOARD BUILDING BLOCKING BEAM BASEMENT CALIFORNIA BUILDING CODE CLOSED CIRCUIT TELEVISION CORNER GUARD CENTER LINE CLEAR CEILING CONTROL JOINT COLUMN	H.C. H.M. HORIZ. HR. INFO. INSUL. JAN. LAV. LB. LT . WT. MAX. MECH. MIN. (N) N	FOOT, FEET FURNITURE FIXTURE GAUGE GALVANIZED GENERAL CONTRACTOR OGYPSUM BOARD HOLLOW CORE HOLLOW METAL HORIZONTAL HOUR INFORMATION INSULATION JANITOR LAVATORY POUND(S) LIGHT WEIGHT MAXIMUM MECHANICAL MINIMUM NEW NORTH NOT APPLICABLE	S.J. SHR. SHT. SIM. S.M.S. SQ. S.S. ST. STOR. T&B T&G T.C. TEL. TEMP. THK. TOT. T.O.P.	REVISION ROOM ROUGH OPENING SOLID CORE SCHEDULE SEISMIC JOINT SHOWER SHEET SIMILAR SHEET METAL SCREW SQUARE STAINLESS STEEL STREET STORAGE TOP AND BOTTOM TONGUE AND GROVE TOP OF CONCRETE TELEPHONE TEMPORARY THKICK TOTAL TOP OF PARAPET
CONC. CONT. CSWK. DIA. (Ø) DBL. DEMO D.F. DIAG. DIST. DN. DWG. (E) EA. EL. ELEC. F.A. F.D. F.E.C. F.F. FIN. FLR. F.O.C. F.O.S.	CONCRETE CONTINUOUS CASEWORK DIAMETER DOUBLE DEMOLITION DRINKING FOUNTAIN DIAGINAL DISTANCE DOWN DRAWING EXISTING EACH ELEVATION ELECTRICAL FIRE ALARM FLOOR DRAIN FIRE EXTINGUISHER CABINET FINISH FLOOR FACE OF CONCRETE FACE OF STEEL	N.I.C. NO. N.T.S. O.C. OXY. P.C. P.D.F. P.L. PLAM. PLYWD. PNL. BD. PRKG. P.S.F. P.S.I. P.V.C. PVMT. QTY. RAD. R.C.P. R.D. REF. REFR. REINF. REQD.	NOT IN CONTRACT NUMBER NOT TO SCALE ON CENTER OXYGEN PORTLAND CEMENT POWER DRIVEN FASTENER PROPERTY LINE OR PLATE PLASTIC LAMINATE PLYWOOD PANEL BOARD PARKING POUNDS PER SQUARE FOOT POUNDS PER SQUARE INCH POLYVINYL CHLORIDE PAVEMENT QUANTITY RADIUS REFLECTED CEILING PLAN ROOF DRAIN REFERENCE REFRIGERATOR REINFORCE (D) (ING) (MENT) REQUIRED	T.O.R. U.C. U.N.O. UTIL. VERT. VEST. V.I.F. VOL. W/W/O W.C. WD. WT.	TOP OF PLATE TOP OF ROOF UNDER COUNTER UNLESS NOTED OTHERWISE UTILITY VERTICAL VESTIBULE VERIFY IN FEILD VOLUME WITH WITHOUT WATER CLOSET WOOD WEIGHT MINOLOGY ON THE DOCUMENTS IS ERED INDUSTRY STANDARD. ANY UNKNOWN ITEMS WITH THE ARCH

PRIOR TO ANY ACTION.

GENERAL NOTES

- CONCEPT, THE DIMENSIONS OF THE BUILDING, THE MAJOR ARCHITECTURAL ELEMENTS AND THE TYPE OF STRUCTURAL, MECHANICAL AND ELECTRICAL SYSTEMS. ON THE BASIS OF THE GENERAL SCOPE INDICATED OR DESCRIBED, FURNISH ALL ITEMS REQUIRED FOR THE
- THE CONTRACTOR SHALL KEEP AN UP TO DATE SET OF CONTRACT DOCUMENTS PERMIT SET, INCLUDING AMENDED DOCUMENTS. AT THE JOB SITE IN A LOCATION CONVENIENT FOR
- 3. CONTRACTOR SHALL COORDINATE ALL NECESSARY UTILITY RELOCATIONS WITH THE APPROPRIATE UTILITY COMPANIES.
- ALL CONSTRUCTION AND MATERIALS SHALL COMPLY WITH THE REQUIREMENTS OF THE CALIFORNIA BUILDING CODES (CBC) AND LOCAL GOVERNING CODES AND AUTHORITIES.
- VERIFY ALL DIMENSIONS AND SITE CONDITIONS BEFORE STARTING WORK. SHOULD A DISCREPANCY APPEAR IN THE SPECIFICATIONS OR DRAWINGS, OR IN THE WORK DONE BY OTHERS FROM THE CONTRACT DOCUMENTS THAT AFFECT ANY WORK, NOTIFY THE ARCHITECT AT ONCE FOR INSTRUCTION ON HOW TO PROCEED. IF THE CONTRACTOR
- CONTRACTOR SHALL MAKE GOOD ANY RESULTING DAMAGE OR DEFECT. THE WORK IN ACCORDANCE WITH ALL APPLICABLE LAWS, LOCAL ORDINANCES, PERMITS AND THE CONTRACT DOCUMENTS. MAINTAIN THE JOB SITE IN A CLEAN, ORDERLY CONDITION.FREE OF DEBRIS AND LITTER. THE JOB SITE SHALL NOT BE UNREASONABLY ENCUMBERED WITH ANY MATERIAL OR EQUIPMENT. EACH SUBCONTRACTOR IMMEDIATELY UPON COMPLETION OF EACH PHASE OF HIS WORK SHALL REMOVE ALL TRASH AND DEBRIS AS A RESULT OF HIS

PROCEEDS WITH THE WORK AFFECTED WITHOUT INSTRUCTIONS FROM THE ARCHITECT

- STACK AND PROTECT ALL MATERIAL STORED ON THE SITE TO PREVENT DAMAGE AND DETERIORATION UNTIL USE. FAILURE TO PROTECT MATERIALS MAY BE CAUSE FOR **REJECTION OF WORK**
- PERFORM ALL CUTTING. FITTING OR PATCHING THAT MAY BE REQUIRED TO MAKE SEVERAL PARTS FIT TOGETHER PROPERLY SO AS NOT TO ENDANGER ANY OTHER WORK BY CUTTING EXCAVATING OR OTHERWISE ALTERING THE TOTAL WORK OR ANY PART OF IT. PERFORM ALL PATCHING, REPAIRING AND REPLACING OF MATERIALS AND SURFACES, CUT OR DAMAGED IN EXECUTION OF WORK WITH APPLICABLE MATERIAL SO THAT SURFACES REPLACED WILL, UPON COMPLETION, MATCH SURROUNDING SIMILAR SURFACES.
- DO NOT COMMENCE ANY PORTION OF THE WORK REQUIRING A SHOP DRAWING OR SAMPLE SUBMISSION UNTIL THE SUBMISSION HAS BEEN REVIEWED AND ACCEPTED BY THE ARCHITECT. ALL SUCH PORTIONS OF THE WORK SHALL BE IN ACCORDANCE WITH ACCEPTED SHOP DRAWINGS AND SAMPLES.
- 10. DIMENSIONS:

PROJECT LOCATION

EXISTING PARKING LOT

OPERATION.

- a) FOR ALL PROPOSED CONSTRUCTION, USE NOTED DIMENSIONS ONLY. DO NOT SCALE
- b) ALL DIMENSIONS ARE TO FACE OF STUD (F.O.S.) UNLESS NOTED OTHERWISE. c) CEILING HEIGHT DIMENSIONS ARE FROM FLOOR SLAB TO FINISH FACE OF CEILING. 11. PROVIDE ALL NECESSARY BLOCKING, BACKING, AND FRAMING FOR EQUIPMENT AND ALL
- OTHER ITEMS REQUIRING THE SAME. 12. COMPLY WITH FIRE RESISTIVE REQUIREMENTS THROUGHOUT THE ENTIRE BUILDING PER CBC. 13. MAINTAIN FIRE RATED CONSTRUCTION AT ALL CABINETS, ACCESSORIES, PANELS AND
- SIMILAR FABRICATIONS OR ASSEMBLIES RECESSED RATED PARTITIONS. 14. INITIATE, MAINTAIN AND SUPERVISE A REASONABLE AND PRUDENT SAFETY PROGRAM INCLUDING, BUT NOT LIMITED TO, THE ISOLATION OF WORK AREAS AND THE PROMPT REMOVAL OF ANY DEBRIS OR TOOLS WHICH MIGHT ENDANGER VISITORS, PATIENTS OR EMPLOYEES OF THE HOSPITAL. ALL ROADS AND WALKWAYS SHALL REMAIN CLEAR AND UNOBSTRUCTED.
- 15. VERIFY CLEARANCES, MOUNTING HEIGHTS AND LOCATIONS OF FIXTURES, EQUIPMENT, DEVICES AND ACCESSORIES WITH LATEST EDITION OF GOVERNING CODE. NOTIFY THE ARCHITECT IN CASE OF DISCREPANCY.
- WHEN INSTALLING DRILLED IN ANCHORS AND/OR POWDER DRIVEN PINS IN EXISTING NON-PRESTRESSED REINFORCED CONCRETE, USE CARE AND CAUTION TO AVOID CUTTING OR DAMAGING THE EXISTING REINFORCING BARS. WHEN INSTALLING THEM INTO EXISTING PRE-STRESSED CONCRETE (PRE OR POST-TENSIONED) LOCATE THE PRESTRESSED TENDONS BY USING A NON-DESTRUCTIVE METHOD PRIOR TO INSTALLATION. EXERCISE EXTREME CARE AND CAUTION TO AVOID CUTTING OR DAMAGING THE TENDONS DURING INSTALLATION. MAINTAIN A MINIMUM CLEARANCE OF ONE INCH BETWEEN THE REINFORCEMENT AND THE DRILLED IN ANCHOR AND/OR PIN. REFERENCE: 2016 CBC SECTION 1603A.1.10.

17. PROVIDE ACCESS PANELS TO ALL TO ALL CONCEALED SPACES (I.E. ATTICS, VOID SPACES. ETC.) AS REQUIRED BY THE CURRENT CBC AND LOCAL GOVERNING AUTHORITIES AND AS NEEDED TO SERVICE ANT ITEMS SPECIFIED BY THESE DOCUMENTS.

- 18. NO DEVIATION FROM THE CONTRACT DOCUMENTS SHALL BE MADE WITHOUT WRITTEN APPROVAL FROM THE ARCHITECT.
- 19. CONTRACTOR SHALL COORDINATE WITH ALL EQUIPMENT MANUFACTURERS FOR EQUIPMEN
- 20. NO PRODUCTS CONTAINING ASBESTOS IN ANY FORM SHALL BE USED ON ANY PART OF THIS
- 21. PROVIDE AND MAINTAIN TEMPORARY BARRICADES, CLOSURE WALLS, ETC. AS REQUIRED TO PROTECT THE PUBLIC DURING THE PERIOD OF CONSTRUCTION. CONSTRUCTION BARRICADES TO BE EQUAL TO THE FIRE RATING OF THE WALL(S) THEY REPLACE 22. ARCHITECT IS NOT RESPONSIBLE FOR THE ACCURACY OF THE INFORMATION CONTAINED IN
- OWNER SUPPLIED DOCUMENTS. CONTRACTOR TO VERIFY ALL DIMENSIONS IN THE FIELD PRIOR TO PERFORMANCE OF WORK. 23. PREPARE ALL FLOORS TO RECEIVE NEW FLOOR FINISHES INDICATED, VOIDS SHALL BE FILLED AND ANY SURFACE IRREGULARITIES LEVELED. ALL FLOOR SURFACES ARE TO BE LEVEL,
- CLEAN AND IN SMOOTH CONDITION MEETING THE MANUFACTURERS SPECIFICATIONS PRIOR TO THE INSTALLATION OF ANY FLOOR COVERINGS. 24. ALL FLOORS SHALL BE OF SLIP RESISTANT FINISH SURFACE. STATIC COEFFICIENT OF
- FRICTION SHALL BE 0.6 FOR WALKING SURFACES AND 0.8 FOR RAMPS. FLOORING SHALL BE LABELED WITH STATIC COEFFICIENT OF FRICTION. 25. UNLESS OTHERWISE INDICATED, CLOSETS, VESTIBULES, COLUMNS, PARTITIONED-OFF
- PORTIONS, PROJECTIONS OR RECESSES IN SPACES SHALL HAVE FINISHES TO MATCH THE EXISTING CONDITION FOR RESPECTIVE SPACES IN WHICH THEY OCCUR. 26. THE MECHANICAL, ELECTRICAL AND PLUMBING DRAWINGS ARE SUPPLEMENTARY TO THE ARCHITECTURAL DRAWINGS. SHOULD THERE BE A DISCREPANCY BETWEEN THE ARCHITECTURAL DRAWINGS AND THE CONSULTING ENGINEERS' DRAWINGS, SUCH A
- DISCREPANCY IS TO BE BROUGHT TO THE ATTENTION OF THE ARCHITECT PRIOR TO HE INSTALLATION OF SAID WORK. ANY WORK INSTALLED IN CONFLICT WITH THE ARCHITECTURAL 27. CONTRACTOR IS TO MAKE EXACT DETERMINATION AS TO THE LOCATION OF ALL EXISTING UTILITIES. DO NOT BEGIN WORK UNTIL THIS DETERMINATION HAS BEEN MADE. CONTRACTOR
- IS FULLY RESPONSIBLE FOR DAMAGE CAUSED BY FAILURE TO LOCATE AND PRESERVE UTILITIES.
- 28. PROVIDE GALVANIC ISOLATION BETWEEN DISSIMILAR METALS. 29. CONTINUE GYPSUM BOARD OR PLASTER BEHIND ALL OPENINGS INCLUDING WALL CABINETS, RECESSED FIRE HOSE CABINETS AND ELECTRICAL PANELS AT FIRE/SMOKE RATED WALLS
- 30. ALL PENETRATIONS THOUGH FIRE RATED WALLS AND SHAFTS SHALL BE EQUIPPED WITH DAMPERS, SEALANTS OR OTHER APPROPRIATE AND APPROVED MATERIALS AND METHODS SO AS TO MAINTAIN THAT RATING.
- 31. FINISHES: a) ALL FLOOR FINISHES SHALL BE CLASS 1 PER NFPA 253. FLAME SPREAD FOR ALL WALL AND CEILING FINISHES SHALL NOT EXCEED 25. b) ANY DECORATIONS USED SHALL BE NON COMBUSTIBLE OR FLAME PROOFED IN AN
- c) ALL FINISH MATERIALS SHALL COMPLY WITH REQUIREMENTS OF CBC CHAPTER 7.
- F.S. 0-25 CLASS A SMOKE-DEVELOPED 0-450 F.S. 26-75 CLASS B SMOKE-DEVELOPED 0-450 F.S. 76-200 CLASS C SMOKE-DEVELOPED 0-450

EXISTING ACCESSIBLE PARKING STALLS

ACCESSIBLE

PATH OF TRAVEL

- d) ALL EXTERIOR AND INTERIOR WALL INSULATION SHALL BE NON COMBUSTIBLE
- 32. FIRE EXTINGUISHERS SHALL BE PROVIDED AS REQUIRED BY THE FIRE MARSHAL. TRAVEL TANCE SHALL NOT BE MORE THAN 75' TO ANY FIRE EXTINGUISHER LOCATION. (MIN. RATING 2A:10B:C-CURRENT SF SERVICE TAG) MOUNTED MAXIMUM 54" ABOVE FINISH FLOOF

PROJECT LOCATION: MEDICAL OFFICE BUILDING

SCALE: N.T.S.

SECOND FLOOR

HAZARDOUS MATERIALS: SAVELY HEALTHCARE ARCHITECTS ASSUMES NO RESPONSIBILITY RELATING TO ANY TOXIC MATERIALS, INCLUDING ASBESTOS, AND ASSUMES NO RESPONSIBILITY RELATING TO ITS EXISTENCE OR REMOVAL. THE OWNER WILL TAKE ACTION WITH A CONSULTANT OR SPECIALIST, LICENSED BY THE STATE OF CALIFORNIA, SHOULD ANY HAZARDOUS MATERIALS RELATED SERVICE BE REQUIRED ON THE PROJECT.

PROJECT TEAM

ARCHITECT: SAVELY HEALTHCARE ARCHITECTS

- 18008 SKY PARK CIRCLE, SUITE 290 IRVINE, CA 92614
- (949) 599-6737 GUY LE, PROJECT MANAGER
- SPIRE STRUCTURAL ENGINEERING INC.
- 26461 RANCHO PARKWAY SOUTH LAKE FOREST, CA 92630
- (949) 916-3440 ALEX BLETSOS, PRINCIPAL

MECHANICAL/PLUMBING: GOSS ENGINEERING 255 E. RINCON STREET, SUITE 301

- (951) 340- 1977 BRIAN FOGLE, SENIOR PROJECT MANAGER
- **ELECTRICAL:** FBA ENGINEERING 150 PAULARINO AVENUE, SUITE A120 COSTA MESA, CA 92626

JIM PROCTOR

CORONA, CA 92879

(949) 852-9995

- **INTERIOR DESIGN:** MONTANIO DESIGN GROUP 6672 SANTA SUSANA PASS ROAD SIMI VALLEY, CA 93063
- (805) 522-5662 SYLVIA MONTANIO

PROJECT SCOPE

- CONVERT OFFICE SPACE LOCATED ON THE 2ND FLOOR OF THE ARROWHEAD REGIONAL MEDICAL CENTER MEDICAL OFFICE BUILDING INTO THE AMBULATORY CLINIC FOR ONCOLOGY/INFUSION SERVICES.
- PROJECT LOCATION: MEDICAL OFFICE BUILDING, SECOND FLOOR
- PROJECT SQUARE FOOTAGE: 9,320 SQ. FT.

PROJECT DATA

- **BUILDING ADDRESS:** 400 NORTH PEPPER AVENUE COLTON, CALIFORNIA 92324
- ARROWHEAD REGIONAL MEDICAL CENTER **BUILDING OWNER:**
- MEDICAL OFFICE BUILDING **BUILDING USE:**
- B OFFICE BUILDING (SECOND FLOOR) OCCUPANCY TYPE:
- CONSTRUCTION TYPE:
- **AUTOMATIC SPRINKLERS:**

PROVIDED THROUGHOUT 3 STORIES (WITH PENTHOUSE)

APPLICABLE CODES

- 2016 California Administrative Code (CAC)
- Part 1, Title 24, California Code of Regulations (CCR)
- 2016 California Building Code (CBC) Part 2, Title 24, CCR Based on the 2015 International Building Code (IBC)
- 2016 California Electrical Code (CEC) Part 3, Title 24, CCR Based on the 2014 National Electrical Code (NEC)
- 2016 California Mechanical Code (CMC) Part 4, Title 24, CCR Based on the 2015 Uniform Mechanical Code (UMC)
- 2016 California Plumbing Code (CPC) Part 5, Title 24, CCR Based on the 2015 Uniform Plumbing Code (UPC)
- 2016 California Fire Code (CFC) Part 9, Title 24, CCR Based on the 2015 International Fire Code (IFC)
- NFPA 101, 2018 Edition, Fire Life Safety
- 2016 Green Building Code Exempt for OSHPD 3 Clinics
- 2016 California Energy Code, Part 6

DEFERRED APPROVAL ITEMS

- INSTALLATION OF:
- FIRE SPRINKLER
- EQUIPMENT ANCHORAGE: EXHAUST FAN
- SHALL NOT BE STARTED UNTIL DETAILED PLANS AND SPECIFICATIONS HAVE BEEN APPROVED BY THE AUTHORITY HAVING JURISDICTION.
- THE DRAWINGS AND SPECIFICATIONS OF THE DEFERRED APPROVAL ITEMS MUST BE SUBMITTED TO THE ARCHITECT OR STRUCTURAL ENGINEER OF RECORD FOR REVIEW AND APPROVAL WITH STAMP AND SIGNATURE BEFORE SUBMITTAL TO THE AUTHORITY HAVING JURISDICTION.
- CONSTRUCTION OF DEFERRED APPROVAL ITEMS BEFORE DRAWINGS AND SPECIFICATIONS HAVE BEEN APPROVED BY THE AUTHORITY HAVING JURISDICTION IS DEEMED NON-CONFORMING AND COULD RESULT IN WITHHOLDING OF APPROVAL OF THE ENTIRE PROJECT.

LIST OF DRAWINGS

TITLE SHEET TYPICAL DIAGRAMS & DETAILS

ARCHITECTURAL

- ODE ANALYSIS PLAN CODE ANALYSIS PLAN - PLUMBING FIXTURE COUNT
- DEMOLITION PLAN
- OVERALL FLOOR PLAN
- FLOOR PLAN AREA 'A' FLOOR PLAN - AREA 'B'
- OVERALL SECOND FLOOR REFLECTED CEILING REFLECTED CEILING PLAN - AREA 'A'
- REFLECTED CEILING PLAN AREA 'B' INTERIOR ELEVATIONS
- INTERIOR ELEVATIONS
- **INTERIOR ELEVATIONS**
- **BUILDING SECTIONS**
- **BUILDING SECTIONS SCHEDULES**
- **DETAILS WALL TYPES DETAILS - FRAMING**
- DETAILS DOORS & WINDOWS **DETAILS - CEILINGS DETAILS - CASEWORK**

STRUCTURA

S001 **GENERAL NOTES** S101 TYPICAL DETAILS

DETAILS

- MECHANICAL SYMBOLS, DESIGNATION & ABBREVIATIONS MECHANICAL SCHEDULES
- TITLE 24 COMPLIANCE FORMS M004
- MECHANICAL DEMOLITION PLAN
- MECHANICAL ZONING PLAN PARTIAL MECHANICAL FLOOR PLAN - AREA 'A'
- PARTIAL MECHANICAL PIPING FLOOR PLAN AREA 'A'
- PARTIAL MECHANICAL FLOOR PLAN AREA 'B'
- PARTIAL MECHANICAL PIPING FLOOR PLAN AREA 'B'
- MECHANICAL THIRD FLOOR PLAN
- MECHANICAL ROOF PLAN
- MECHANICAL DETAILS MECHANICAL DETAILS
- M503
- MECHANICAL DETAILS
 MECHANICAL CONTROLS M601
- MECHANICAL CONTROLS MECHANICAL CONTROLS
- SEQUENCE OF OPERATIONS M604 ~~~~
- LEGEND, NOTES, ABBREVIATIONS & PLUMBING SCHEDULE PLUMBING DEMOLITION PLAN
- PARTIAL PLUMBING FLOOR PLAN AREA 'A'
- PARTIAL PLUMBING FLOOR PLAN AREA 'B' PLUMBING THIRD FLOOR PLAN HOT AND COLD WATER RISER DIAGRAM
- PLUMBING DETAILS

- GENERAL NOTES, SYMBOLS LIST & FIXTURE SCHEDULE
- SINGLE LINE DIAGRAM PANEL SCHEDULES
- DETAILS
- LIGHTING CONTROL DIAGRAMS BUILDING ENERGY ANALYSIS REPORT (TITLE 24)
- ELECTRICAL DEMOLITION PLAN
- SECOND FLOOR OVERALL ELECTRICAL PLAN

EMERGENCY EGRESS PHOTOMETRIC PLAN

- PARTIAL SECOND FLOOR POWER & SIGNAL PLAN AREA 'A' PARTIAL SECOND FLOOR POWER & SIGNAL PLAN AREA 'B'
- PARTIAL SECOND FLOOR LIGHTING PLAN AREA 'A' PARTIAL SECOND FLOOR LIGHTING PLAN AREA 'B'

- FLOOR PATTERN PLAN & ACCENT WALL FINISH PLAN
- INTERIOR ELEVATIONS & DETAILS INTERIOR DETAILS
 - INTERIOR ROOM FINISH SCHEDULE
- **AGENCY APPROVAL**

PROFESSIONAL SEALS

Healthcare Architects

18008 Sky Park Circle, Suite 290

MEDICAL OFFICE BUILDING

Irvine, CA 92614

(949) 431-0071

ARROWHEAD

COLTON, CALIFORNIA 92324

400 N. PEPPER AVE.

NO. DATE

09.12.2019

ARCHITECTURE + PLANNING + DESIGN

REGIONAL MEDICAL CENTER

REVISIONS


ADDENDUM 1

ONCOLOGY-AMBULATORY CLINIC


SHEET TITLE

SHEET NUMBER

G001

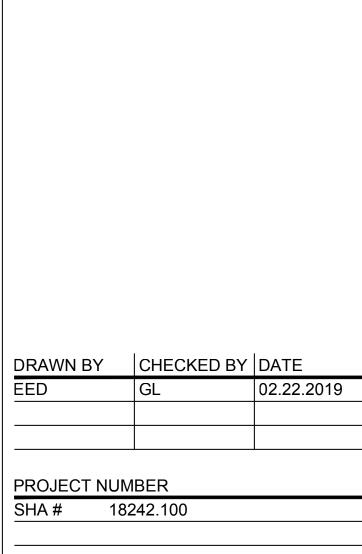

TITLE SHEET

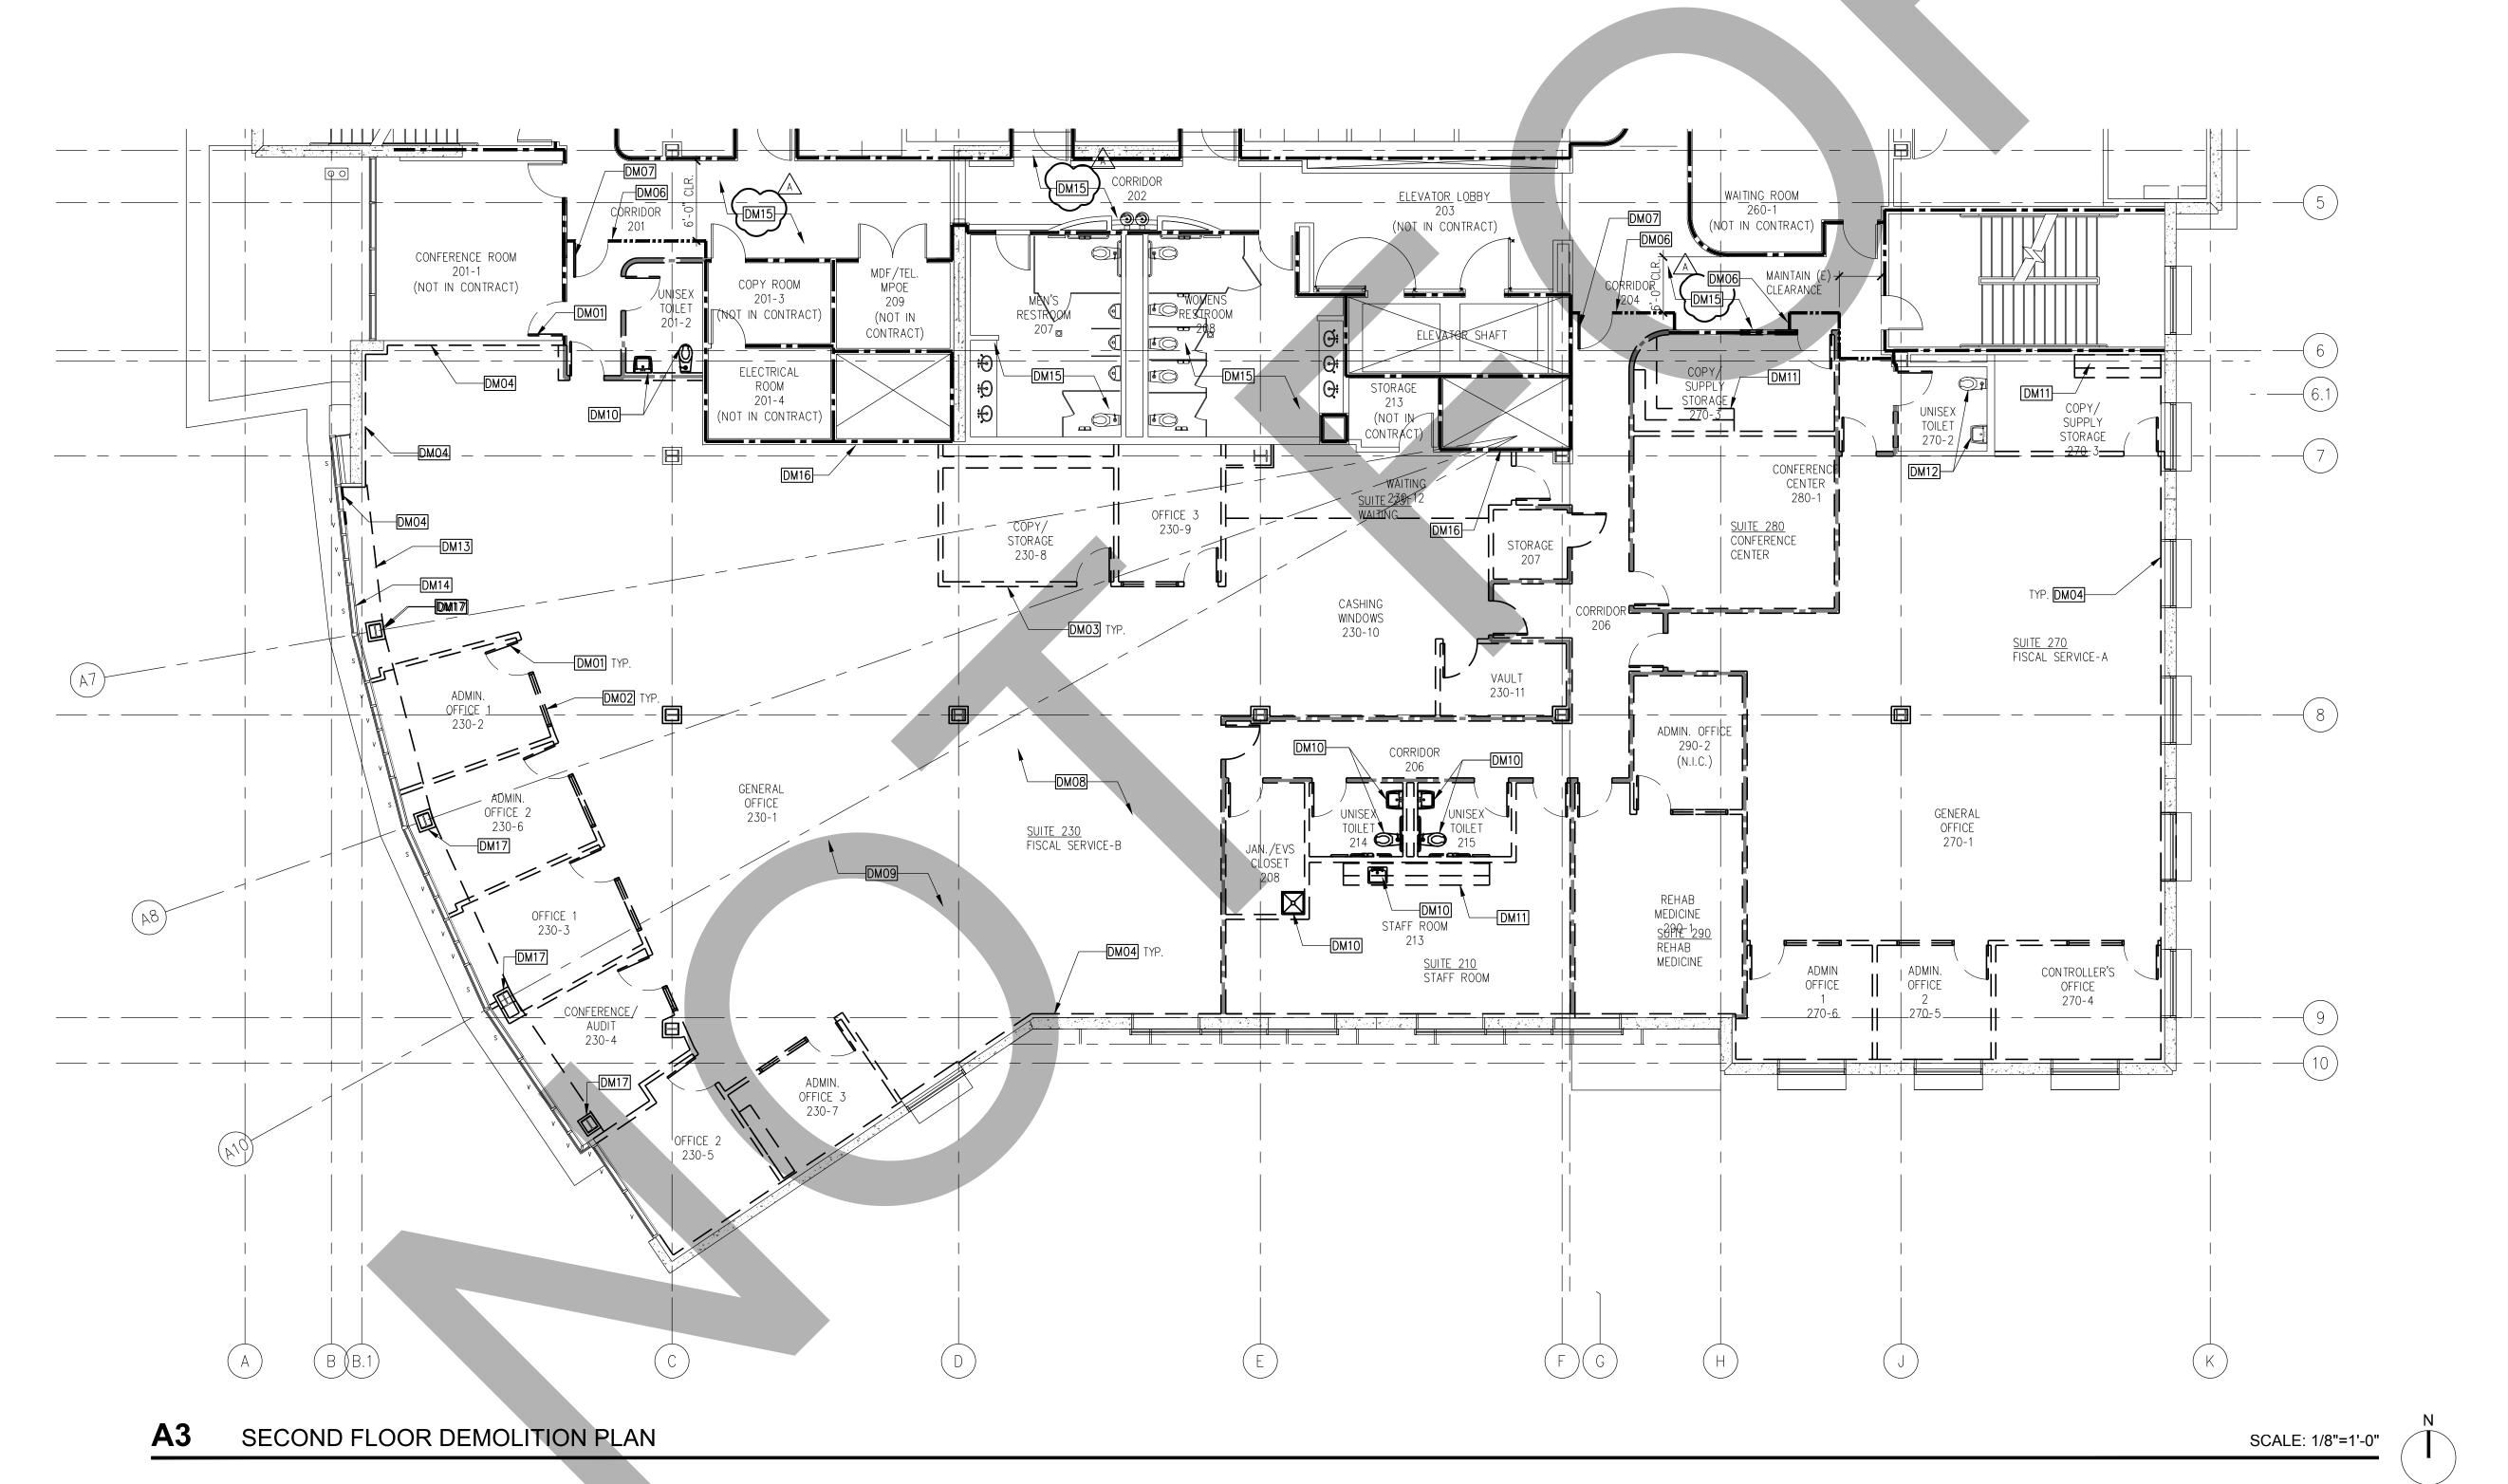

GENERAL NOTES

- 1. DRAWINGS OF EXISTING CONDITIONS HAVE BEEN COMPILED FROM EXISTING DATA SUPPLIED TO THE ARCHITECT BY THE OWNER. THE ARCHITECT MAKES NO WARRANTY, EITHER EXPRESSED OR IMPLIED, FOR THE ACCURACY OR COMPLETENESS OF THE EXISTING INFORMATION RECORDED. FIELD VERIFY ALL EXISTING CONDITIONS. NOTIFY THE ARCHITECT IMMEDIATELY OF ANY DISCREPANCIES.
- VERIFY LOCATIONS OF EXISTING ELECTRICAL, PLUMBING, AND MECHANICAL UTILITIES. LOCATE AND PROTECT UTILITIES TO REMAIN. DISCONNECT, REMOVE AND CAP DESIGNATED UTILITIES WITHIN THE DEMOLITION AREA. REFER TO THE ELECTRICAL DEMOLITION DRAWINGS FOR ADDITIONAL
- PROVIDE REROUTING OF UTILITIES SERVING ADJACENT AREAS TO MAINTAIN UNINTERRUPTED SERVICE.
- 4. REMOVAL AND DISPOSAL OF DEMOLITION DEBRIS IS THE RESPONSIBILITY OF THE CONTRACTOR. VERIFY THE HAULING ROUTE THROUGH THE BUILDING, THE DEMOLITION STAGING AREA, AND THE LOCATION OF THE DUMPSTERS WITH THE FACILITY REPRESENTATIVE PRIOR TO THE START OF DEMOLITION.
- TO THE START OF DEMOLITION. REMOVE, PROTECT, AND TURN OVER SUCH ITEMS BY DIRECTED BY THE FACILITY. 6. TEMPORARY FIRE BARRIERS; PROTECT ADJACENT SPACES FROM DAMAGE DURING THE PROGRESS OF THE WORK. PROVIDE TEMPORARY FIRE RATED

THE FACILITY RESERVES THE RIGHT TO SALVAGE ANY DEMOLISHED ITEM. VERIFY ITEMS TO BE SALVAGED WITH THE FACILITY REPRESENTATIVE PRIOR

- PARTITIONS AS REQUIRED BY THE AUTHORITY HAVING JURISDICTION TO ENSURE PUBLIC SAFETY AND TO ALLOW BUILDING OCCUPANCY. 7. PROVIDE DUST BARRIERS AROUND ALL OPENINGS TO AND FROM THE CONSTRUCTION AREA PER THE OWNER'S INFECTION PREVENTION POLICY.
- PROVIDE ALL MEANS NECESSARY TO INHIBIT DUST FROM ENTERING OTHER PORTION OF THE FACILITY. SURVEY EXISTING FLOORS AND CLEARLY IDENTIFY LOCATIONS OF ALL
- BEAMS AND JOISTS. 9. THE USE OF VISQUEEN OR SIMILAR TYPE OF MATERIAL AS A TEMPORARY CONSTRUCTION BARRIER WHERE A FIRE SEPARATION IS REQUIRED, SHALL NOT BE PERMITTED. A TEMPORARY BARRIER SHALL MEET THE SAME FIRE
- RATING AS WOULD THE PERMANENT PARTITION. 10. CONTRACTOR SHALL REMOVE AND REPLACE ONE, OR TWO, EXTERIOR WINDOWS FOR EQUIPMENT OR MATERIAL DELIVERIES TO, OR FOR TRASH REMOVAL FROM, THE PROJECT. THE LOCATION(S) WILL BE COORDINATED AND APPROVED BY THE CONSTRUCTION MANAGER AND ARMC FACILITIES. CONTRACTOR SHALL USE ALL DUE CARE AND CAUTION IN DOING THE WORK. WHEN THE WINDOW(S) ARE
- RE-INSTALLED THERE SHALL BE NO DIFFERENCE IN CONSTRUCTION DETAIL OR APPEARANCE FROM THE ORIGINAL CONDITION. DURING CONSTRUCTION, THE OPENINGS SHALL BE WEATHER PROTECTED TO PREVENT MOISTURE INTRUSION.

KEYNOTES

ENTIRE SUITE

- DM01 DEMOLISH EXISTING DOOR AND FRAME COMPLETE
- DM02 DEMOLISH EXISTING GLAZING AND FRAME COMPLETE
- DM03 DEMOLISH EXISTING GYPSUM BOARD PARTITION COMPLETE
- DM04 DEMOLISH EXISTING GYPSUM BOARD ON ONE SIDE ONLY, PROTECT FRAMING IN PLACE
- DM05 DEMOLISH PORTION OF EXISTING GYPSUM BOARD PARTITION ONLY AS REQUIRED BY NEW CONSTRUCTION
- DM06 TEMPORARY CONSTRUCTION BARRIER, FINISH AND PAINT CORRIDOR SIDE OF BARRIER, PROTECT EXISTING FINISHES IN PLACE
- DM07 TEMPORARY FIRE DOOR WITH STEEL FRAME & CLOSER, DOOR OPENS IN
- DM08 DEMOLISH EXISTING FLOORING FINISH COMPLETE, THROUGHOUT THE
- DM09 DEMOLISH EXISTING CEILING SYSTEM COMPLETE, THROUGHOUT THE
- DM10 DEMOLISH EXISTING PLUMBING FIXTURE COMPLETE
- DM11 DEMOLISH EXISTING UPPER AND LOWER CASEWORK COMPLETE
- DM12 EXISTING PLUMBING FIXTURE TO REMAIN, PROTECT IN PLACE
- DM13 DEMOLISH EXISTING GYPSUM BOARD SOFFIT (ABOVE) COMPLETE DM14 PROTECT EXISTING GYPSUM BOARD ALONG THE INSIDE OF CURTAIN IN
- PLACE, DEMOLISH ONLY AS REQUIRED BY NEW CONSTRUCTION DM15 DEMO CEILING AS REQUIRED FOR MECHANICAL WORK REFER TO
- MECHANICAL TO DETERMINE EXTENT OF DEMOLITION
- DM16 DEMO SHAFT WALL AS REQUIRED FOR MECHANICAL WORK REFER TO MECHANICAL TO DETERMINE EXTENT OF DEMO
- DM17 DEMOLISH EXISTING GYPSUM BOARD COLUMN FURRING COMPLETE

LEGEND

EXISTING NON RATED WALL TO REMAIN EXISTING CONCRETE WALL TO REMAIN EXISTING 1-HOUR RATED WALL TO REMAIN _ _ _ _ _ _ WALL TO BE DEMOLISHED _ _ _ _ _ _ 1-HOUR RATED WALL TO BE DEMOLISHED

DOOR AND FRAME TO BE DEMOLISHED

KEY PLAN

AREA 'B'



ARCHITECT

Savely # Healthcare Architects

ARCHITECTURE + PLANNING + DESIGN

18008 Sky Park Circle, Suite 290 Irvine, CA 92614 (949) 431-0071

PROJECT

ARROWHEAD REGIONAL MEDICAL CENTER

MEDICAL OFFICE BUILDING 400 N. PEPPER AVE. **COLTON, CALIFORNIA 92324**

ONCOLOGY-AMBULATORY CLINIC

REVISIONS NO. DATE <u>/</u>A\ 09.12.2019 **ADDENDUM 1**

PROFESSIONAL SEALS




AGENCY APPROVAL


DRAWN BY CHECKED BY DATE 02.22.2019

PROJECT NUMBER SHA # 18242.100


SHEET TITLE **DEMOLITION PLAN**

SHEET NUMBER

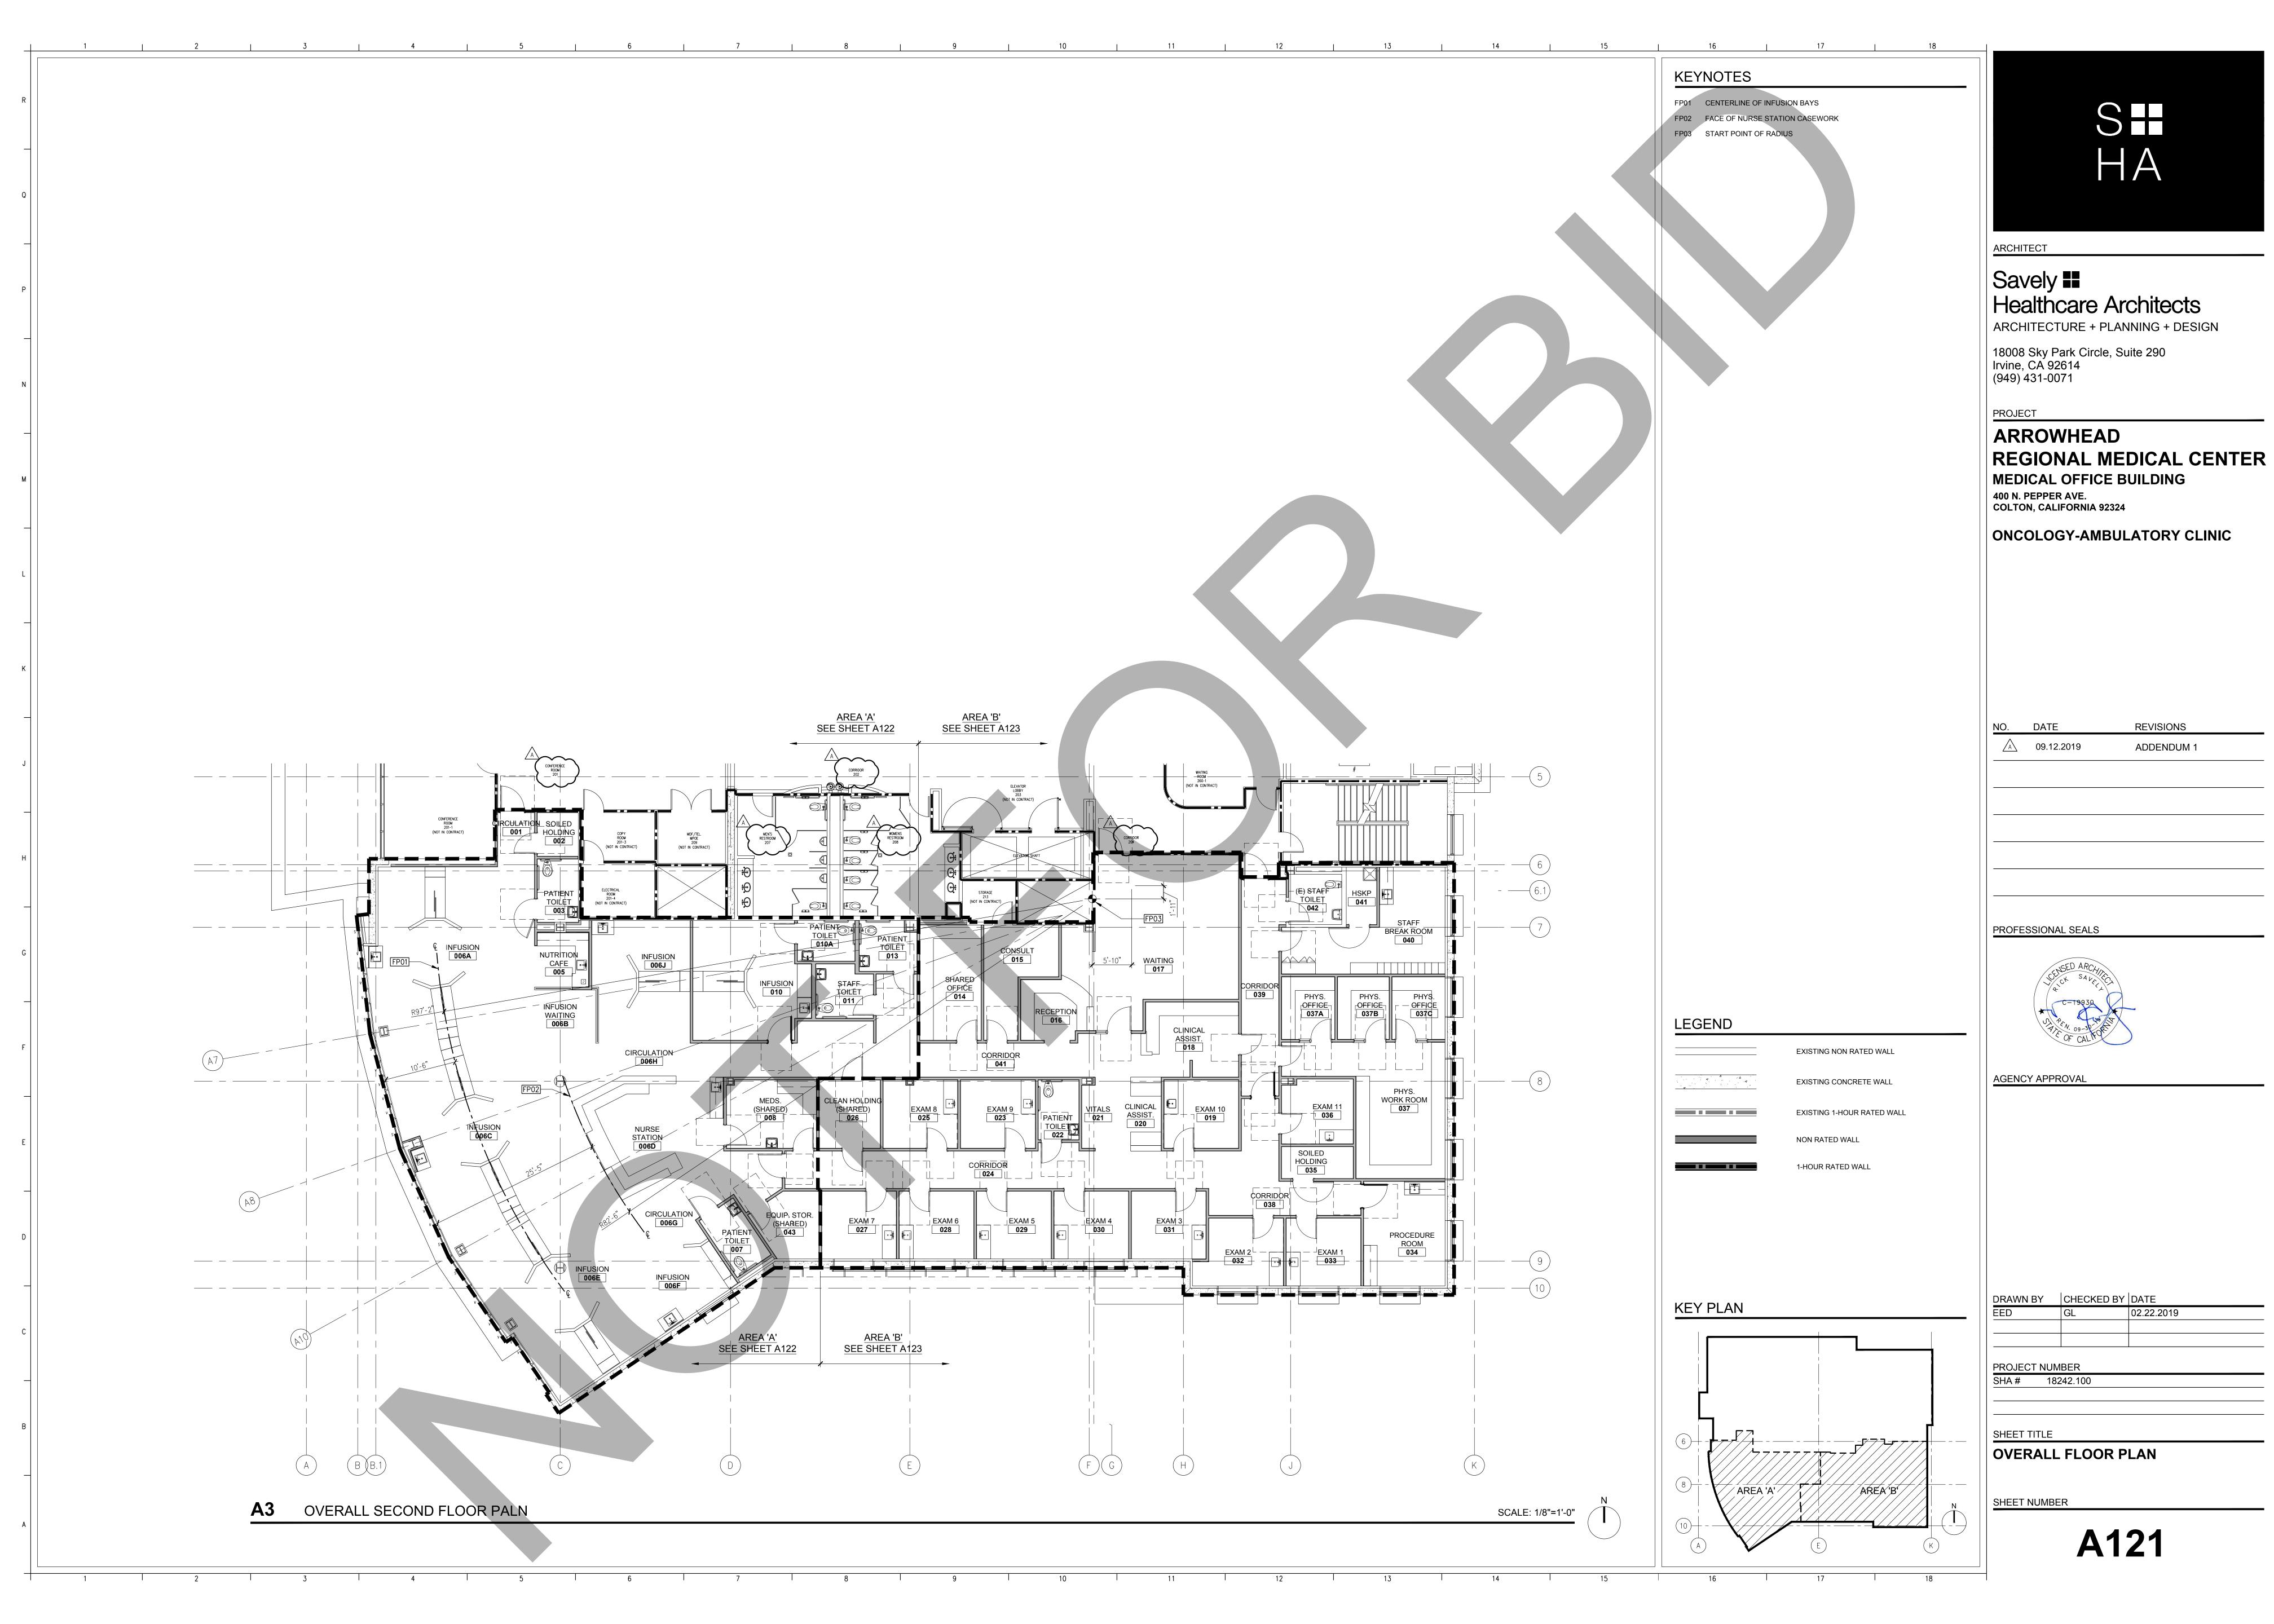

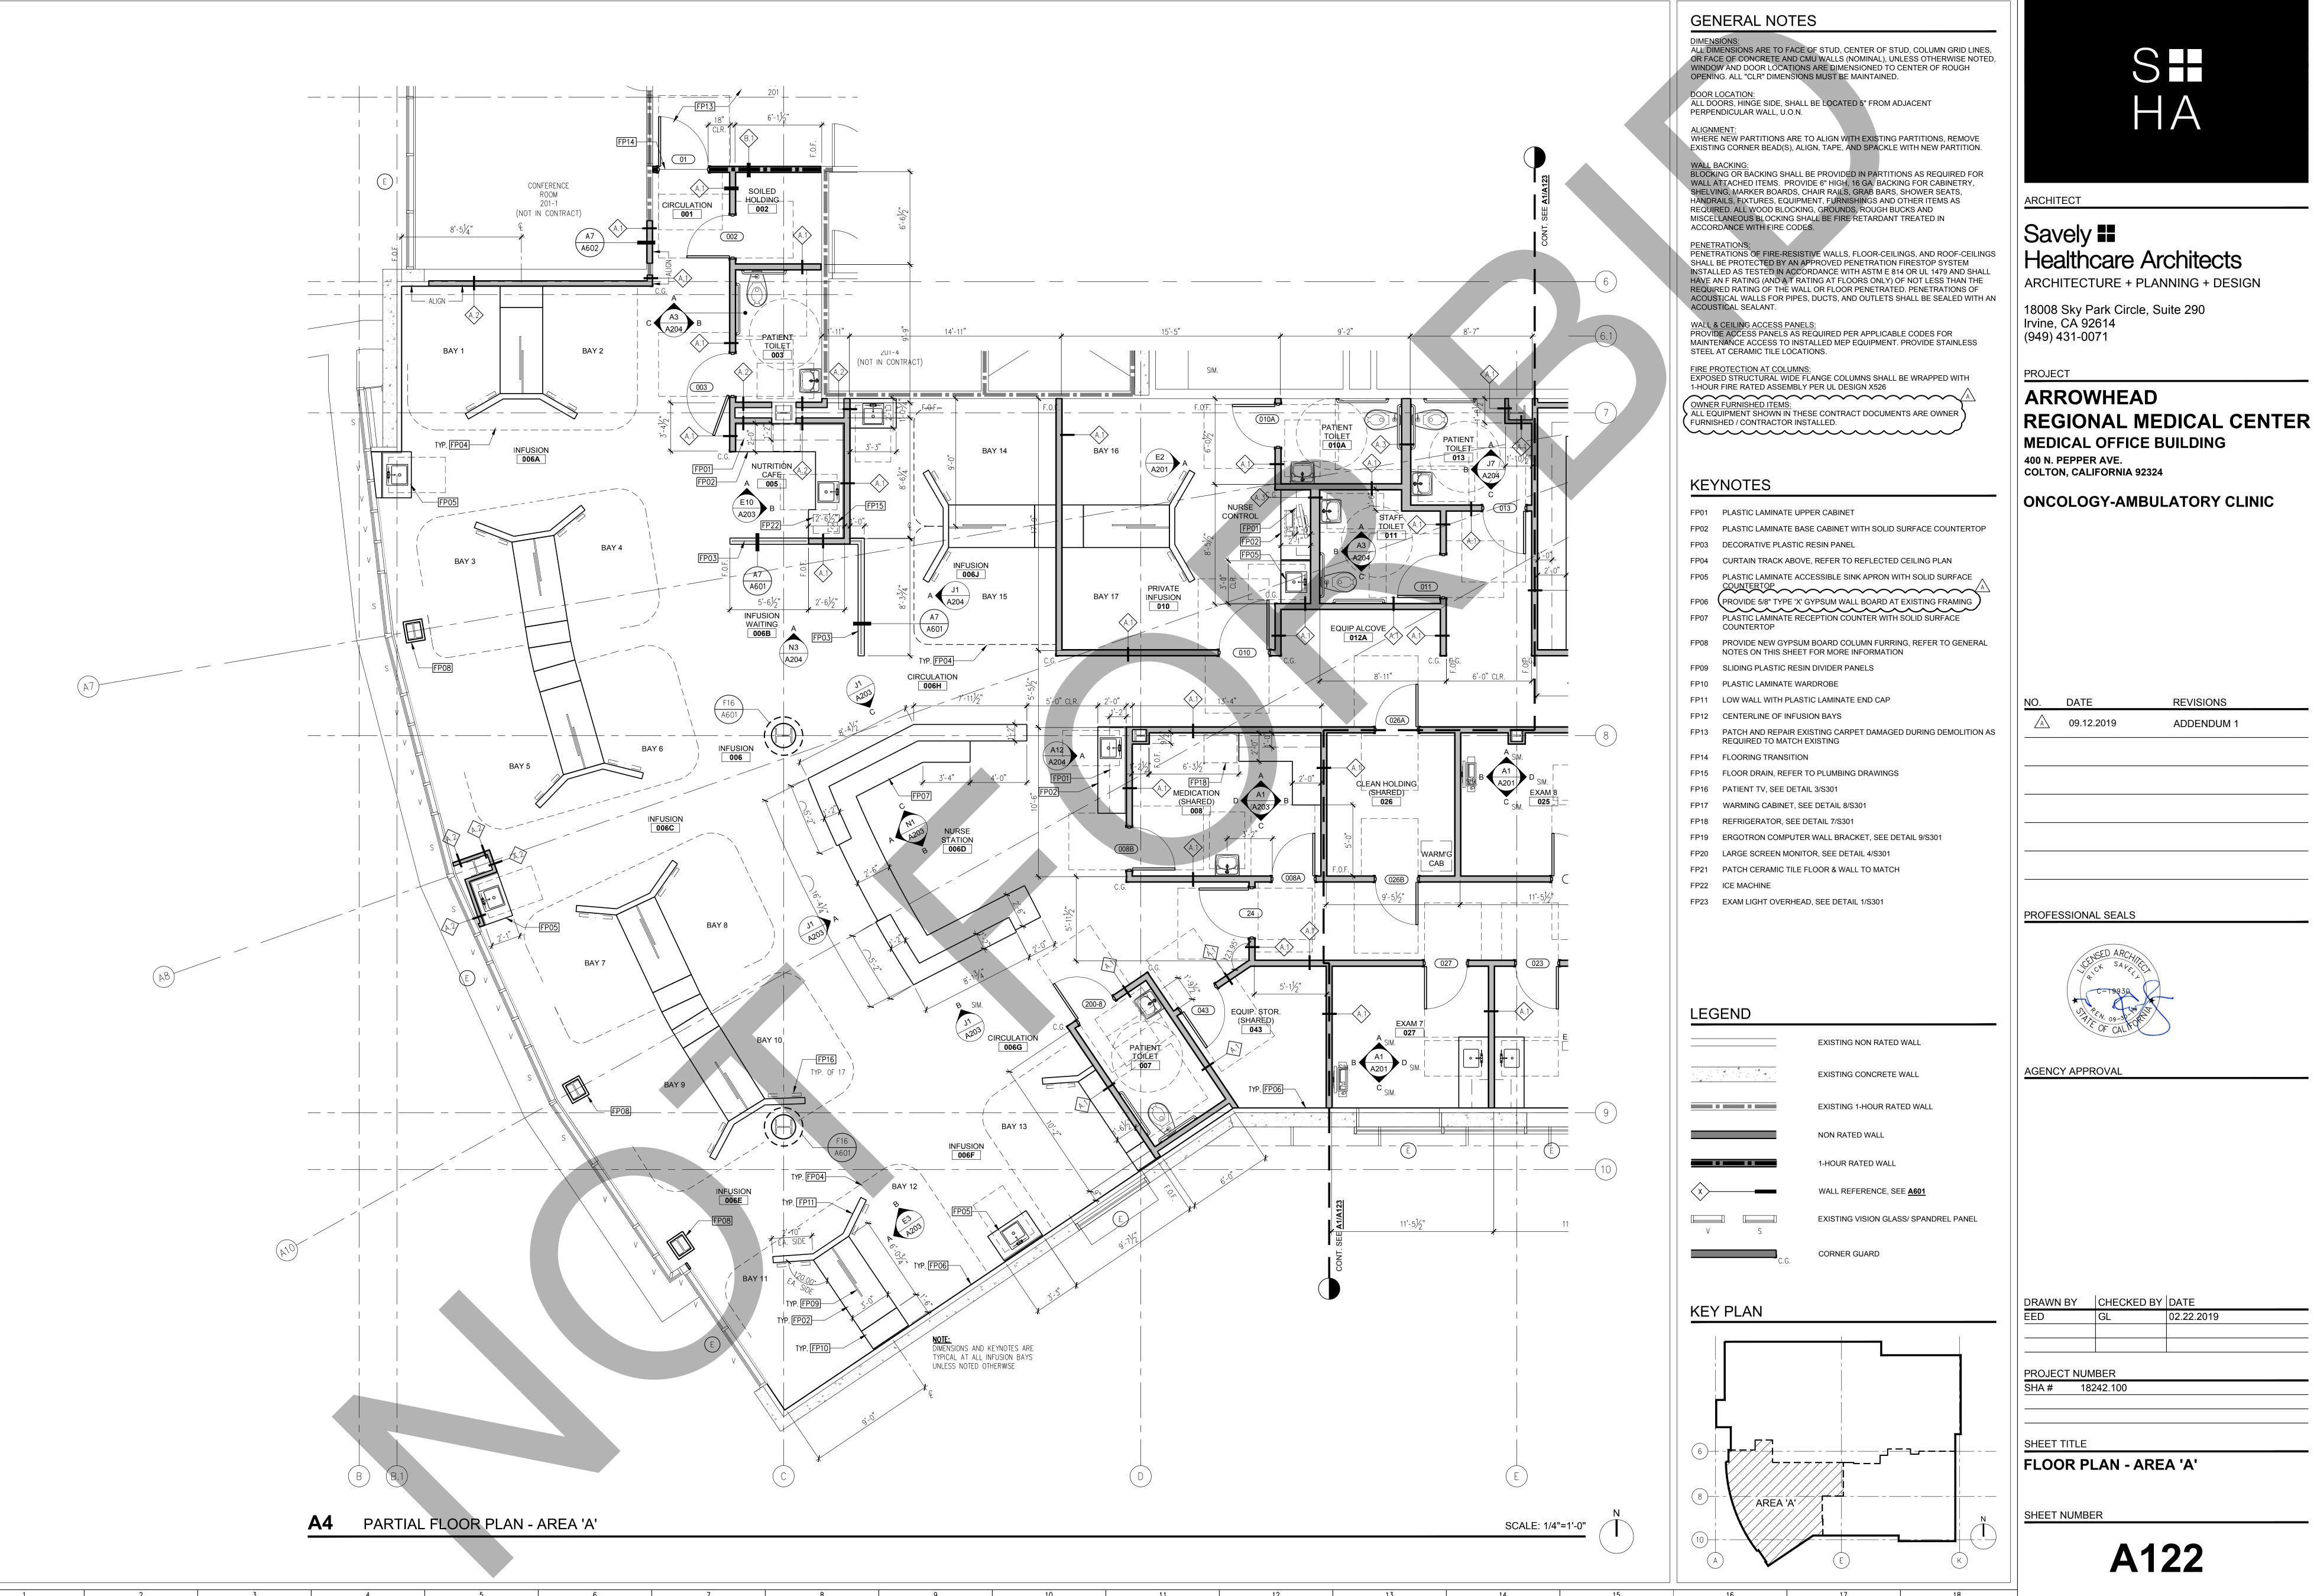

NO.	DATE	REVISIONS	
Â	09.12.2019	ADDENDUM 1	

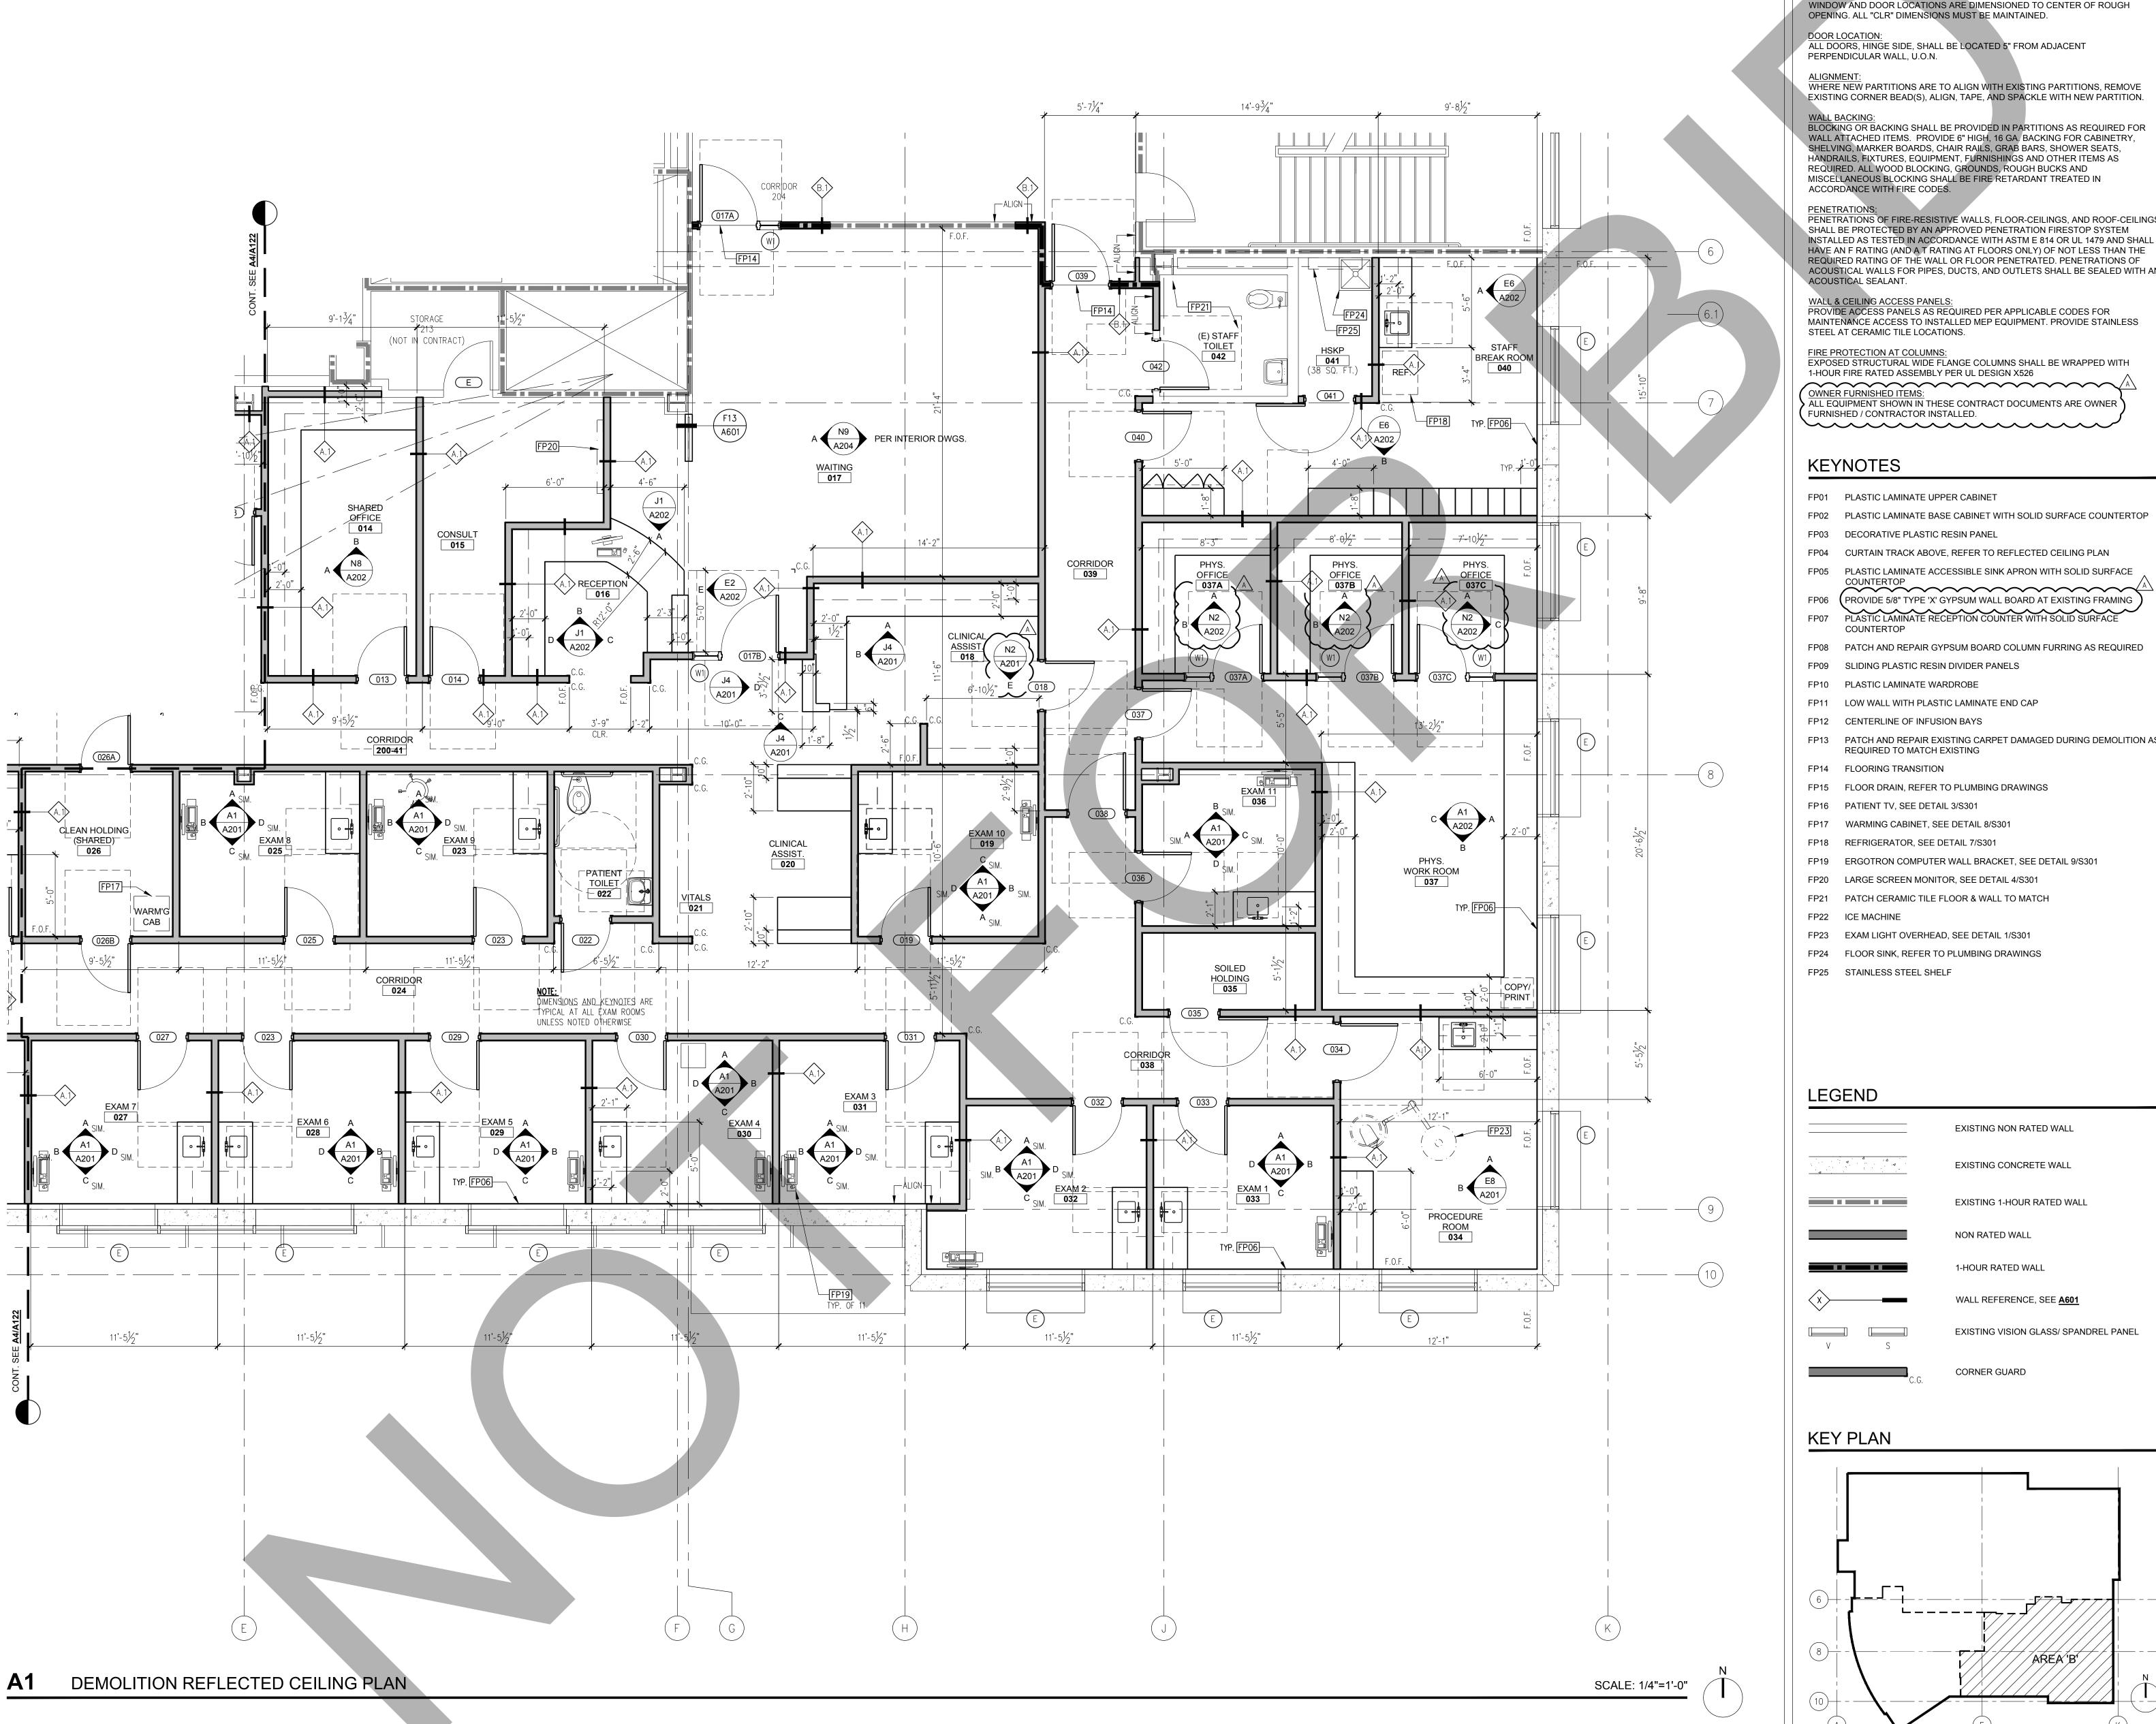

GENERAL NOTES

ALL DIMENSIONS ARE TO FACE OF STUD, CENTER OF STUD, COLUMN GRID LINES, OR FACE OF CONCRETE AND CMU WALLS (NOMINAL), UNLESS OTHERWISE NOTED, WINDOW AND DOOR LOCATIONS ARE DIMENSIONED TO CENTER OF ROUGH OPENING. ALL "CLR" DIMENSIONS MUST BE MAINTAINED.

ALL DOORS, HINGE SIDE, SHALL BE LOCATED 5" FROM ADJACENT

WHERE NEW PARTITIONS ARE TO ALIGN WITH EXISTING PARTITIONS, REMOVE EXISTING CORNER BEAD(S), ALIGN, TAPE, AND SPACKLE WITH NEW PARTITION.

WALL BACKING:
BLOCKING OR BACKING SHALL BE PROVIDED IN PARTITIONS AS REQUIRED FOR WALL ATTACHED ITEMS. PROVIDE 6" HIGH, 16 GA, BACKING FOR CABINETRY, SHELVING, MARKER BOARDS, CHAIR RAILS, GRAB BARS, SHOWER SEATS, HANDRAILS, FIXTURES, EQUIPMENT, FURNISHINGS AND OTHER ITEMS AS REQUIRED. ALL WOOD BLOCKING, GROUNDS, ROUGH BUCKS AND MISCELLANEOUS BLOCKING SHALL BE FIRE RETARDANT TREATED IN

PENETRATIONS OF FIRE-RESISTIVE WALLS, FLOOR-CEILINGS, AND ROOF-CEILINGS SHALL BE PROTECTED BY AN APPROVED PENETRATION FIRESTOP SYSTEM INSTALLED AS TESTED IN ACCORDANCE WITH ASTM E 814 OR UL 1479 AND SHALL HAVE AN F RATING (AND A T RATING AT FLOORS ONLY) OF NOT LESS THAN THE REQUIRED RATING OF THE WALL OR FLOOR PENETRATED. PENETRATIONS OF ACOUSTICAL WALLS FOR PIPES, DUCTS, AND OUTLETS SHALL BE SEALED WITH AN

WALL & CEILING ACCESS PANELS:
PROVIDE ACCESS PANELS AS REQUIRED PER APPLICABLE CODES FOR
MAINTENANCE ACCESS TO INSTALLED MEP EQUIPMENT. PROVIDE STAINLESS

EXPOSED STRUCTURAL WIDE FLANGE COLUMNS SHALL BE WRAPPED WITH 1-HOUR FIRE RATED ASSEMBLY PER UL DESIGN X526 OWNER FURNISHED ITEMS: ALL EQUIPMENT SHOWN IN THESE CONTRACT DOCUMENTS ARE OWNER


- FP01 PLASTIC LAMINATE UPPER CABINET
- FP02 PLASTIC LAMINATE BASE CABINET WITH SOLID SURFACE COUNTERTOP
- FP03 DECORATIVE PLASTIC RESIN PANEL
- FP04 CURTAIN TRACK ABOVE, REFER TO REFLECTED CEILING PLAN
- FP05 PLASTIC LAMINATE ACCESSIBLE SINK APRON WITH SOLID SURFACE
- FP06 PROVIDE 5/8" TYPE 'X' GYPSUM WALL BOARD AT EXISTING FRAMING
- FP08 PATCH AND REPAIR GYPSUM BOARD COLUMN FURRING AS REQUIRED
- FP10 PLASTIC LAMINATE WARDROBE
- FP11 LOW WALL WITH PLASTIC LAMINATE END CAP
- FP13 PATCH AND REPAIR EXISTING CARPET DAMAGED DURING DEMOLITION AS REQUIRED TO MATCH EXISTING
- FP15 FLOOR DRAIN, REFER TO PLUMBING DRAWINGS
- FP17 WARMING CABINET, SEE DETAIL 8/S301
- FP19 ERGOTRON COMPUTER WALL BRACKET, SEE DETAIL 9/S301
- FP20 LARGE SCREEN MONITOR, SEE DETAIL 4/S301
- FP21 PATCH CERAMIC TILE FLOOR & WALL TO MATCH
- FP24 FLOOR SINK, REFER TO PLUMBING DRAWINGS

EXISTING NON RATED WALL EXISTING CONCRETE WALL

NON RATED WALL 1-HOUR RATED WALL

WALL REFERENCE, SEE A601 EXISTING VISION GLASS/ SPANDREL PANEL

CORNER GUARD

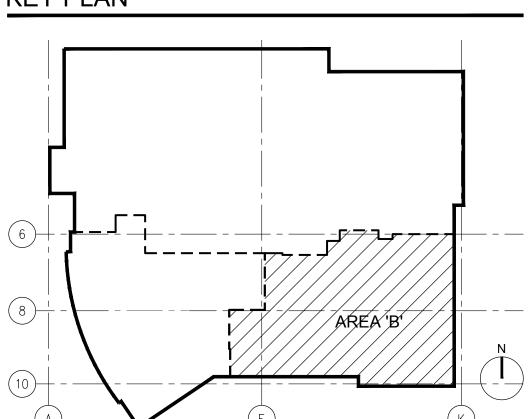



ARCHITECT

Savely **#** Healthcare Architects

ARCHITECTURE + PLANNING + DESIGN

18008 Sky Park Circle, Suite 290 Irvine, CA 92614 (949) 431-0071

PROJECT

ARROWHEAD REGIONAL MEDICAL CENTER

MEDICAL OFFICE BUILDING 400 N. PEPPER AVE. **COLTON, CALIFORNIA 92324**

ONCOLOGY-AMBULATORY CLINIC

REVISIONS NO. DATE <u>/</u>A\ 09.12.2019 ADDENDUM 1

PROFESSIONAL SEALS




AGENCY APPROVAL


DRAWN BY | CHECKED BY | DATE 02.22.2019

PROJECT NUMBER SHA # 18242.100

SHEET TITLE FLOOR PLAN - AREA 'B'

SHEET NUMBER

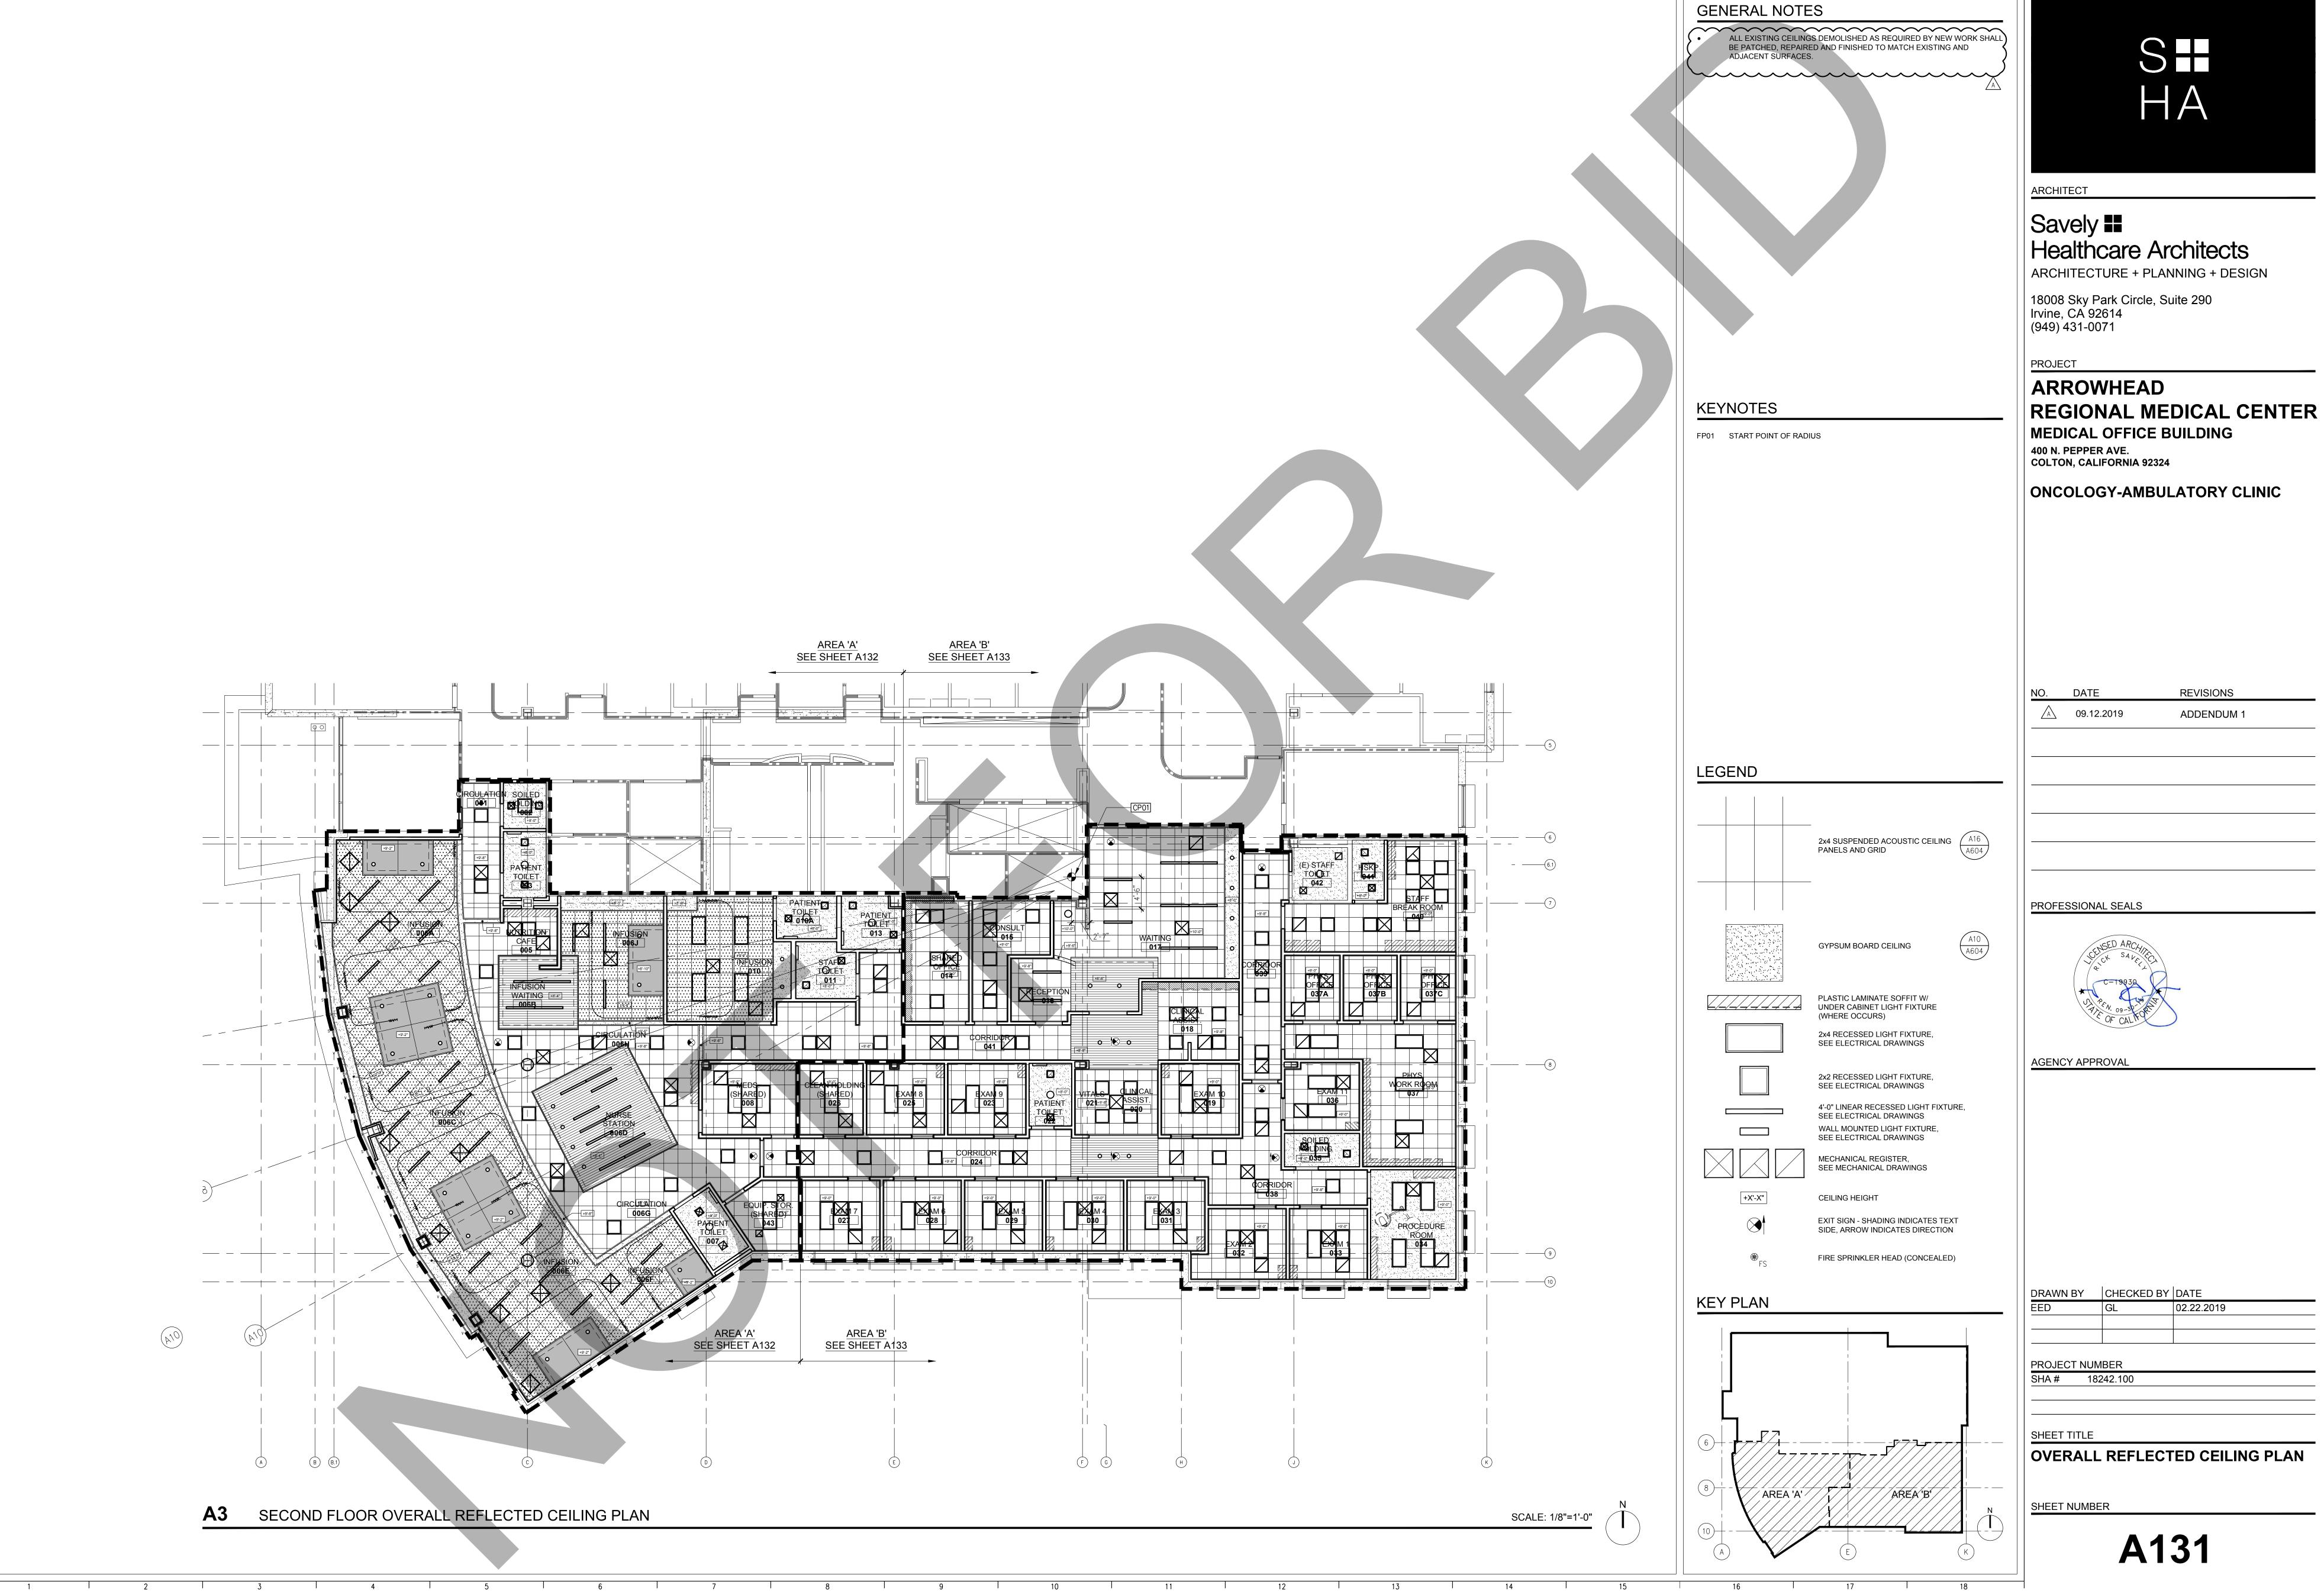

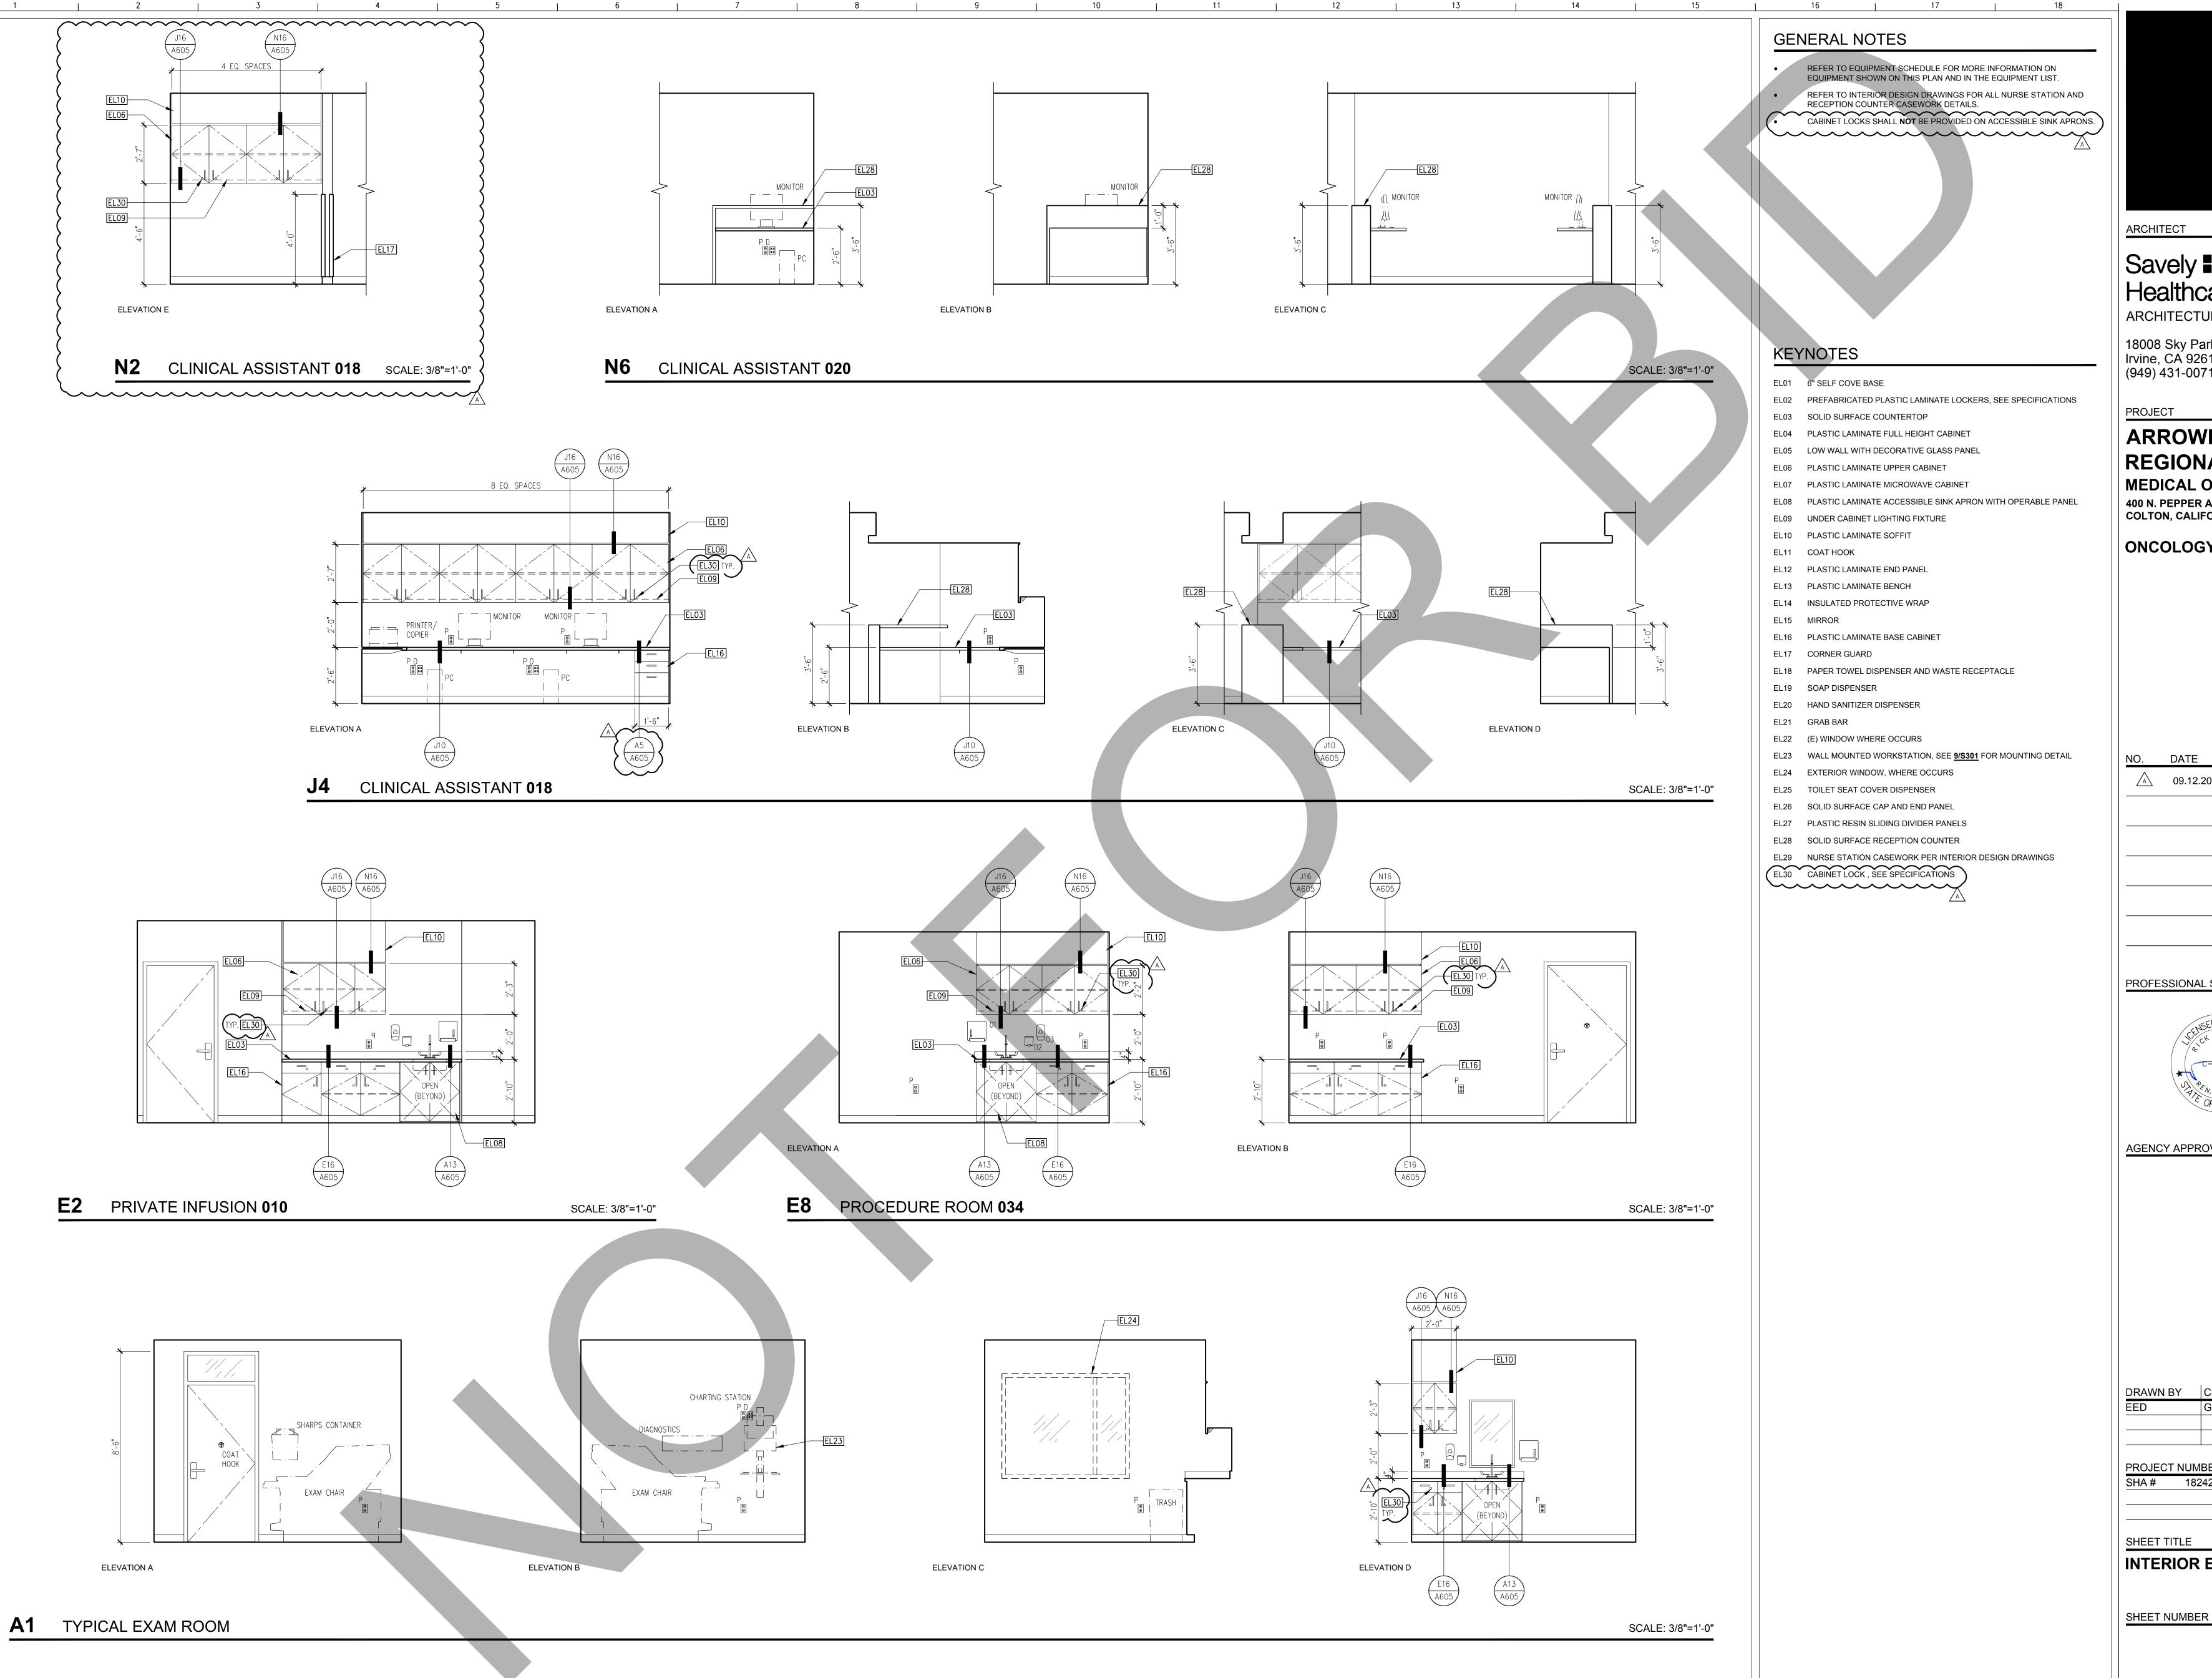

ARCHITECT

Savely **#** Healthcare Architects

ARCHITECTURE + PLANNING + DESIGN

18008 Sky Park Circle, Suite 290 Irvine, CA 92614 (949) 431-0071

PROJECT

ARROWHEAD

REGIONAL MEDICAL CENTER MEDICAL OFFICE BUILDING

400 N. PEPPER AVE. COLTON, CALIFORNIA 92324

ONCOLOGY-AMBULATORY CLINIC

REVISIONS NO. DATE <u>A</u> 09.12.2019 ADDENDUM 1

PROFESSIONAL SEALS




AGENCY APPROVAL

DRAWN BY | CHECKED BY | DATE 02.22.2019


PROJECT NUMBER SHA # 18242.100


INTERIOR ELEVATIONS

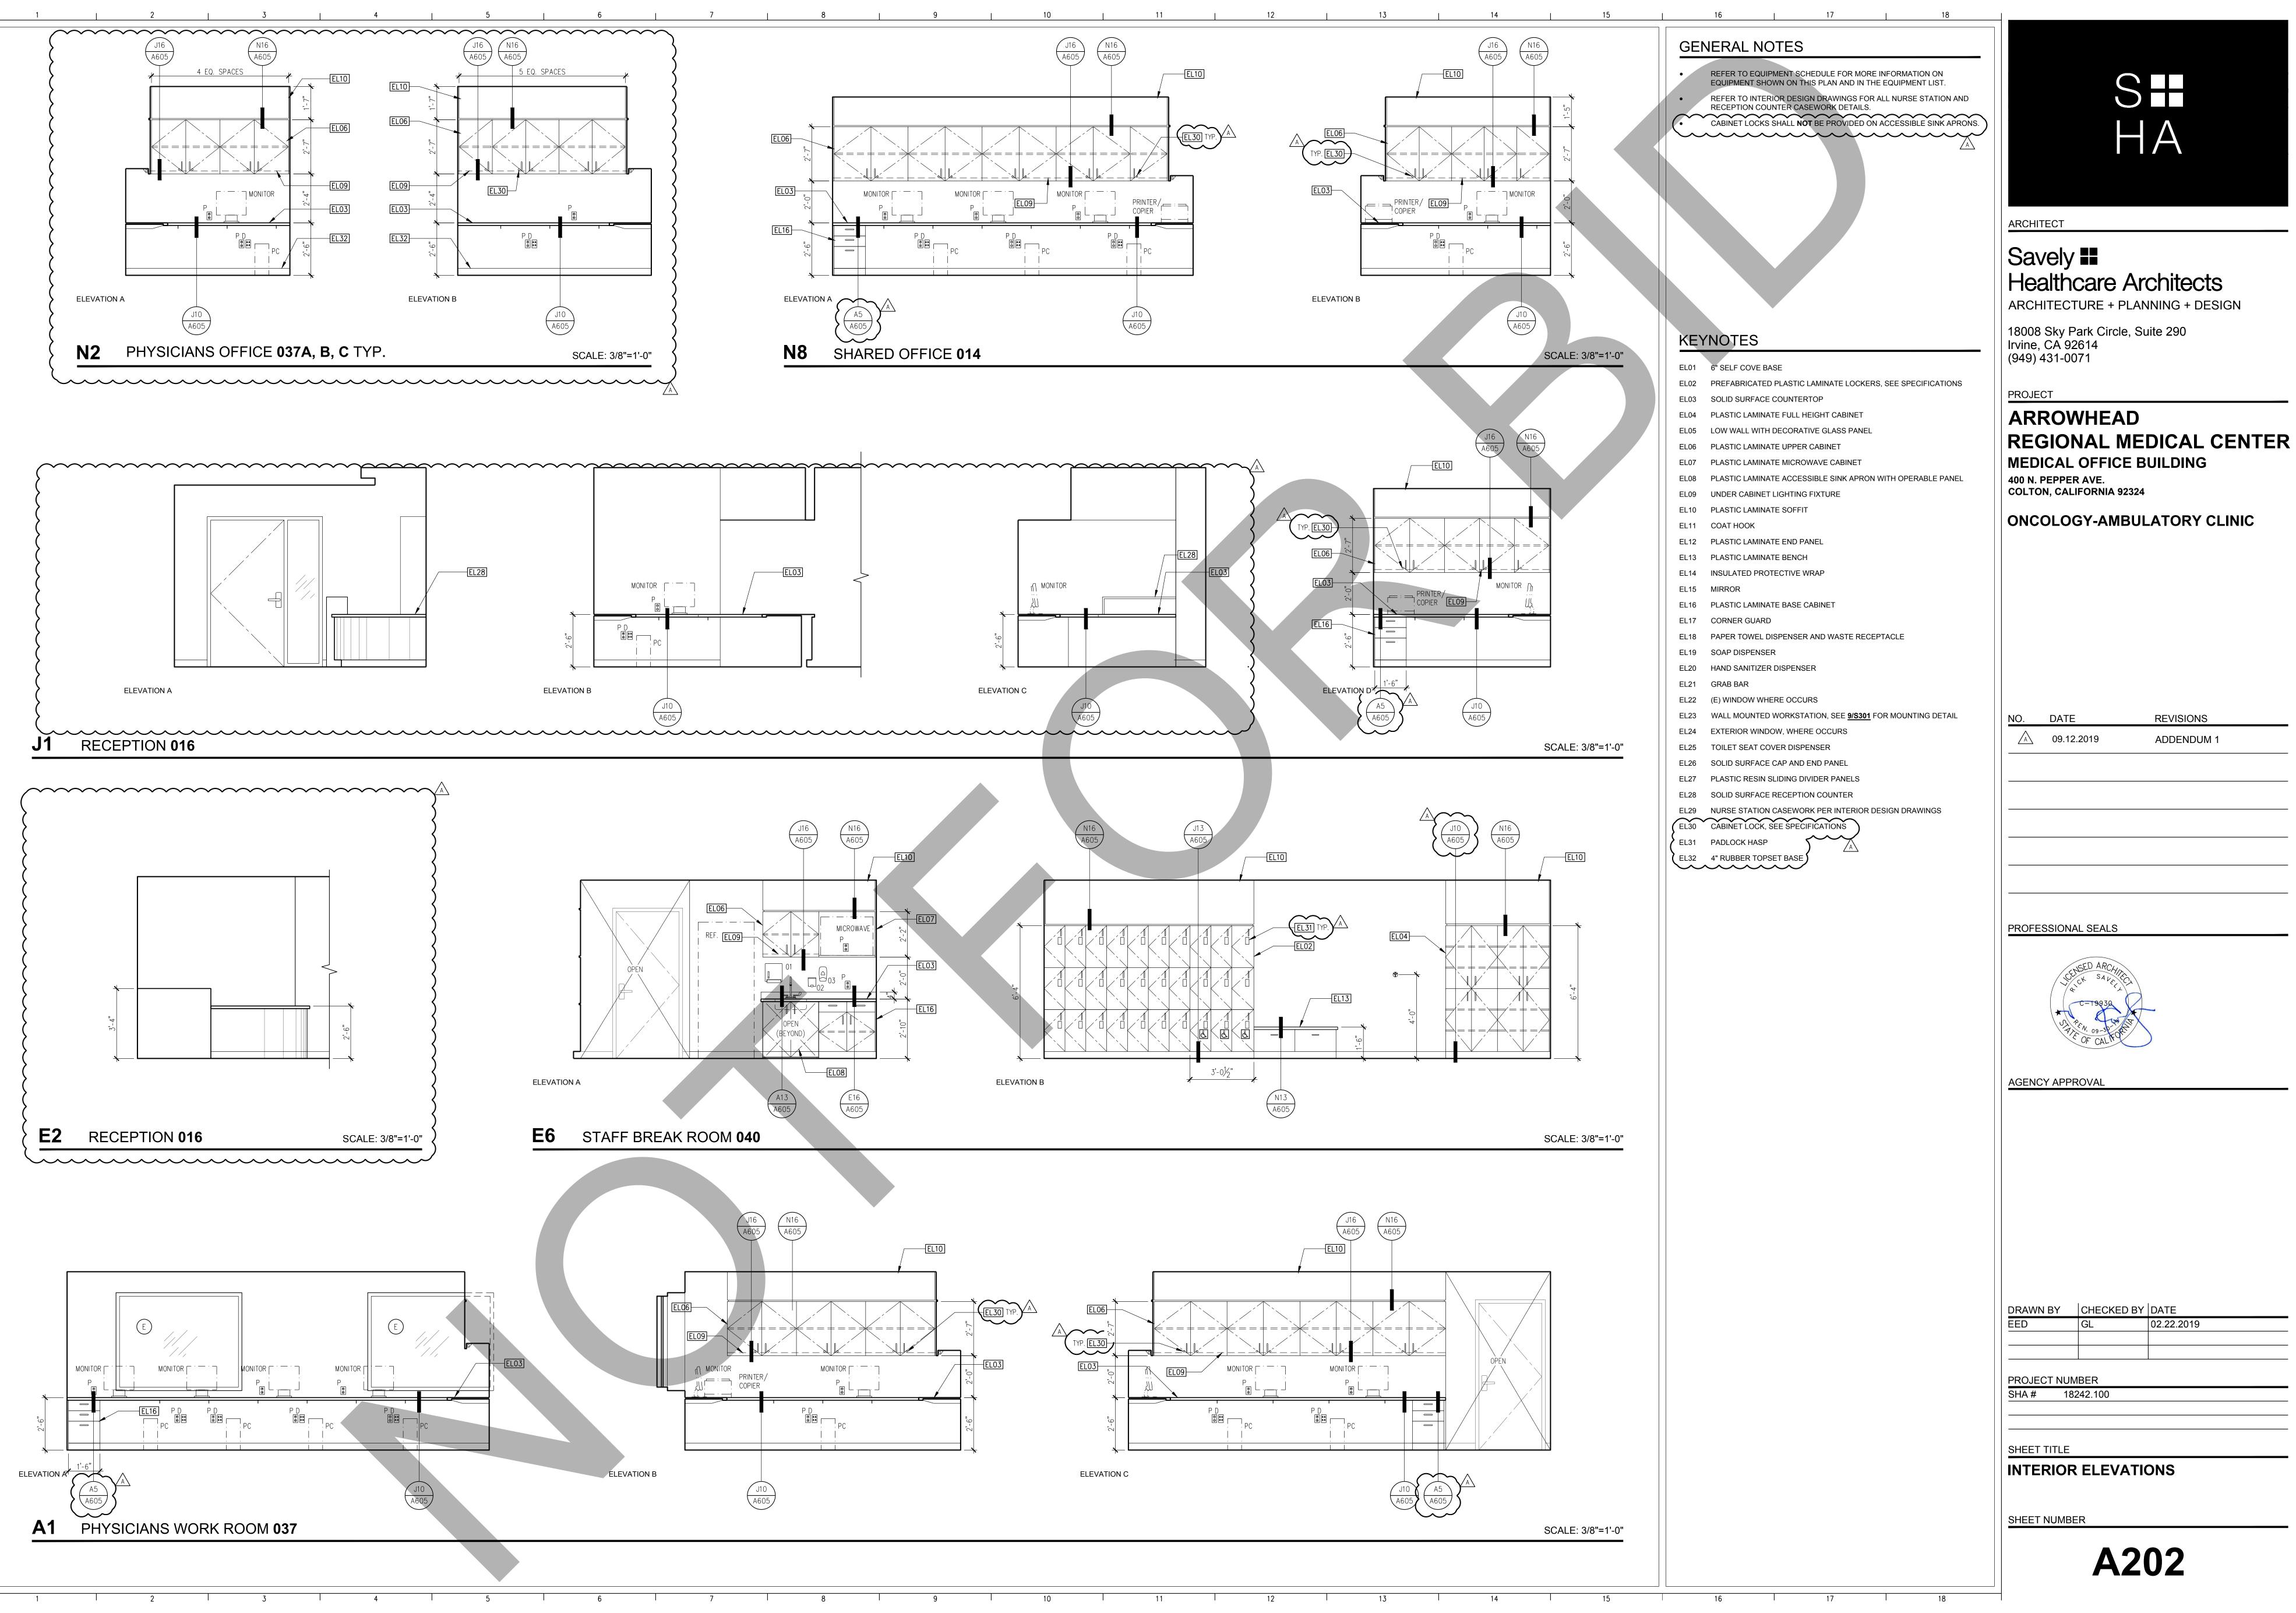

ONCOLOGY-AMBULATORY CLINIC

REVISIONS ADDENDUM 1

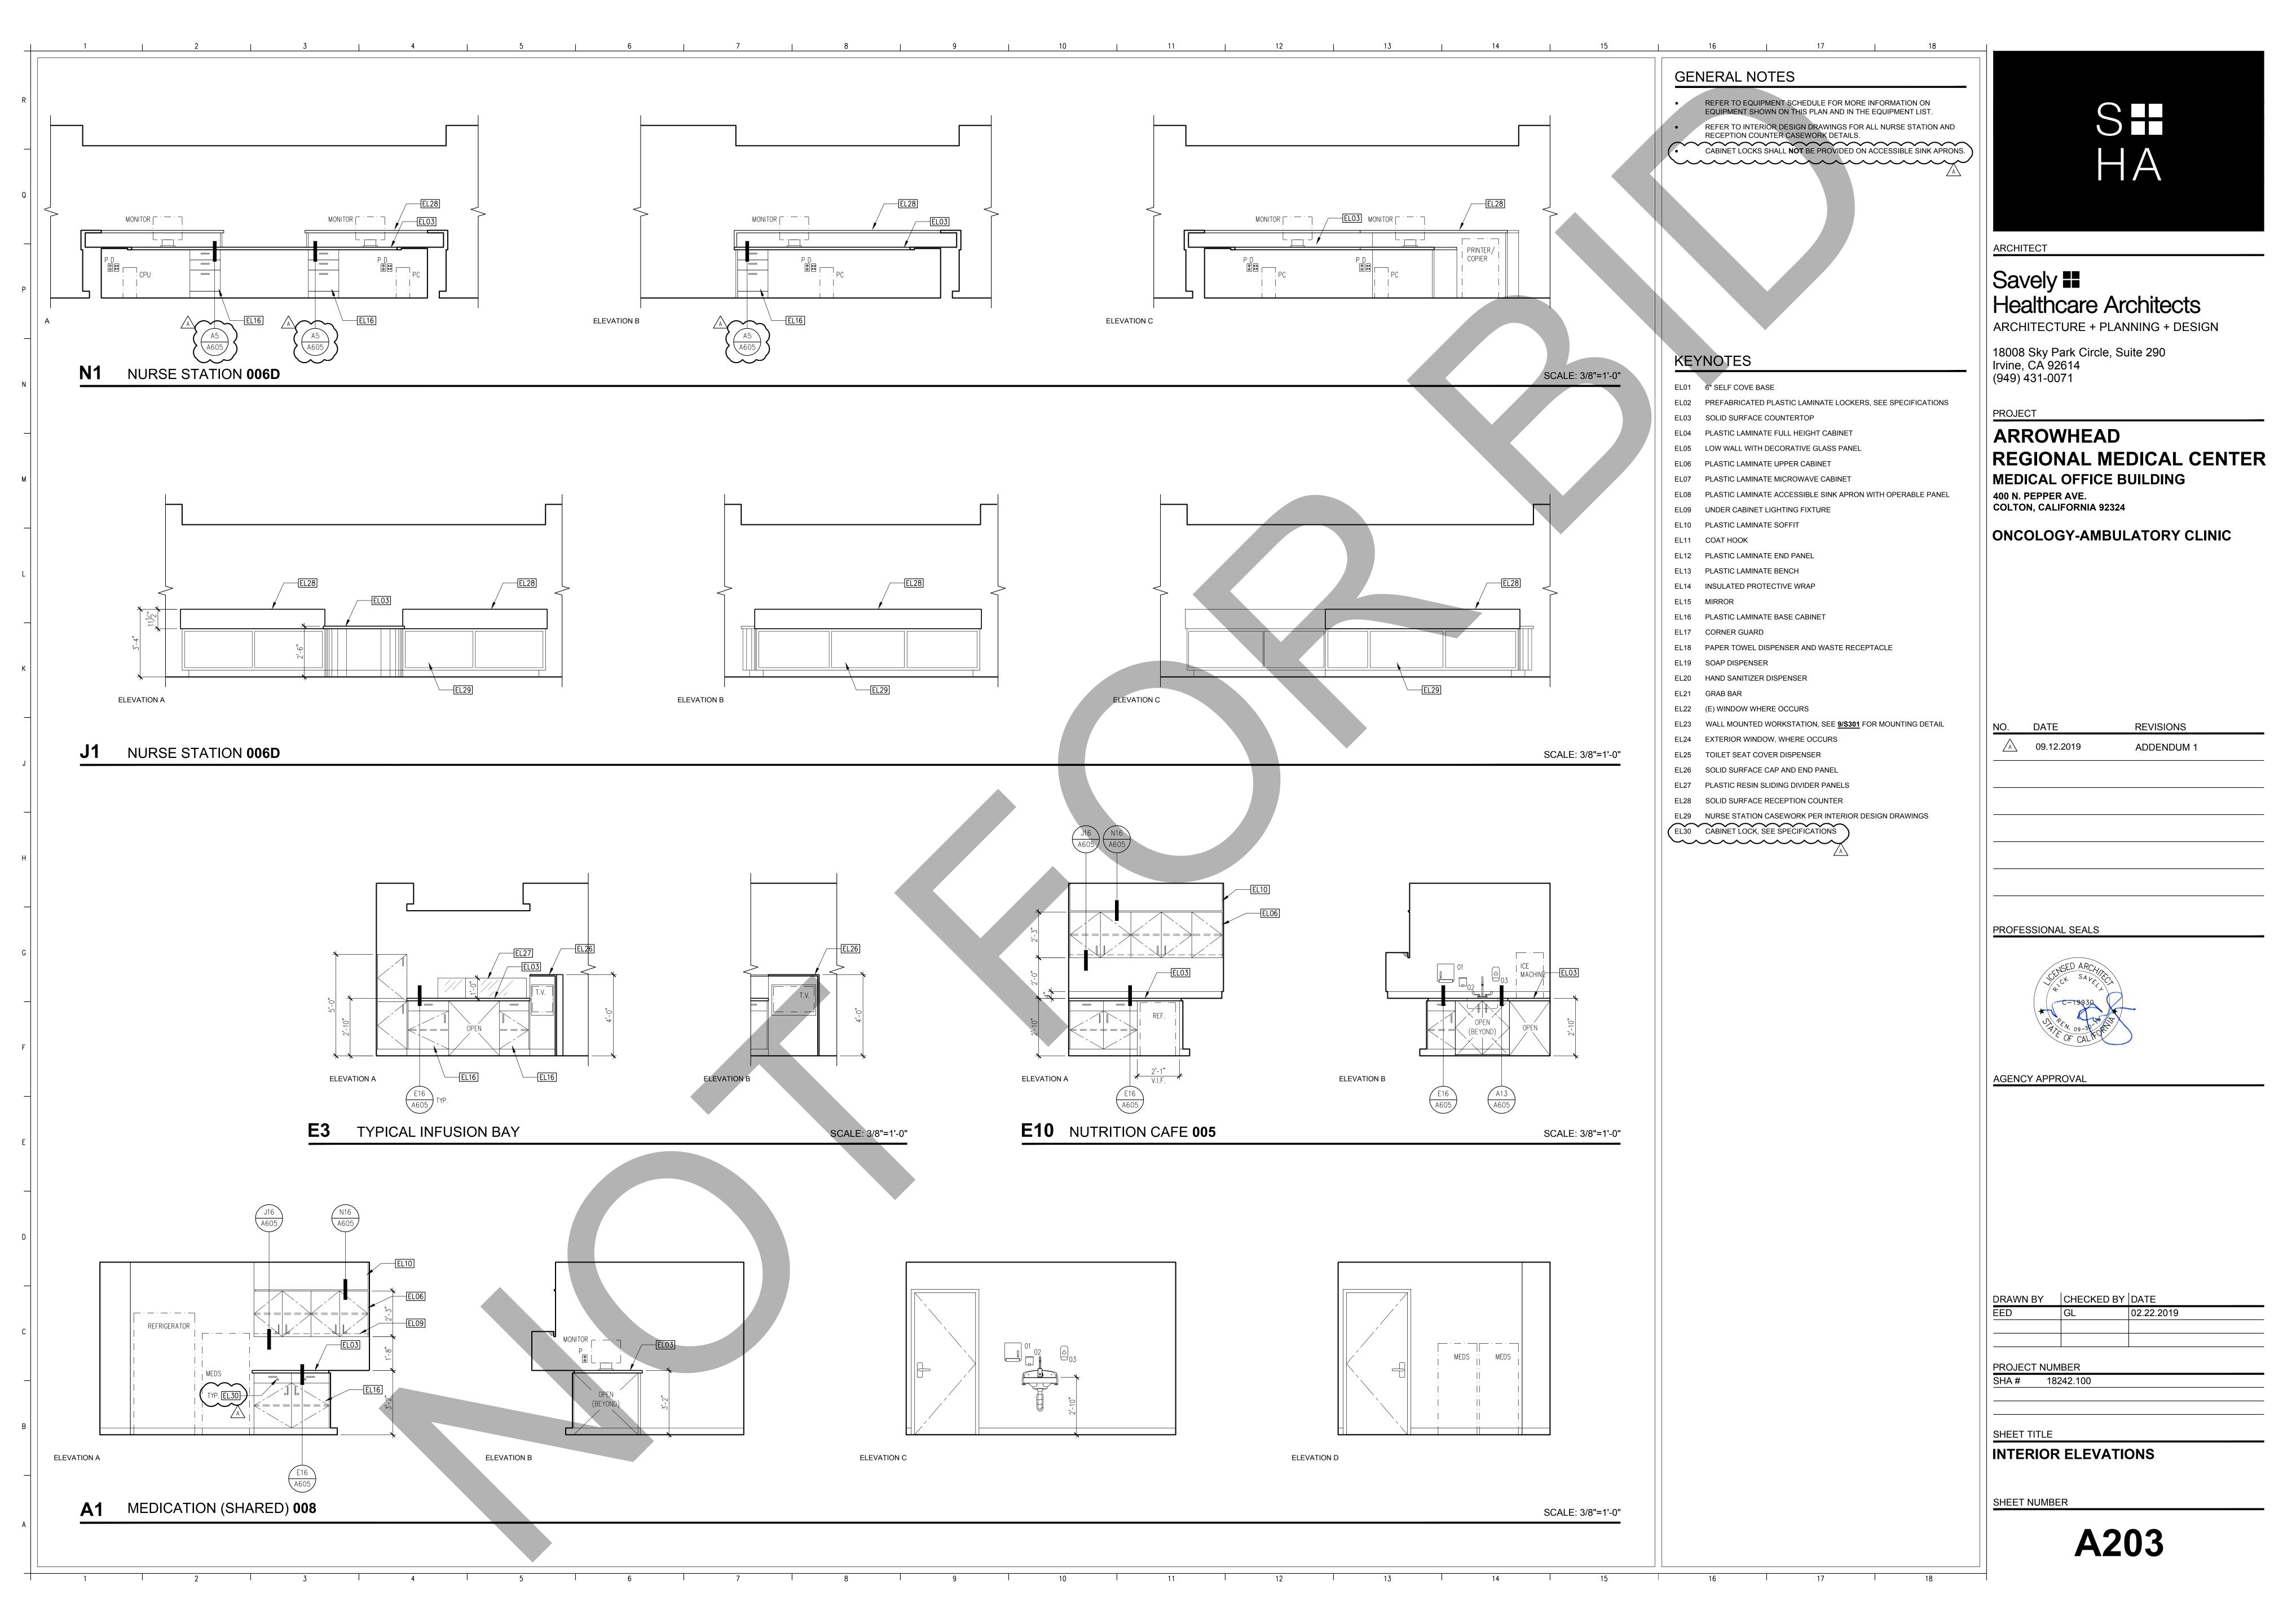

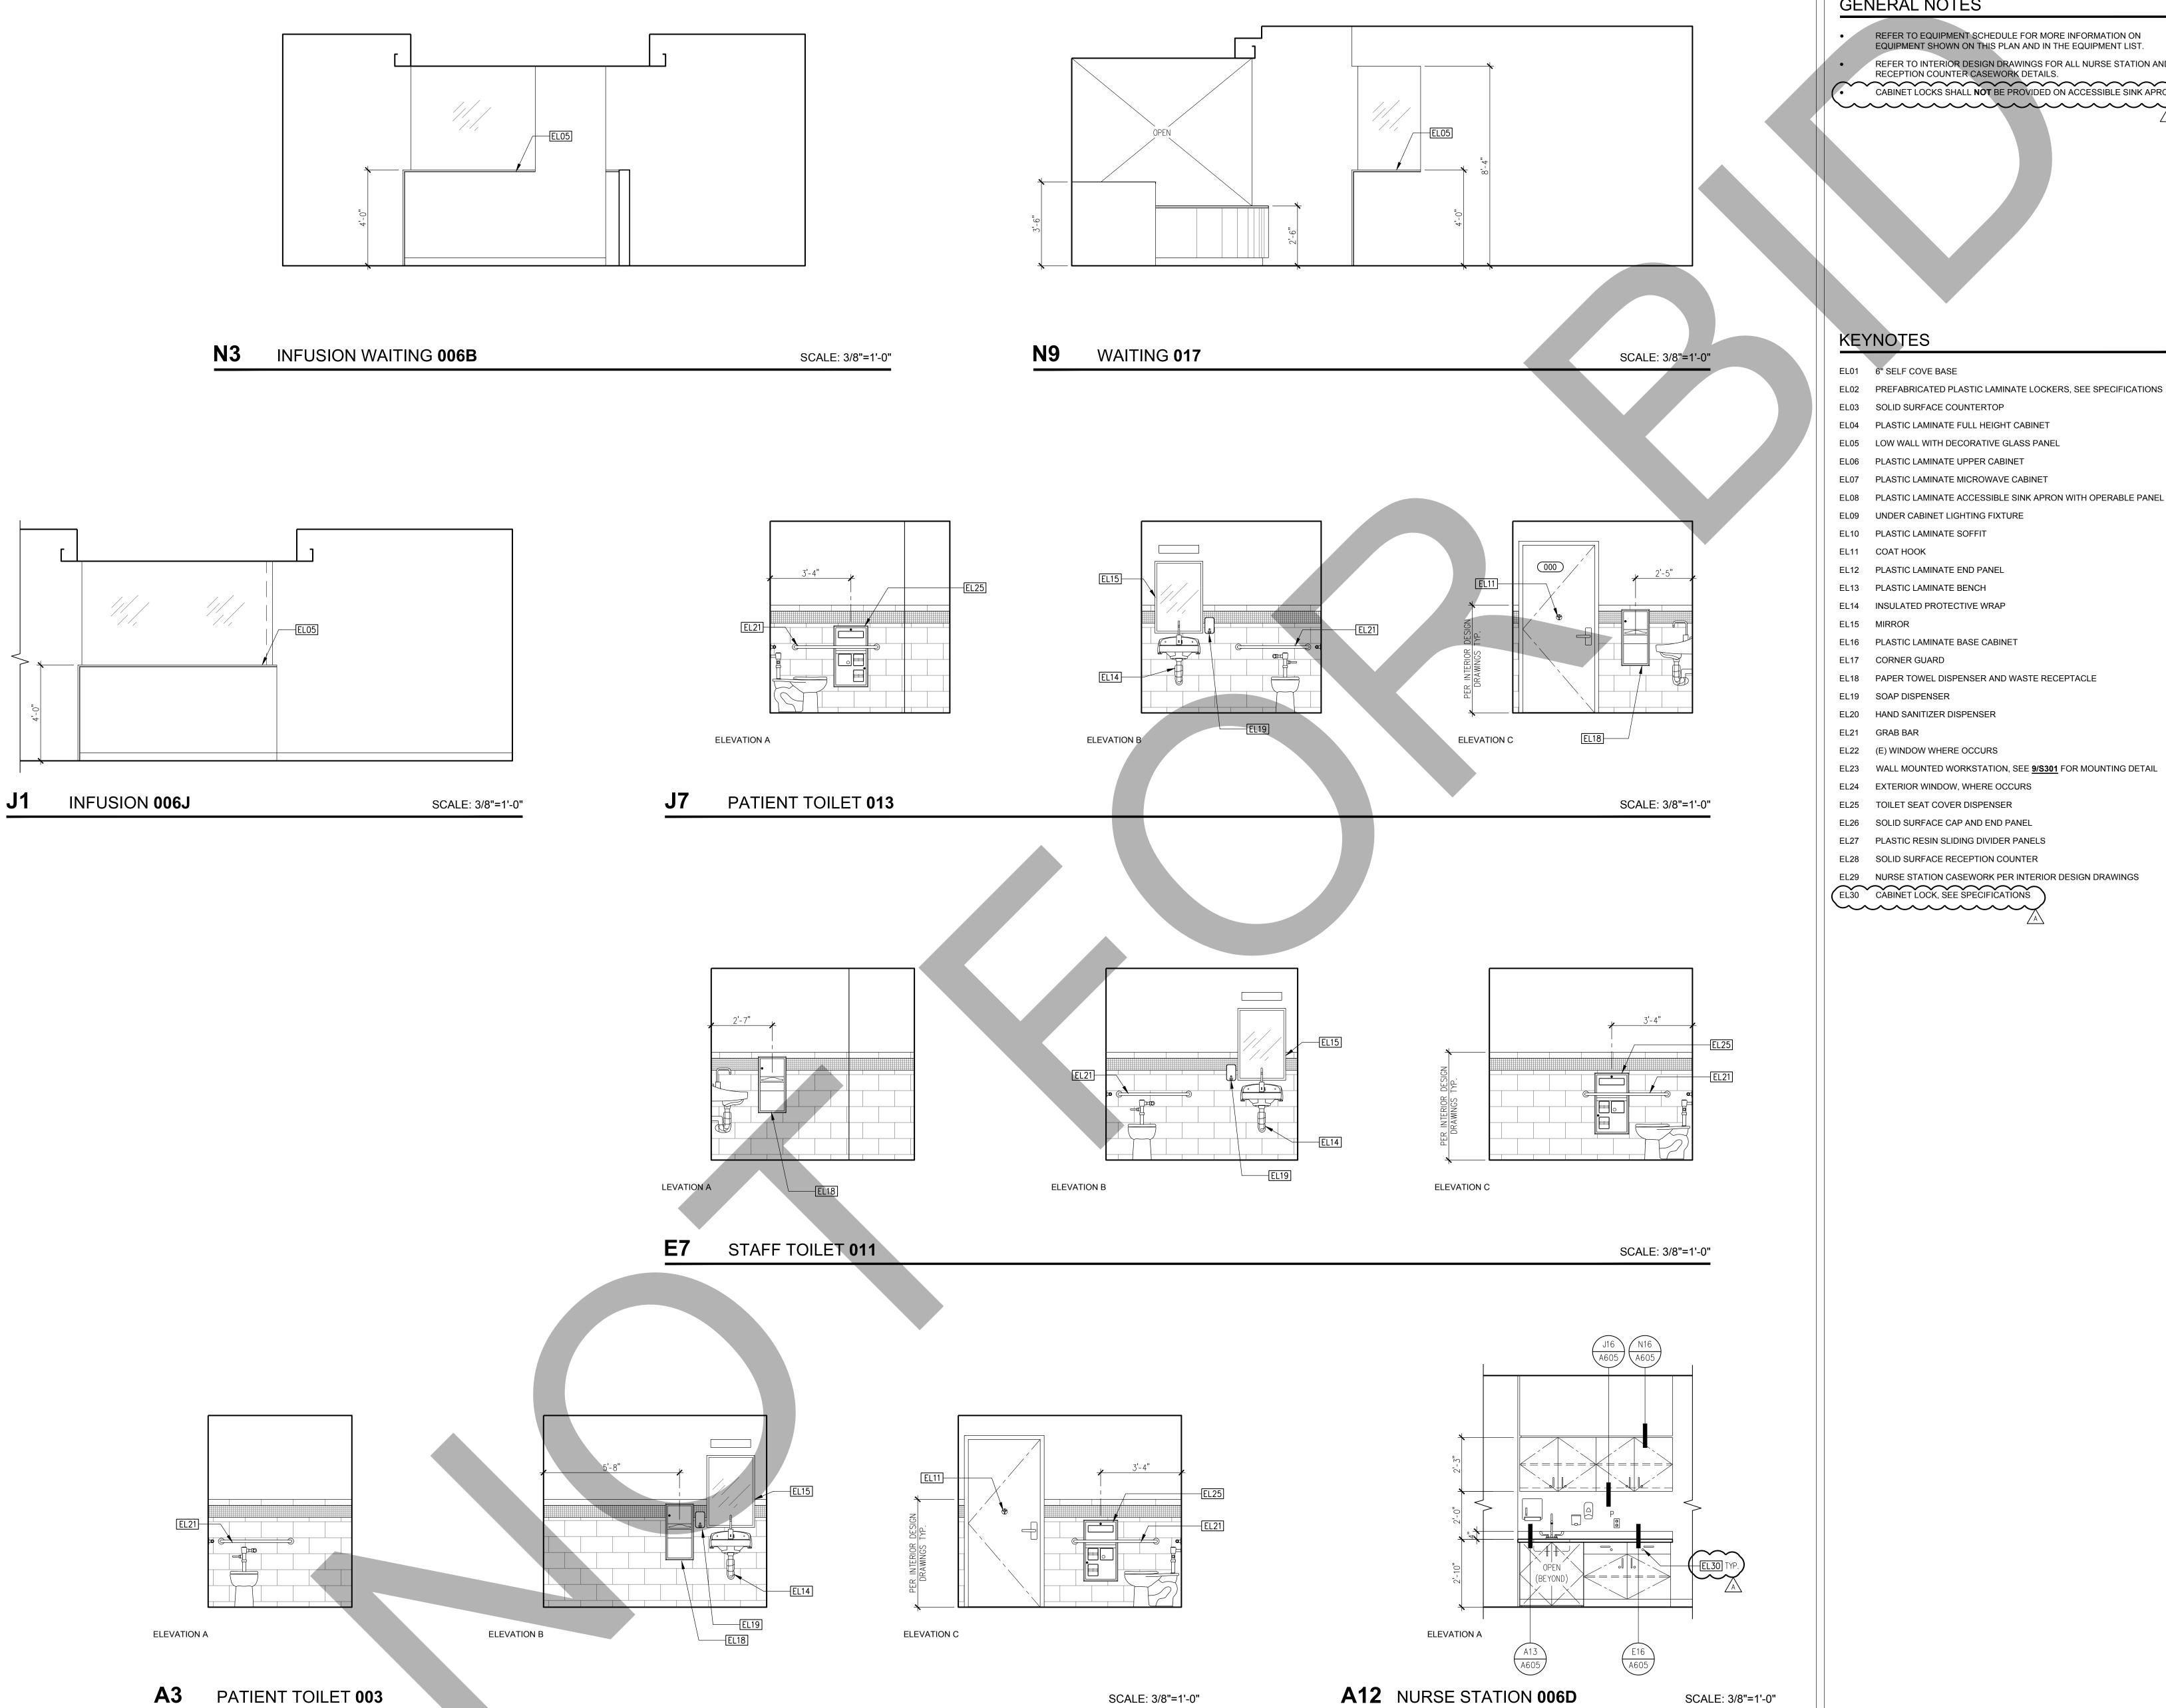

SCALE: 3/8"=1'-0"

GENERAL NOTES

SCALE: 3/8"=1'-0"

REFER TO EQUIPMENT SCHEDULE FOR MORE INFORMATION ON EQUIPMENT SHOWN ON THIS PLAN AND IN THE EQUIPMENT LIST. REFER TO INTERIOR DESIGN DRAWINGS FOR ALL NURSE STATION AND RECEPTION COUNTER CASEWORK DETAILS.

 CABINET LOCKS SHALL **NOT** BE PROVIDED ON ACCESSIBLE SINK APRONS.



ARCHITECT

Savely ## Healthcare Architects

ARCHITECTURE + PLANNING + DESIGN

18008 Sky Park Circle, Suite 290 Irvine, CA 92614 (949) 431-0071

PROJECT

ARROWHEAD

REGIONAL MEDICAL CENTER MEDICAL OFFICE BUILDING

400 N. PEPPER AVE. COLTON, CALIFORNIA 92324

ONCOLOGY-AMBULATORY CLINIC

NO.	DATE	REVISIONS
Â	09.12.2019	ADDENDUM 1

PROFESSIONAL SEALS



AGENCY APPROVAL


DRAWN BY	CHECKED BY	DATE
EED	GL	02.22.2019


PROJECT NUMBER
SHA # 18242.100

SHEET TITLE

SHEET NUMBER

INTERIOR ELEVATIONS

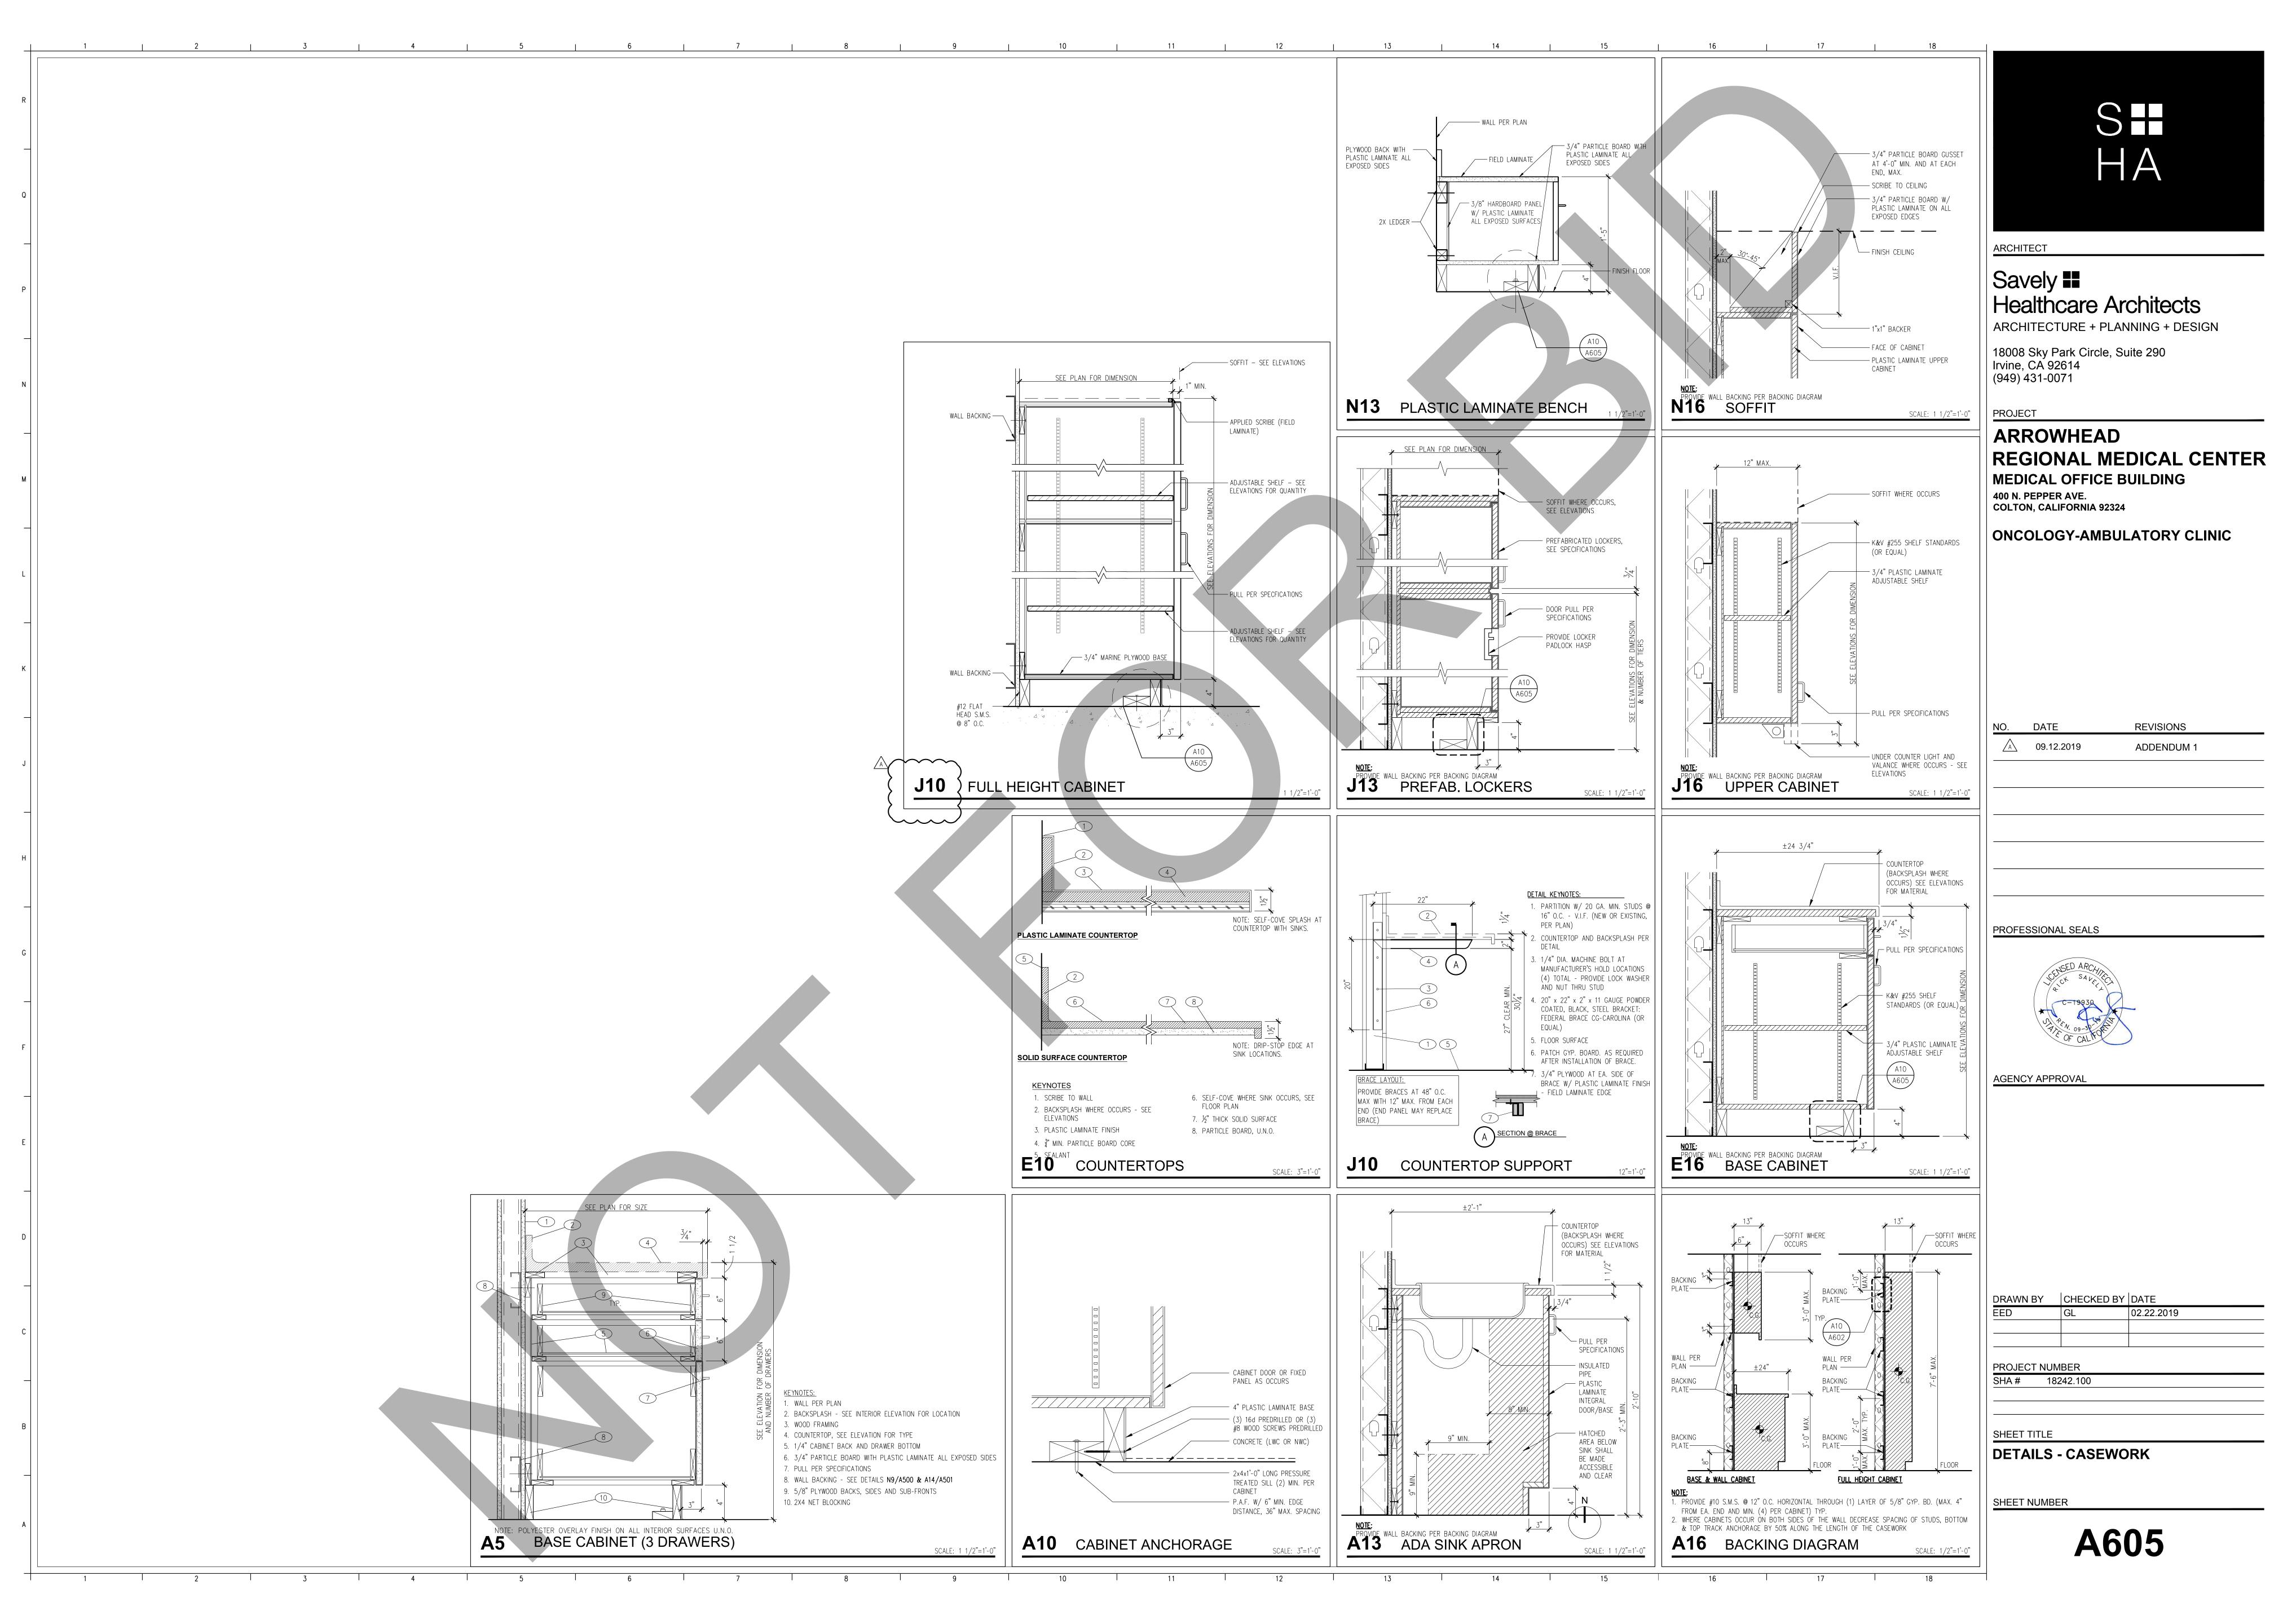

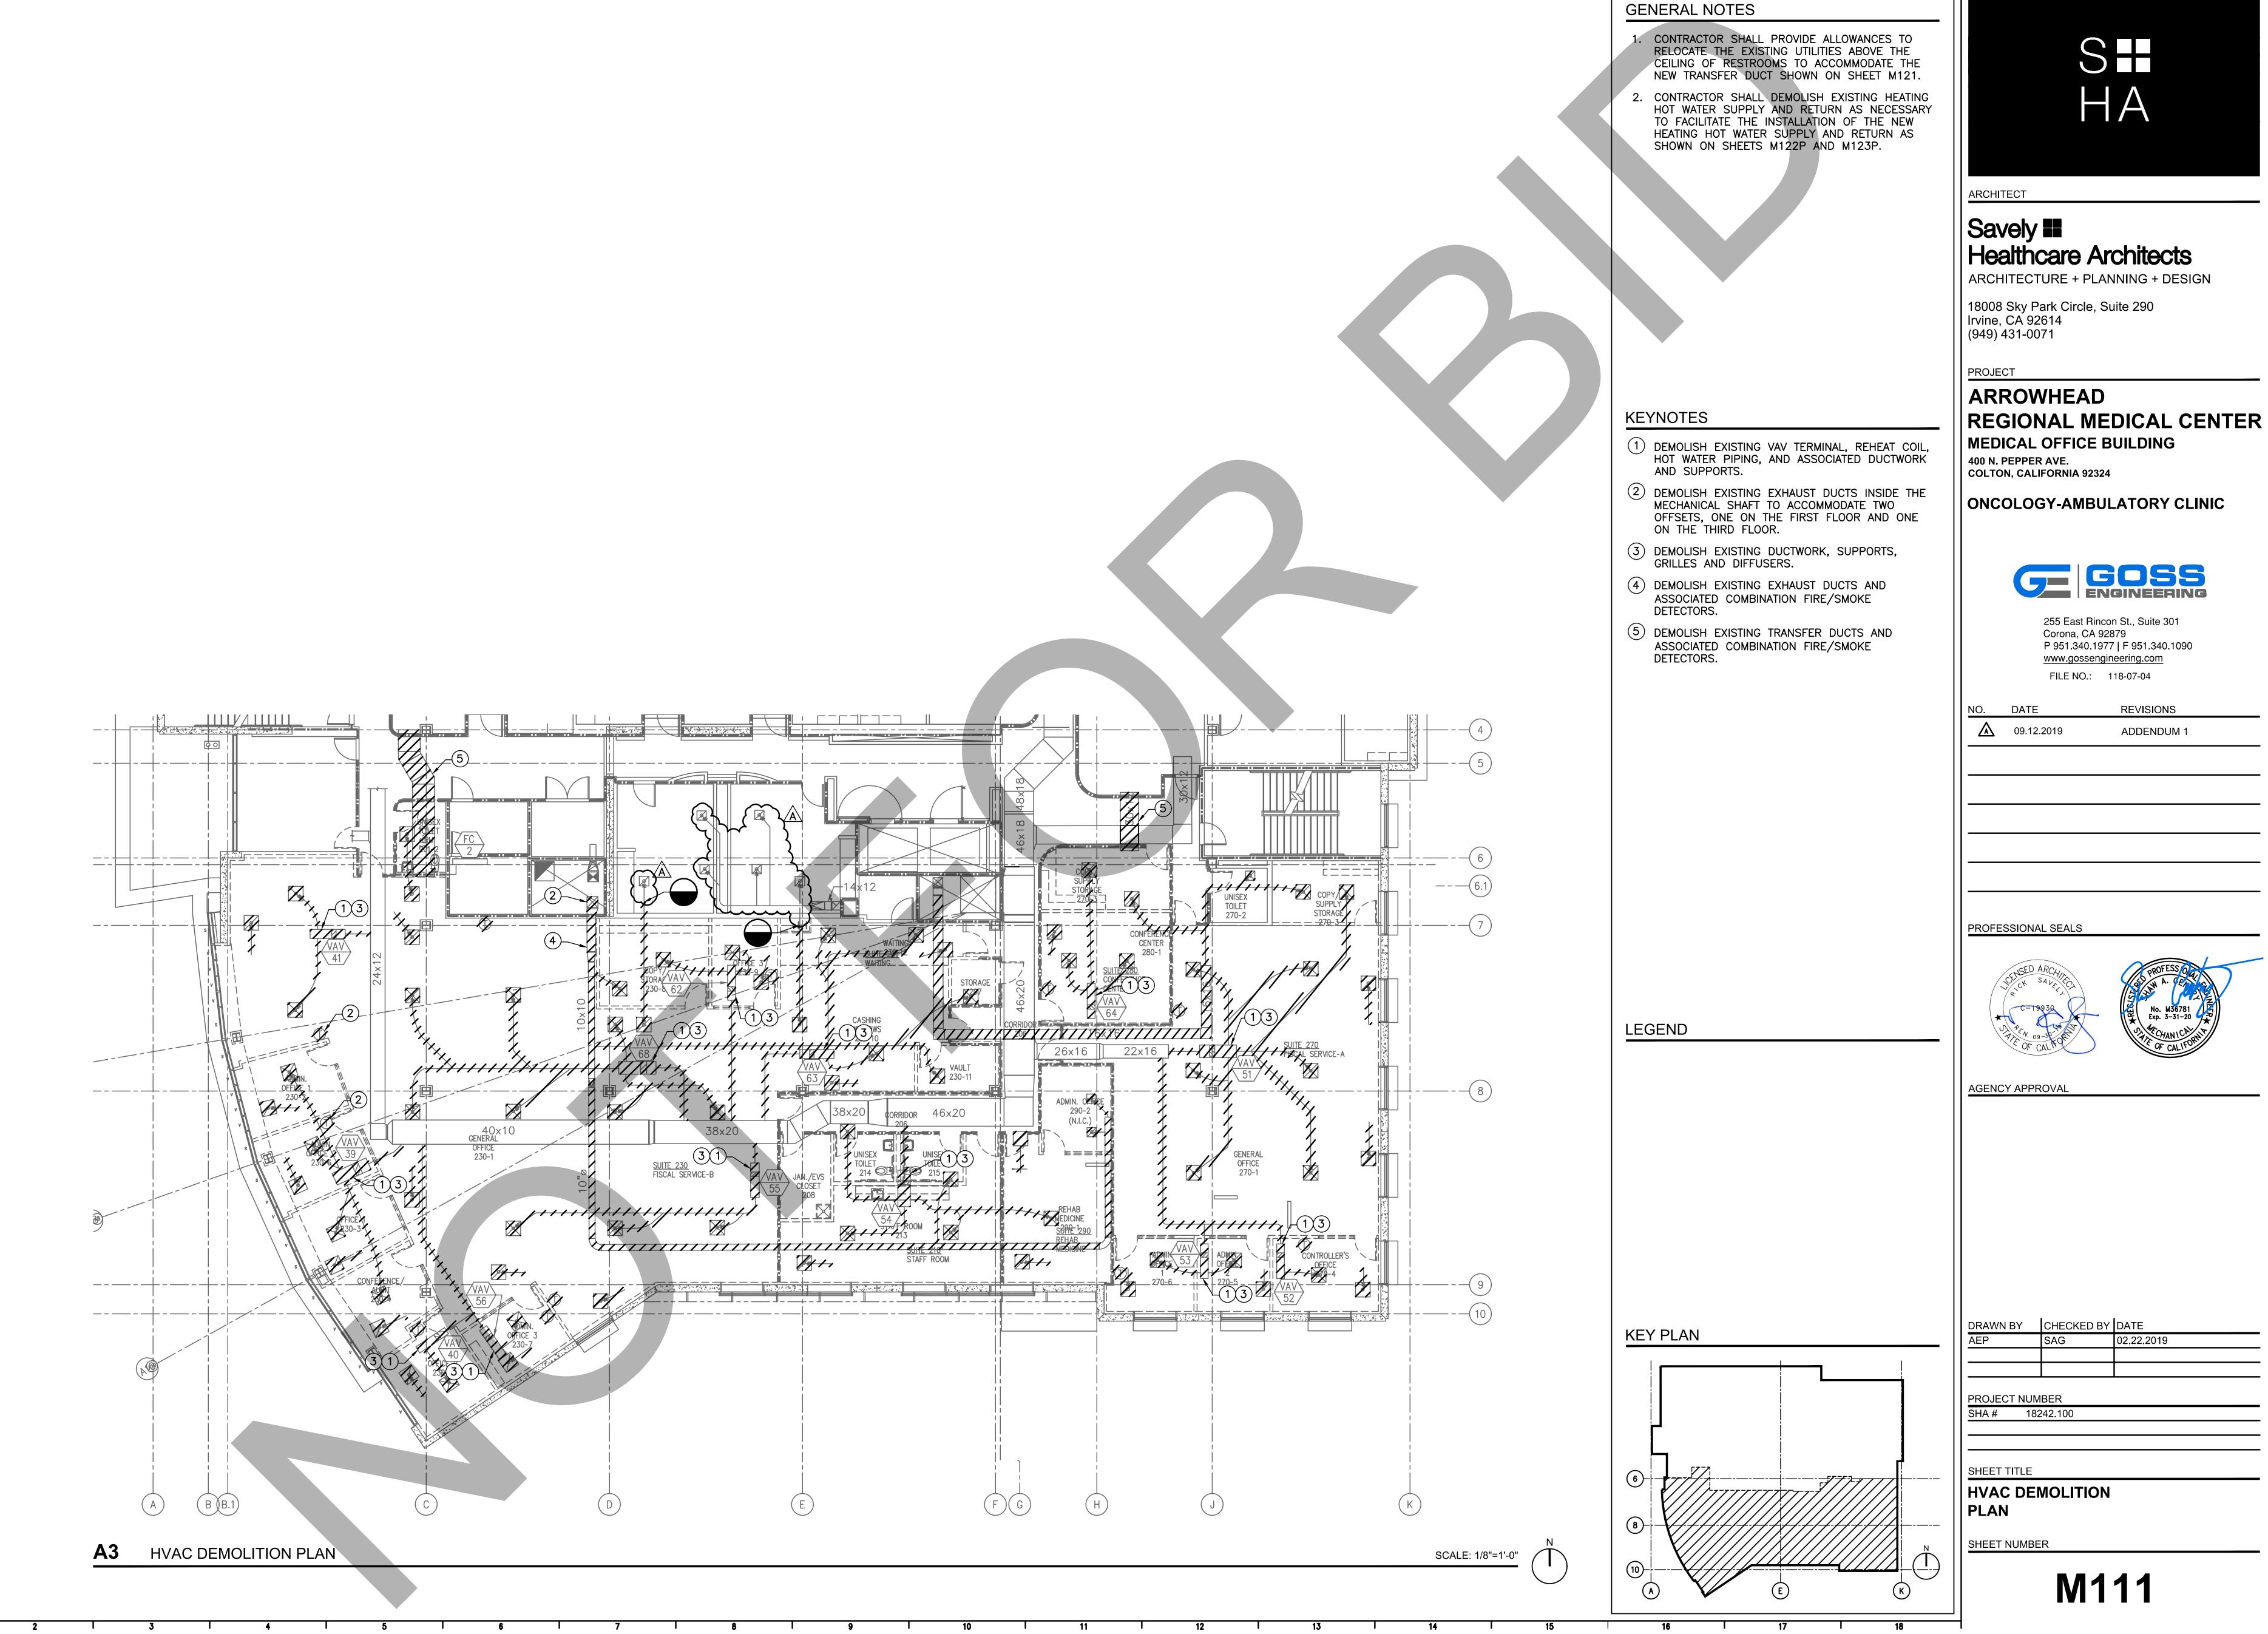








P 951.340.1977 | F 951.340.1090

ADDENDUM 1



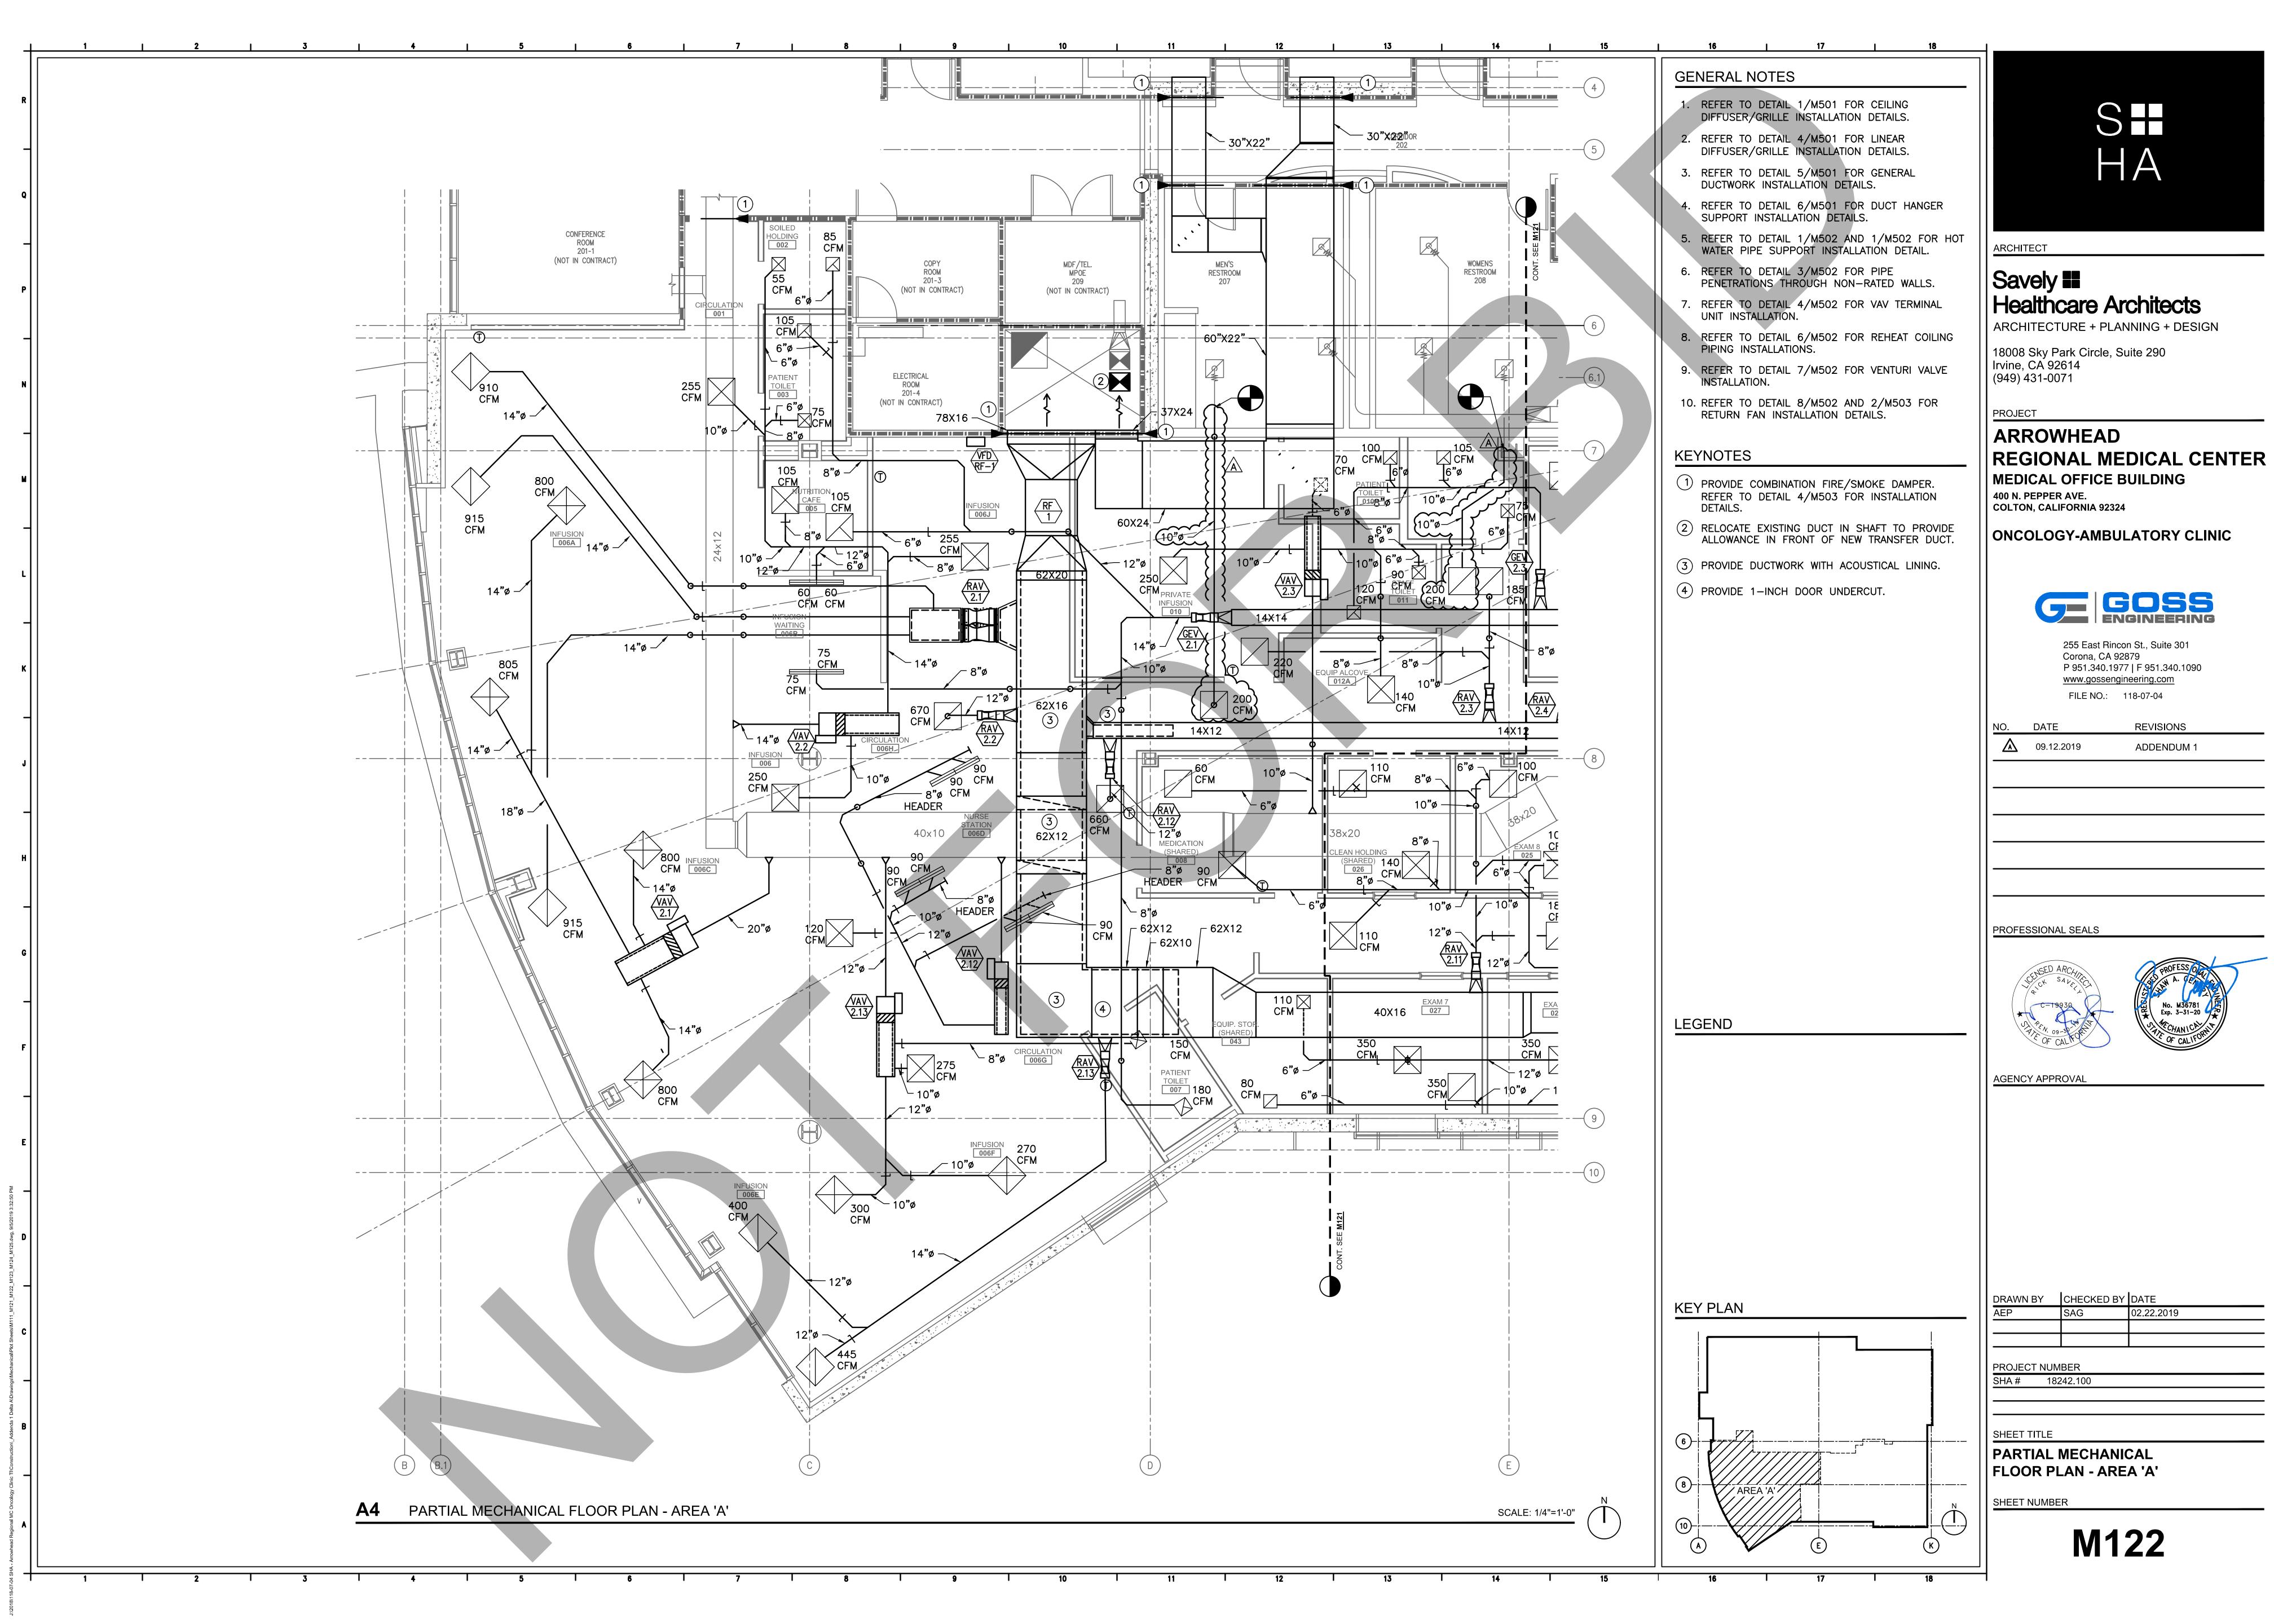

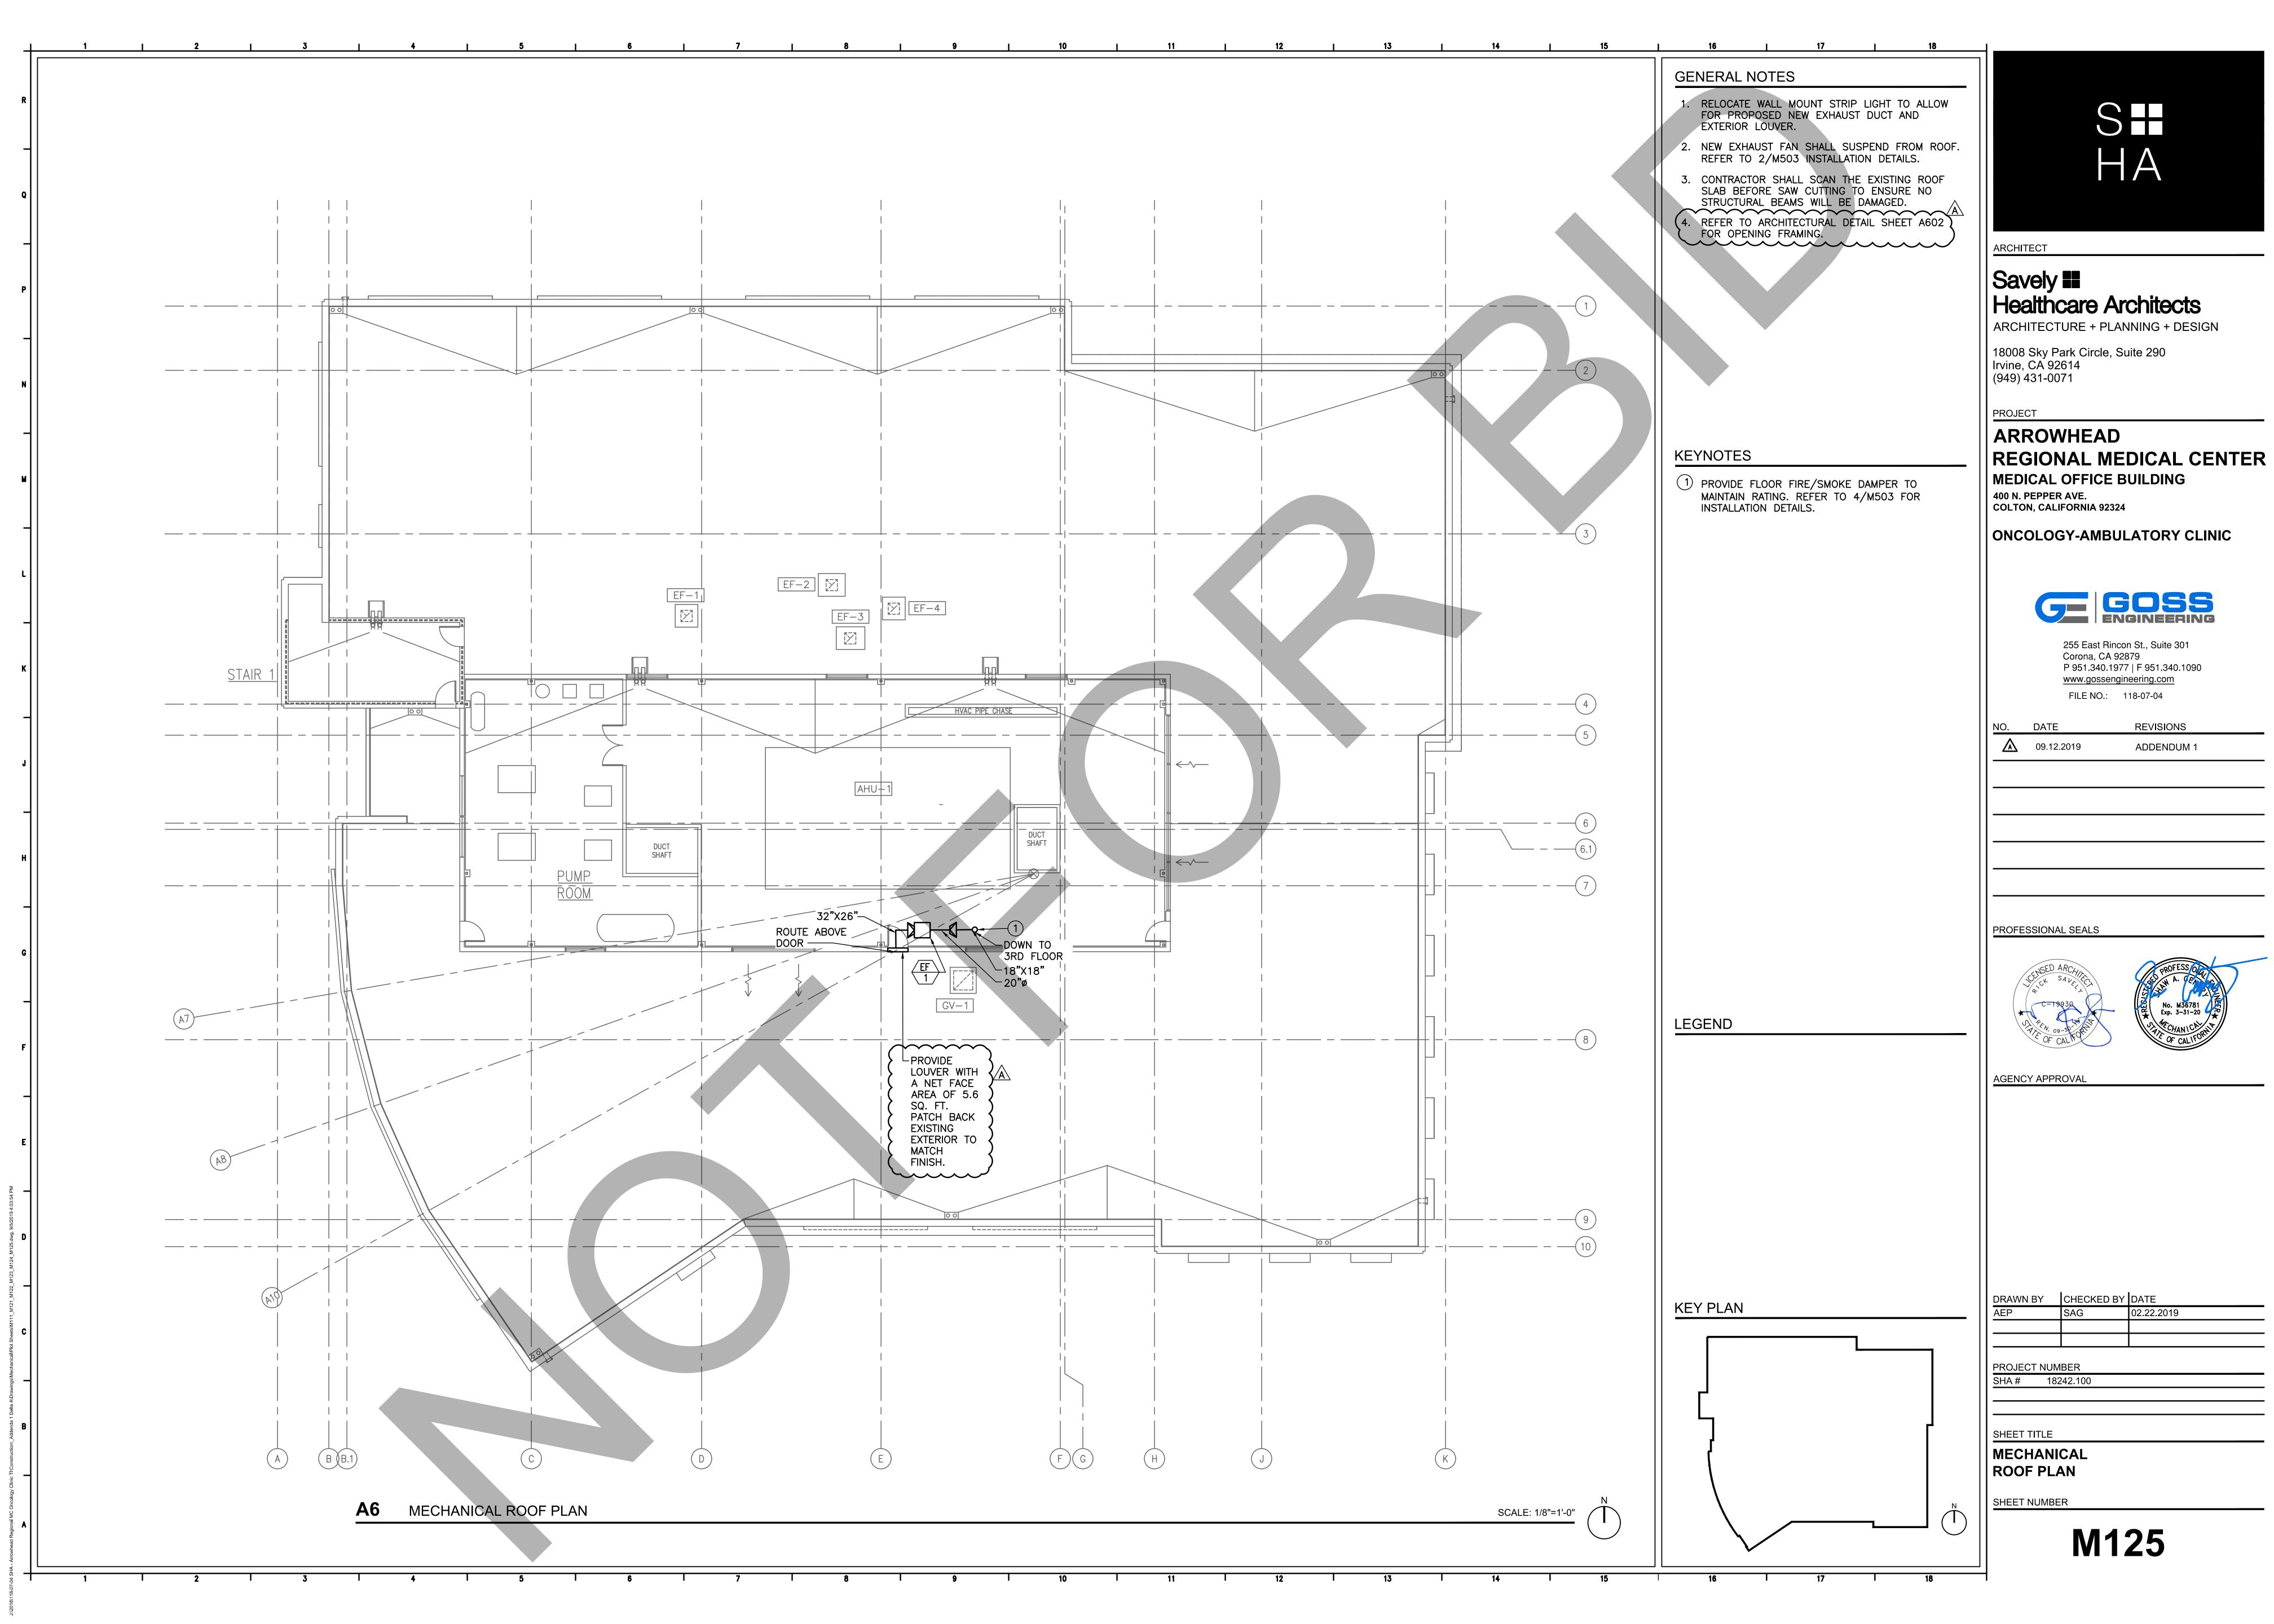


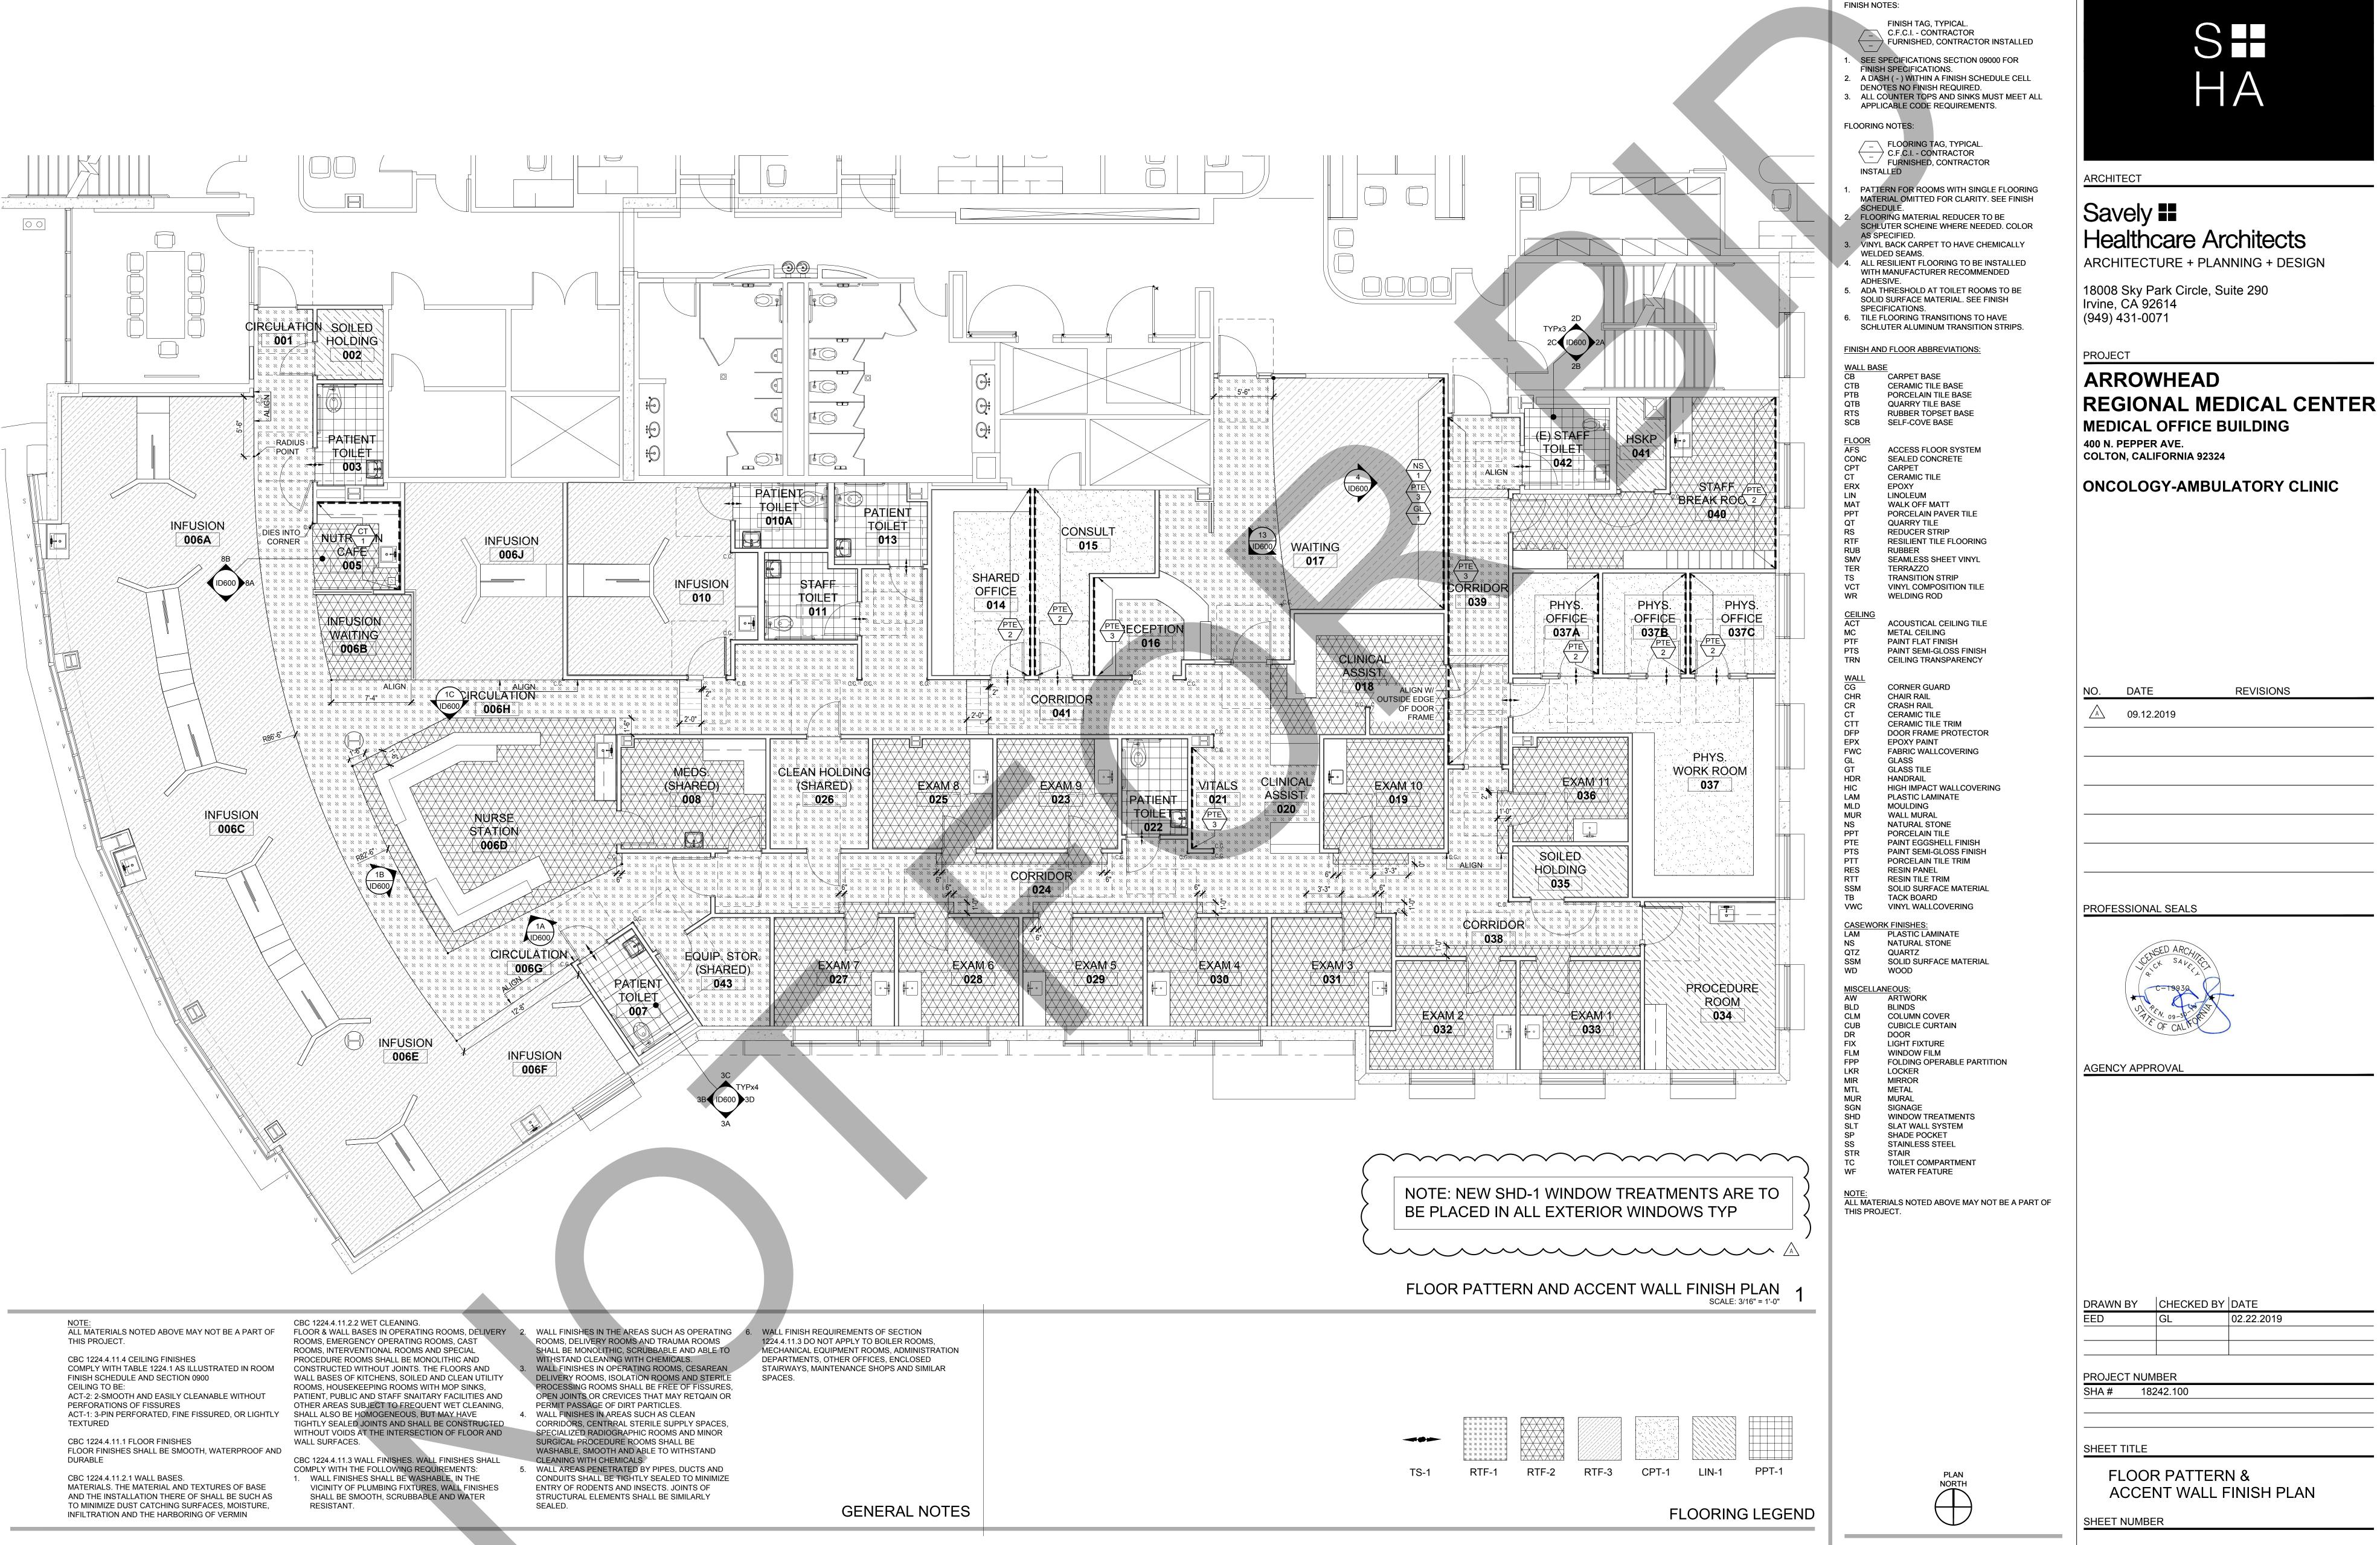



LEGEND & ABBREVIATIONS

ID300

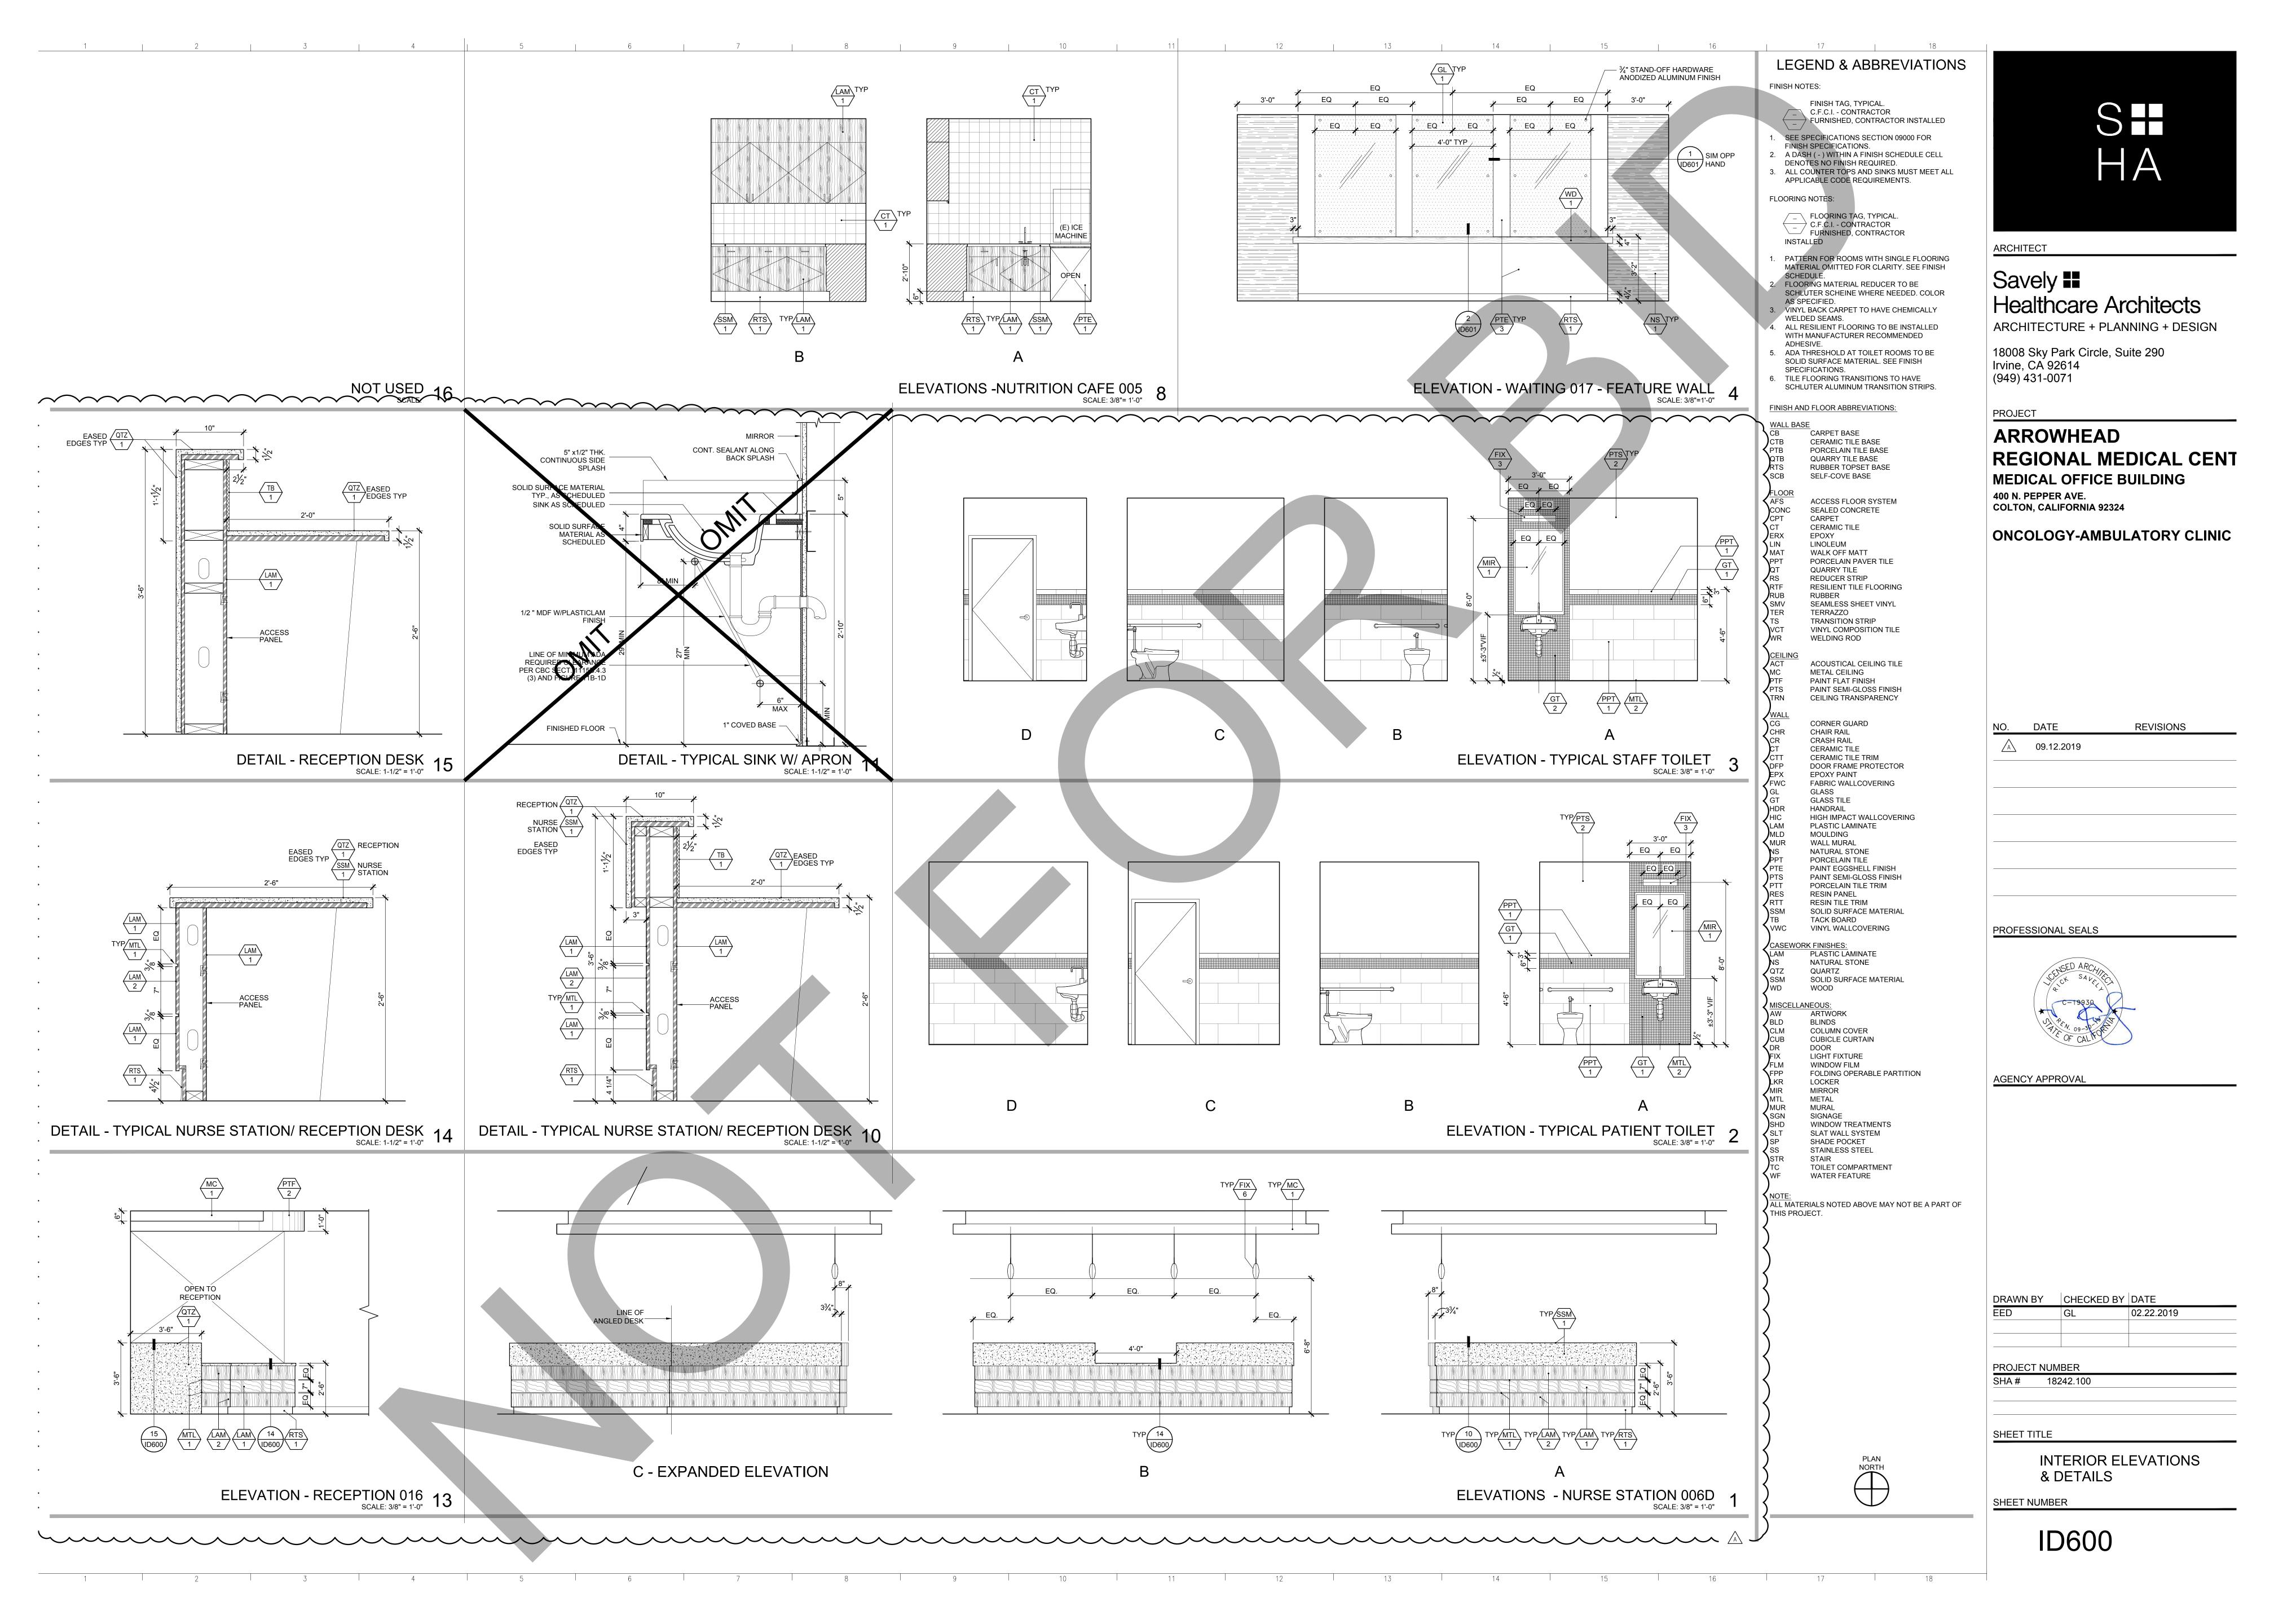

	l				ı				l				ı		INTERIOR ROOM FINISH SCHEDULE
			FLOOR			WALI	_S		WAIN	NSCOT	CEII	LING	CASEWO	PRK	
ROOM # ROOM NA	AME F	FIELD	ACCENT	BASE	N	E	S	W	HEIGHT	FINISH	SOFFIT	CEILING	COUNTER TOP	FACE OF CABINET	- NOTES
001 CIRCULATION	RT	ΓF-1	-	RTS-1	PTE-1	PTE-1	PTE-1	PTE-1	36"	HIC-1	PTF-2	-	-	-	FIX-1, CHR-1. CG-1
002 SOILED UTILITY		N-1	-	SCB-1	PTS-1	PTS-1	PTS-1	PTS-1	54"	HIC-3	-	PTS-3	A	_	
003 PATIENT TOILET		PT-2	-	PPT-1	PTS-2	PTS-2	PTS-2	PTS-2	54"	PPT-1	-	PTS-3	SSM-1	-	FIX-3, FIX-4, MTL-2, MIR-1, GT-1 (LAM-3 @ SINK APRON 7)
005 NUTRITION CAFE		TF-2	-	RTS-1	CT-1	CT-1	PTE-1	PTE-1	-	-	- ACT 2 DTF 2	-		LAM-1	FIX-1, C1-1 @ BACK SPLASH, GL-1
006A INFUSION 006B INFUSION WAITING		ΓF-3 ΓF-2	-	RTS-1	PTE-1	PTE-1	PTE-1	PTE-1	36"	HIC-1, 2	ACT-2, PTF-2	-	SSM-1	LAM-1	FIX-7, SSM-1 @ LOW WALL CAP, SHD-1, CUB-1, CHR-1, RES-1, DOWNLIGHTS PER ARCHITECTURAL SPECS.
006B INFUSION WAITING 006C INFUSION		TF-3	-	RTS-1	PTE-1	PTE-1	PTE-1 PTE-1	PTE-1	36"	HIC-1, 2	MC-1 ACT-2, PTF-2	-	- SSM 1 A	- \ \ \ \ \ \ \ \ \ \ \ \ \ \ \ \ \ \ \	FIX-7, GL-1, SSM-1 @ LOW WALL CAP FIX-7, SSM-1 @ LOW WALL CAP, SHD-1, CUB-1, CHR-1, RES-1, DOWNLIGHTS PER ARCHITECTURAL SPECS.
006D NURSE STATION		ΓF-2	-	RTS-1	PTE-1	PTE-1	PTE-1	PTE-1	36"	HIC-1	MC-1	_	SSM-1 A	LAM-1, 2	FIX-5, FIX-6, FIX-7, TB-1, MTL-1
006E INFUSION		TF-3	-	RTS-1	PTE-1	PTE-1	PTE-1	PTE-1	36"	HIC-1, 2	ACT-2, PTF-2	-	SSM-1	LAM-1	FIX-7, SSM-1 @ LOW WALL CAP, SHD-1, CUB-1, CHR-1, RES-1, DOWNLIGHTS PER ARCHITECTURAL SPECS.
006F INFUSION		ΓF-3	-	RTS-1	PTE-1	PTE-1	PTE-1	PTE-1	36"	HIC-1, 2	ACT-2, PTF-2	-	SSM-1	LAM-1	FIX-7, SSM-1 @ LOW WALL CAP, SHD-1, CUB-1, CHR-1, RES-1, DOWNLIGHTS PER ARCHITECTURAL SPECS.
006G CIRCULATION		 ΓF-1	-	RTS-1	PTE-1	PTE-1	PTE-1	PTE-1	36"	HIC-1	PTF-2, MC-1	-	-	-	FIX-1, CG-1
006H CIRCULATION	RT	ΓF-1	-	RTS-1	PTE-1	PTE-1	PTE-1	PTE-1	36"	HIC-1	PTF-2. MC-1	-	-	-	FIX-1, CG-1
006J INFUSION	RT	TF-3	-	RTS-1	PTE-1	PTE-1	PTE-1	PTE-1	36"	HIC-1, 2	ACT-2	-	SSM-1	LAM-1	FIX-7, SSM-1 @ LOW WALL CAP, CUB-1, CHR-1, RES-1 DOWNLIGHTS PER ARCHITECTURAL SPECS.
007 PATIENT TOILET	PP	PT-2	-	PPT-1	PTS-2	PTS-2	PTS-2	PTS-2	54"	PPT-1	-	PTS-3	(-SSM-1- /)	_	FIX-3, FIX-4, MTL-2, MIR-1, GT-1, HAM-3-
008 MEDS (SHARED)	RT	ΓF-2	-	RTS-1	PTE-1	PTE-1	PTE-1	PTE-1	-	-	-	-	SSM-1	LAM-1	FIX-1
	1														
010 INFUSION		ΓF-3	-	RTS-1	PTE-1	PTE-1	PTE-1	PTE-1	36"	HIC-1, 2	PTF-1	-	SSM-1 A	LAM-1	FIX-1, CHR-1, CG-1, CUB-1, RES-1_DOWNLIGHTS PER ARCHITECTURAL SPECS.
010A PATIENT TOILET		PT-2	-	PPT-1	PTS-2	PTS-2	PTS-2	PTS-2	54"	PPT-1	-	PTS-3	SSM-1	-	FIX-3, FIX-4, MTL-2, MIR-1, GT-1 LAM-3 @ SINK APRON A
011 STAFF TOILET		PT-2	-	PPT-1	PTS-2	PTS-2	PTS-2	PTS-2	54"	PPT-1	-	PTS-3	SSM-1	-	FIX-3, FIX-4, MTL-2, MIR-1, GT-1 LAM-3 @ SINK APRON
013 PATIENT TOILET		PT-2	-	PPT-1	PTS-2	PTS-2	PTS-2	PTS-2	54"	PPT-1	-	PTS-3	-SSM-1	-	FIX-3, FIX-4, MTL-2, MIR-1, GT-1 LAM-3 @ SINK APRON
014 SHARED OFFICE		PT-1	-	RTS-2	PTE-1	PTE-2	PTE-1	PTE-1	-	-	PTF-1	-	SSM-1	LAM-1	FIX-1, FIX-5, 1B-1
015 CONSULT		PT-1	-	RTS-2	PTE-1	PTE-1	PTE-1	PTE-2	-	-	- MC 4 DTF 2	-	- OT7 1	-	FIX-1
016 RECEPTION 017 WAITING		ΓF-1 ΓF-3	- RTF-1	RTS-1	PTE-1	PTE-1 PTE-3, NS-1 GL-1	PTE-1	PTE-3	-	-	MC-1, PTF-2 PTF-1, MC-1	-	QTZ-1	LAM-1, 2	FIX-7, FIX-2, TB-1, MTL-1 FIX-2. FIX-7, RES-1, WD-1
0018 CLINICAL ASSIST		тг-э TF-2	-	RTS-1	PTE-1	PTE-3, NS-1 GL-1	PTE-1	PTE-1	-	-	PTF-1, MC-1	-	- QTZ-1	 LAM-1	FIX-1, FIX-5, FIX-6, TB-1, MTL-1, CG-1
0019 EXAM 10		ΓF-2	-	RTS-1	PTE-1	PTE-1	PTE-1	PTE-1	36"	HIC-1	-	-	SSM-1	LAM-1	FIX-1, SHD-1, CHR-1
020 CLINICAL ASSIST		<u>–</u> ГF-1	_	RTS-1	PTE-1	PTE-1	PTE-1	PTE-1	-	-	-	-	QTZ-1	LAM-1	FIX-1, FIX-5, FIX-6, TB-1, MTL-1
021 VITALS		 ΓF-1	-	RTS-1	PTE-1	PTE-1	PTE-1	PTE-3	-	-	-	-		-	FIX 1 CC 1
022 PATIENT TOILET	PP	PT-2	-	PPT-1	PTS-2	PTS-2	PTS-2	PTS-2	54"	PPT-1	-	PTS-3	SSM-1	_	FIX-3, FIX-4, MTL-2, MIR-1, GT-1, LAM-3 @ SINK APRON
023 EXAM 9	RT	TF-2	-	RTS-1	PTE-1	PTE-1	PTE-1	PTE-1	36"	HIC-1	-	-	SSM-1	LAM-1	FIX-1, CHR-1
024 CORRIDOR	RT	ΓF-1	RTF-2	RTS-1	PTE-1	PTE-1	PTE-1	PTE-1	36"	HIC-1	MC-1	-	-	-	FIX-1, CHR-1, CG-1
025 EXAM 8	RT	TF-2	-	RTS-1	PTE-1	PTE-1	PTE-1	PTE-1	36"	HIC-1	-	-	SSM-1	LAM-1	FIX-1, CHR-1
026 CLEAN UTILITY (SHARED	D) RT	ΓF-1	-	RTS-1	HIC-2	HIC-2	HIC-2	HIC-2	-	-	-	-	-	-	FIX-1
027 EXAM 7		TF-2	-	RTS-1	PTE-1	PTE-1	PTE-1	PTE-1	36"	HIC-1	-	-	SSM-1	LAM-1	FIX-1, CHR-1, SHD-1
028 EXAM 6		ΓF-2	-	RTS-1	PTE-1	PTE-1	PTE-1	PTE-1	36"	HIC-1	-	-	SSM-1	LAM-1	FIX-1, SHD-1, CHR-1
029 EXAM 5		ΓF-2	-	RTS-1	PTE-1	PTE-1	PTE-1	PTE-1	36"	HIC-1	-	-	SSM-1	LAM-1	FIX-1, CHR-1, SHD-1
030 EXAM 4		TF-2	-	RTS-1	PTE-1	PTE-1	PTE-1	PTE-1	36"	HIC-1	-	-	SSM-1	LAM-1	FIX-1, SHD-1, CHR-1
031 EXAM 3 032 EXAM 2		ΓF-2 ΓF-2	-	RTS-1	PTE-1	PTE-1	PTE-1	PTE-1	36" 36"	HIC-1	-	-	SSM-1 SSM-1	LAM-1 LAM-1	FIX-1, SHD-1, CHR-1 FIX-1, CHR-1, SHD-1
032 EXAM 2 033 EXAM 1		TF-2	-	RTS-1	PTE-1	PTE-1	PTE-1	PTE-1	36"	HIC-1	-	-	SSM-1	LAM-1	FIX-1, CHR-1, SHD-1 FIX-1, SHD-1, CHR-1
034 PROCEDURE ROOM		N-1	_	RTS-1	PTE-1	PTE-1	PTE-1	PTE-1	36"	HIC-1	_	PTS-3	SSM-1	LAM-1	FIX-1, SHD-1, CHR-1
035 SOILED UTILITY		N-1	-	SCB-1	PTS-1	PTS-1	PTS-1	PTS-1	54"	HIC-3	-	PTS-3	-	-	FIX-1
036 EXAM 11		ΤF-2	-	RTS-1	PTE-1	PTE-1	PTE-1	PTE-1	36"	HIC-1	-	-	SSM-1	LAM-1	FIX-1, CHR-1
037 PHYS WORK ROOM		PT-1	-	RTS-2	PTE-1	PTE-1	PTE-1	PTE-1	-	-	-	-	SSM-1	LAM-1	FIX-1, FIX-5, TB-1, SHD-1
037A PHYS OFFICE	CP	PT-1	-	RTS-2	PTE-1	PTE-2	PTE-1	PTE-1	-	-	-	-	-	-	FIX-1
037B PHYS OFFICE	CP	PT-1	-	RTS-2	PTE-1	PTE-2	PTE-1	PTE-1	-	-	-	-	-	-	FIX-1
037C PHYS OFFICE	CP	PT-1	-	RTS-2	PTE-1	PTE-1	PTE-1	PTE-2	-	-	-	-	-	_	FIX-1, SHD-1
038 CORRIDOR	RT	ΓF-1	RTF-2	RTS-1	PTE-1	PTE-1	PTE-1	PTE-1	36"	HIC-1	-	-	-	-	FIX-1, CHR-1, CG-1
039 CORRIDOR	RT	ΓF-1	RTF-3	RTS-1	PTE-1	PTE-1	PTE-1	PTE-3	-	-	-	-	-	-	FIX-1
040 STAFF BREAK ROOM		TF-2	-	RTS-1	PTE-1	PTE-2	PTE-1	PTE-1	-	-	-	-	SSM-1	LAM-1	FIX-1, SHD-1, LKR-1
041 HSKP		N-1	-	SCB-1	PTS-1	PTS-1	PTS-1	PTS-1	54"	HIC-3	-	PTS-3	-	-	PROVIDE MOP RACK
041 CORRIDOR		ΓF-1	RTF-2	RTS-1	PTE-1	PTE-1	PTE-1	PTE-1	36"	HIC-1	MC-1	-	A\	-	FIX-1, CHR-1, CG-1
042 (E) STAFF TOILET		PT-2	-	PPT-1	PTS-2	PTS-2	PTS-2	PTS-2	54"	PPT-1	-	PTS-3	SSM-1	-	FIX-3, FIX-4, MTL-2, MIR-1, GT-1, LAM-3 @ SINK APRON
043 EQUIP. STOR (SHARED)	RT	ΓF-1	-	RTS-1	HIC-3	HIC-3	HIC-3	HIC-3	-	-	-	-	-	-	FIX-1

Please coordinate proper Ceiling Materials per CBC 1226.4.7.4 / 1224.4.11.4 and Table 1224.4.11 - Per Table 1224.4.11 Clinic Ceilings in Treatment rooms Ceiling #2 - must be smooth and easily cleanable without perforations or fissures - coordinate with Architect location of such ceiling requirements - There is a very large Treatment area and rooms.

LEGEND & ABBREVIATIONS

FINISH NOTES:

- FINISH TAG, TYPICAL.
 C.F.C.I. CONTRACTOR
 FURNISHED, CONTRACTOR INSTALLED
- FURNISHED, CONTRACTOR INSTALL
- SEE SPECIFICATIONS SECTION 09000 FOR FINISH SPECIFICATIONS.

2. A DASH (-) WITHIN A FINISH SCHEDULE CELL

- DENOTES NO FINISH REQUIRED.

 3. ALL COUNTER TOPS AND SINKS MUST MEET ALL APPLICABLE CODE REQUIREMENTS.
- FLOORING NOTES:

- FLOORING TAG, TYPICAL.
C.F.C.I. - CONTRACTOR
FURNISHED, CONTRACTOR
INSTALLED

- PATTERN FOR ROOMS WITH SINGLE FLOORING MATERIAL OMITTED FOR CLARITY. SEE FINISH SCHEDULE.
 FLOORING MATERIAL REDUCER TO BE
- SCHLUTER SCHEINE WHERE NEEDED. COLOR
 AS SPECIFIED.
 3. VINYL BACK CARPET TO HAVE CHEMICALLY
 WELDED SEAMS.
 4. ALL RESILIENT FLOORING TO BE INSTALLED
 WITH MANUFACTURER RECOMMENDED
- ADHESIVE.

 5. ADA THRESHOLD AT TOILET ROOMS TO BE SOLID SURFACE MATERIAL. SEE FINISH SPECIFICATIONS.
- 6. TILE FLOORING TRANSITIONS TO HAVE SCHLUTER ALUMINUM TRANSITION STRIPS.

FINISH AND FLOOR ABBREVIATIONS:

WALL BASE
CB CARPET BASE
CTB CERAMIC TILE BASE
PTB PORCELAIN TILE BASE
QTB QUARRY TILE BASE
RTS RUBBER TOPSET BASE
SCB SELF-COVE BASE

FLOOR
AFS ACCESS FLOOR SYSTEM
CONC SEALED CONCRETE
CPT CARPET
CT CERAMIC TILE
ERX EPOXY
LIN LINOLEUM

MAT WALK OFF MATT
PPT PORCELAIN PAVER TILE
QT QUARRY TILE
RS REDUCER STRIP
RTF RESILIENT TILE FLOORING
RUB RUBBER
SMV SEAMLESS SHEET VINYL
TER TERRAZZO

TRANSITION STRIP
VINYL COMPOSITION TILE

CEILING TRANSPARENCY

TS

TRN

WR WELDING ROD

CEILING
ACT ACOUSTICAL CEILING TILE
MC METAL CEILING
PTF PAINT FLAT FINISH
PTS PAINT SEMI-GLOSS FINISH

CORNER GUARD CHR CHAIR RAIL CR CRASH RAIL **CERAMIC TILE** CERAMIC TILE TRIM DOOR FRAME PROTECTOR **EPOXY PAINT** FABRIC WALLCOVERING **GLASS TILE** HDR HANDRAIL HIGH IMPACT WALLCOVERING PLASTIC LAMINATE MLD MOULDING MUR WALL MURAL NATURAL STONE PORCELAIN TILE PAINT EGGSHELL FINISH PAINT SEMI-GLOSS FINISH PTS PTT PORCELAIN TILE TRIM RES RESIN PANEL RESIN TILE TRIM

TB TACK BOARD
VWC VINYL WALLCOVERING

CASEWORK FINISHES:
LAM PLASTIC LAMINATE
NS NATURAL STONE
QTZ QUARTZ
SSM SOLID SURFACE MATERIAL

SOLID SURFACE MATERIAL

MISCELLANEOUS:
AW ARTWORK
BLD BLINDS
CLM COLUMN COVER

WOOD

CLM COLUMN COVER
CUB CUBICLE CURTAIN
DR DOOR
FIX LIGHT FIXTURE
FLM WINDOW FILM
FPP FOLDING OPERABLE PARTITION
LKR LOCKER
MIR MIRROR
MTL METAL
MUR MURAL

SGN SIGNAGE
SHD WINDOW TREATMENTS
SLT SLAT WALL SYSTEM
SP SHADE POCKET
SS STAINLESS STEEL
STR STAIR
TC TOILET COMPARTMENT

WATER FEATURE

NOTE: ALL MATERIALS NOTED ABOVE MAY NOT BE A PART OF THIS PROJECT.



ARCHITECT

Savely THE Healthcare Architects ARCHITECTURE + PLANNING + DESIGN

18008 Sky Park Circle, Suite 290 Irvine, CA 92614 (949) 431-0071

PROJECT

ARROWHEAD REGIONAL MEDICAL CENT


MEDICAL OFFICE BUILDING
400 N. PEPPER AVE.
COLTON, CALIFORNIA 92324

ONCOLOGY-AMBULATORY CLINIC

NO. DATE REVISIONS

O9.12.2019

PROFESSIONAL SEALS

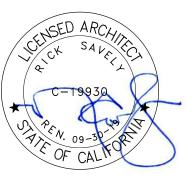

AGENCY APPROVAL

DRAWN BY CHECKED BY DATE

EED GL 02.22.2019

PROJECT NUMBER

SHEET TITLE

SHA # 18242.100

INTERIOR ROOM FINISH SCHEDULE
SHEET NUMBER

ID700

TABLE OF CONTENTS

DIVISION 1 - GENERAL REQUIREMENTS

	01 1	0 00	SUMMARY
	01 2	5 00	CONTRACT MODIFICATION PROCEDURES
	01 2	9 00	PAYMENT PROCEDURES
	01 3	1 00	PROJECT MANAGEMENT AND COORDINATION
	01 3	1 50	MECHANICAL AND ELECTRICAL COORDINATION
	01 3	2 00	CONSTRUCTION PROGRESS DOCUMENTATION
	01 3	3 00	SUBMITTAL PROCEDURES
	01 4	0 00	QUALITY REQUIREMENTS
	01 4	2 00	REFERENCES
	01 4	5 80	TESTING LABORATORY SERVICES
	01 5	0 00	TEMPORARY FACILITIES AND CONTROLS
	01 6	0 00	PRODUCT REQUIREMENTS
	01 6	4 00	DELIVERY, STORAGE AND HANDLING
	01 6	5 00	OWNER FURNISHED PRODUCTS
_	01 7	0 00	EXECUTION REQUIREMENTS
•	01 7	3 10 }	CUTTING AND PATCHING
	01 7	7 00	CLOSEOUT PROCEDURES
	01 7	8 10	PROJECT RECORD DOCUMENTS
	01 7	8 20	OPERATION AND MAINTENANCE DATA
	018	2 00	DEMONSTRATION AND TRAINING

08 71 00	DOOR HARDWARE
08 71 13	AUTOMATIC DOOR OPERATORS
08 80 00	GLAZING
08 84 13	DECORATIVE PLASTIC GLAZING
DIVISIO	N 9 - FINISHES
09 00 00	FINISH MATERIAL LEGEND
09 22 16	NON STURCTURAL METAL FRAMING
09 22 26	METAL SUPENSION SYSTEM
09 28 00	BACKING BOARD AND UNDERLAYMENT
09 29 00	GYPSUM BOARD
09 30 00	TILING
09 51 00	ACOUSTICAL PANEL CEILINGS
09 54 23	LINEAR METAL CEILINGS
09 65 13	RESILIENT WALL BASE AND ACCESSORIES
09 65 16	RESILIENT SHEET FLOORING
09 65 19	RESILIENT TILE FLOORING
09 68 16	SHEET CARPETING
09 81 00 }	ACOUSTICAL INSULATION
09 91 00	PAINTING
DIMIGIO	N 10 SDECIALTIES

DIVISION 10 - SPECIALTIES

10 11 23	TACKBOARDS
10 14 00	SIGNAGE
10 21 23	CUBICLE CURTAINS AND TRACK
10 26 23	WALL AND CORNER PROTECTION

ARROWHEAD REGIONAL MEDICAL CENTER ONCOLOGY/INFUSION THERAPY CLINIC REMODEL SHA PROJECT NUMBER 18242.100

10 28 13 TOILET ACCESSORIES

10 44 00 FIRE PROTECTION SPECIALTIES

(10 50 60 PLASTIC LAMINATE FACED WOOD LOCKERS 1

DIVISION 11 - EQUIPMENT

Not Used

DIVISION 12 - FURNISHINGS

Window treatments to match building standard

DIVISION 13 - SPECIAL CONSTRUCTION

Not used

DIVISION 14 - CONVEYING SYSTEMS

Not Used

DIVISION 21 – FIRE PROTECTION

21 05 02 BASIC FIRE SUPRESSION REQUIREMENTS

21 06 02 BASIC FIRE SUPPRESSION MATERIALS AND METHODS

21 13 00 FIRE SUPPRESSION SYSTEMS

DIVISION 22 - PLUMBING

22 05 02	BASIC PLUMBING REQUIREMENTS
22 05 03	BASIC PLUMBING MATERIALS AND METHODS
22 05 23	GENERAL DUTY VALVES FOR PLUMBING PIPING
22 05 29	HANGERS AND SUPPORTS FOR PLUMBING PIPING
22 05 53	PLUMBING IDENTIFICATION
22 07 00	PLUMBING INSULATION
22 10 00	PLUMBING PIPING

TABLE OF CONTENTS - 4

SECTION 01 65 00

OWNER FURNISHED PRODUCTS

PART 1 - GENERAL

1.1 RELATED DOCUMENTS

- A. Drawings and general provisions of the GMAX Agreement, including Supplementary Conditions and Division 1 Specification Sections apply to this Section.
- B. Medical Equipment Specifications, Project Manual Volumes 6 through 9.
- C. Related Sections:
 - 1. Refer to Section 09 11 00 Non-Load Bearing Metal Framing

1.2 SUMMARY

- A. Work Includes: Furnish all labor, materials, equipment, appliances and necessary incidentals for the complete installation of all Owner furnished products as shown on the Drawings and as specified herein.
- B. This Section describes the requirements for furnishing and installing Owner furnished equipment, and providing miscellaneous items and accessories for a complete, functioning installation.
- C. This Section describes certain terms and abbreviations utilized in the Contract Documents.

1.3 PRODUCT HANDLING

- A. Protection: Use necessary means and methods to protect the materials of this Section before, during, and after installation. Protect the installed Work and materials of other trades and equipment installed by others.
- B. Replacements: In the event of damage, immediately repair all damaged and defective work to the approval of the Architect, at no additional cost to the Owner.

PART 2 - PRODUCTS

2.1 GENERAL

- A. Refer to the Contract Documents.
 - 1. Verify mounting and utility requirements for accepted equipment items.
 - 2. Provide mounting and utility rough-ins for equipment items required regardless of equipment responsibility.
 - a. Rough-in locations, sizes, capacities and similar type shall be as indicated and required by produce manufacturers.

ARROWHEAD REGIONAL MEDICAL CENTER ONCOLOGY/INFUSION THERAPY CLINIC REMODEL SHA PROJECT NUMBER 18242.100


- b. If the Owner substitutes items similar to those scheduled there shall be no change in rough-in cost, unless substitution occurs after rough-in has been completed or rough-in involves other mounting requirements, utilities of different capacity than those required by item originally specified.
- 3. For items designated to be Owner or Vendor Furnished: The Owner or Vendor will furnish manufacturer's literature or information, shop drawings, or appropriate information for preparing required shop drawings.
- B. Approved manufacturer's printed descriptions, specifications and recommendations shall govern the Work, unless specifically indicated otherwise.
- C. Specifications, standards, tests and recommended methods cited in this Section to govern use of items of equipment shall also govern item's component parts.
- D. Mechanical and plumbing work shall comply with governing Codes and standards and requirements of Division 15 Mechanical.
- E. Electrical work shall comply with governing Codes and standards and applicable requirements of Division 16 Electrical.

2.2 RESPONSIBILITY REQUIREMENTS:

- A. Refer to the Contract Documents.
- B. Responsibility for equipment installation:
 - 1. Furnished by the Contractor; installed by the Contractor.
 - a. General: Refer to equipment items specified in other Sections for additional information.
 - b. Provide and install backing for all items which weigh 20 pounds or more. Refer to Section 09110 Non-Load Bearing Metal Framing and the Drawings.
 - 2. Furnished by the Owner; installed by the Contractor.
 - a. General: The Contractor shall coordinate delivery of Owner furnished equipment. The Owner will furnish equipment to coincide with the construction schedule.
 - b. The Owner will:
 - 1) Furnish standard integral parts of equipment.
 - 2) Deliver items to site.
 - c. The Contractor will:
 - Receive items at site and give written receipt for item at time of delivery, noting visible defects and omissions; if such declaration is not given, the Contractor shall assume responsibility for such defects and omissions.
 - 2) Store items until ready for installation and protect from loss and damage.

ARROWHEAD REGIONAL MEDICAL CENTER ONCOLOGY/INFUSION THERAPY CLINIC REMODEL SHA PROJECT NUMBER 18242.100

- b. Heavy drawers, full extension, 150 lb. capacity: Accuride AC4034 Series.
- Shallow drawers, full extension, low profile, 45 lb. capacity: Accuride 2006 undercounter slides
- d. File drawers, full extension, 150 lb. capacity: Accuride C4034
- 4. Retracting door hardware: Accuride Anti-Rak Flipper Door Slides, vertical retracting slide with hinge carrier strip and extra hinge; one hinge per foot of door height.

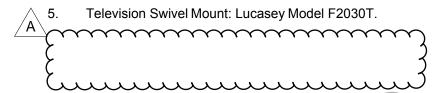

- 8. Door and drawer pulls: Wire rod type, satin chrome plated steel, 4-inch centers, Stanley SH4484-26D, or approved equivalent.
- 9. Drawer stops: Provide stops to prevent drawer fronts from hitting face of cabinet body.
- 10. Sliding door slides: KV2412.
- 11. Sliding door pulls: Grant 428.
- 12. File folder supports: As suitable for Pendaflex file folders, chrome plated.
- 13. Cabinet drawer/door locks: National C8123 or Corbin 0737, pin tumbler operation, rekeyable and capable of being masterkeyed. Wafer tumbler locks will not be acceptable.
 - a. Provide locks at drawers, single doors and on active leaf of paired doors, as indicated on the Drawings.
 - b. Provide 2 keys for each lock.
 - c. Coordinate locks and latches specified below. At pairs of doors, active leaf shall have lock and inactive leaf shall have elbow catch.
 - d. Keying: Assist Construction Manager and Owner with developing a key schedule for drawer locks when shop drawings are reviewed. Coordinate with keying requirements specified in Section 08710 Door Hardware.
 - e. Keying groups: Interior elevations in the Drawings indicate the following keying groups for reference only. Unless otherwise directed by Owner through Construction Manager, these groups shall be used:
- 14. Elbow catches: Ives 2F15. Coordinate locks and latches specified below. At pairs of doors, active leaf shall have lock and inactive leaf shall have elbow catch.
- 15. Magnetic catches: Provide magnetic catches at all doors with locks and all doors without elbow catches, EPCO 1001 or equivalent.

ARROWHEAD REGIONAL MEDICAL CENTER ONCOLOGY/INFUSION THERAPY CLINIC REMODEL SHA PROJECT NUMBER 18242.100

SECTION 09 00 00 FINISH MATERIAL LEGEND (Partial List)

PART 1 GENERAL

1.1 SUMMARY

A. Section includes: Finish material/colors legend

1.2 MANUFACTURED CASEWORK

A. Plastic Laminate Faced Casework (SECTION 06 41 00 - ARCHITECTURAL WOOD

CABINETS)

LAM-1 Manufacturer: Wilsonart/EB Bradley

Contact: Eileen Capelle (323) 559-3070

Pattern: Brazilwood Color: 7946-38

Finish: Fine Velvet Finish

Location: Reception, Nurse Station casework, Door Stain Note: Provide fire-rated substrate and adhesive to maintain or obtain Class A fire rating where

required by Code. Provide radius-exposed outside

edges at countertop.

LAM-2 Manufacturer: Wilsonart/EB Bradley

Contact: Eileen Capelle (323) 559-3070

Pattern: Beigewood 7850-60 Finish: Matte

Location: Reception, Nurse Station casework, Door Stain Note: Provide fire-rated substrate and adhesive to maintain or obtain Class A fire rating where

required by Code. Provide radius-exposed outside

edges at countertop.

LAM-3 Manufacturer: Formica

Contact: Linda Beran (562) 714-6061

Pattern: 464-58 Color: Gray Stone Finish: Matte

Location: Toilet Room Plumbing Apron

Note: Provide fire-rated substrate and adhesive to

maintain or obtain Class A fire rating where

required by Code. Provide radius-exposed outside

edges at countertop.

B. Solid Surface Material (SECTION 06 60 00 - PLASTIC FABRICATIONS)

SSM-1 Manufacturer: Hi Macs

Contact: Mitch Sebolsky (310) 910-5179

Pattern: T001 Venus Color: Pause

Pinish Polished Size: 0.75"Thick Top

FINISH MATERIAL LEGEND 09 00 00 - 1

ARROWHEAD REGIONAL MEDICAL CENTER ONCOLOGY/INFUSION THERAPY CLINIC REMODEL SHA PROJECT NUMBER 18242.100

Style: HH6-LED Architectural Downlight

Size: 6"Diam.

Lamping: LED

Location: Toilet Room

Note: UL Listed

FIX-5 Manufacturer: Philips Day-Brite

Contact: (866) 502-5526

Style: Alkco - Little Inch HP100/200 Series

Finish: Matte White

Size: 5"W x 1.125"H x Length varies per casework condition

Lamping: Per Electrical Engineer
Location: Under-Cabinet Task Light

Note: UL Listed, to be pigtailed with individual and override

control.

FIX-6 Manufacturer: Bruck

Contact: Performance Lighting Systems (800) 382-3055

Style: Ciro

Finish: 119 White Diffuser with Matte Chrome Trim

Size: 8.75" x 3.625"

Lamping: LED

Location: Nurse Station Note: UL Listed.

Mounting height 6' 6" A.F.F. (bottom of Fixture)

FIX-7 Manufacturer: Focal Point

Contact: Michael Shearer (949) 294-6983

Style: Seem 4 Recessed
Finish: White with Acrylic Lens
Trim: Trimless Flange at MC-1

Trim Flange at 9/16" Grid Ceiling

Lamping: LED, 3500K

Size: 4"W

Location: Per Reflected Ceiling Plan

Note: Listed ...

B. Window Treatment

SHD-1 Manufacturer: Mecho Shade / Architype
Contact: Pamela Adams (213) 631-5001

Pattern: Thermoveil Reversible Series 3000, 3200, 3300

Color: 3011 Parchment 1-2% Location: Exterior Windows

Note: Continuous Clutch system; (1) Shade per window.

module:

Inside mounting bracket inside window mullion.

Mirrors (SECTION 1028/13-TOILET ACCESSORIES)

MIR-1 Manufacturer: ASI or Equal Contact: (914) 476-9000


Pattern: Frameless Rectangular Mirror with 1" Beveled Edge

Size: 0.25" Polished Plate Glass

Location: Toilet Room

Note: Meets ASTM C 1036-91

ARROWHEAD REGIONAL MEDICAL CENTER ONCOLOGY/INFUSION THERAPY CLINIC REMODEL **SHA PROJECT NUMBER 18242.100**

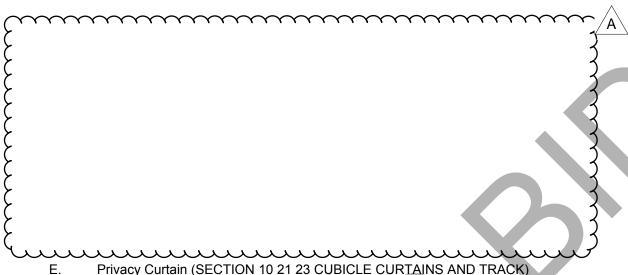

Privacy Curtain (SECTION 10 21 23 CUBICLE CURTAINS AND TRACK)

CUB-1 Manufacturer: Architex

Contact: (800) 621-0827

Pattern: **RX1006** Color: Equilibrium Size: 72"W

29.5"V, 9.25"H Repeat: 100% Trevira CS Content:

Arc Com, Super Mesh, Color: Natural Beige Mesh:

Location: Infusion Bays

Note: `18" Integral Mesh and Grommets 6" O.C. Must comply Note:

with Fire Marshall requirements.

